



HEADWALL ELEVATION FOR MM 117.72

SCALE 3/4" = 1'-0"

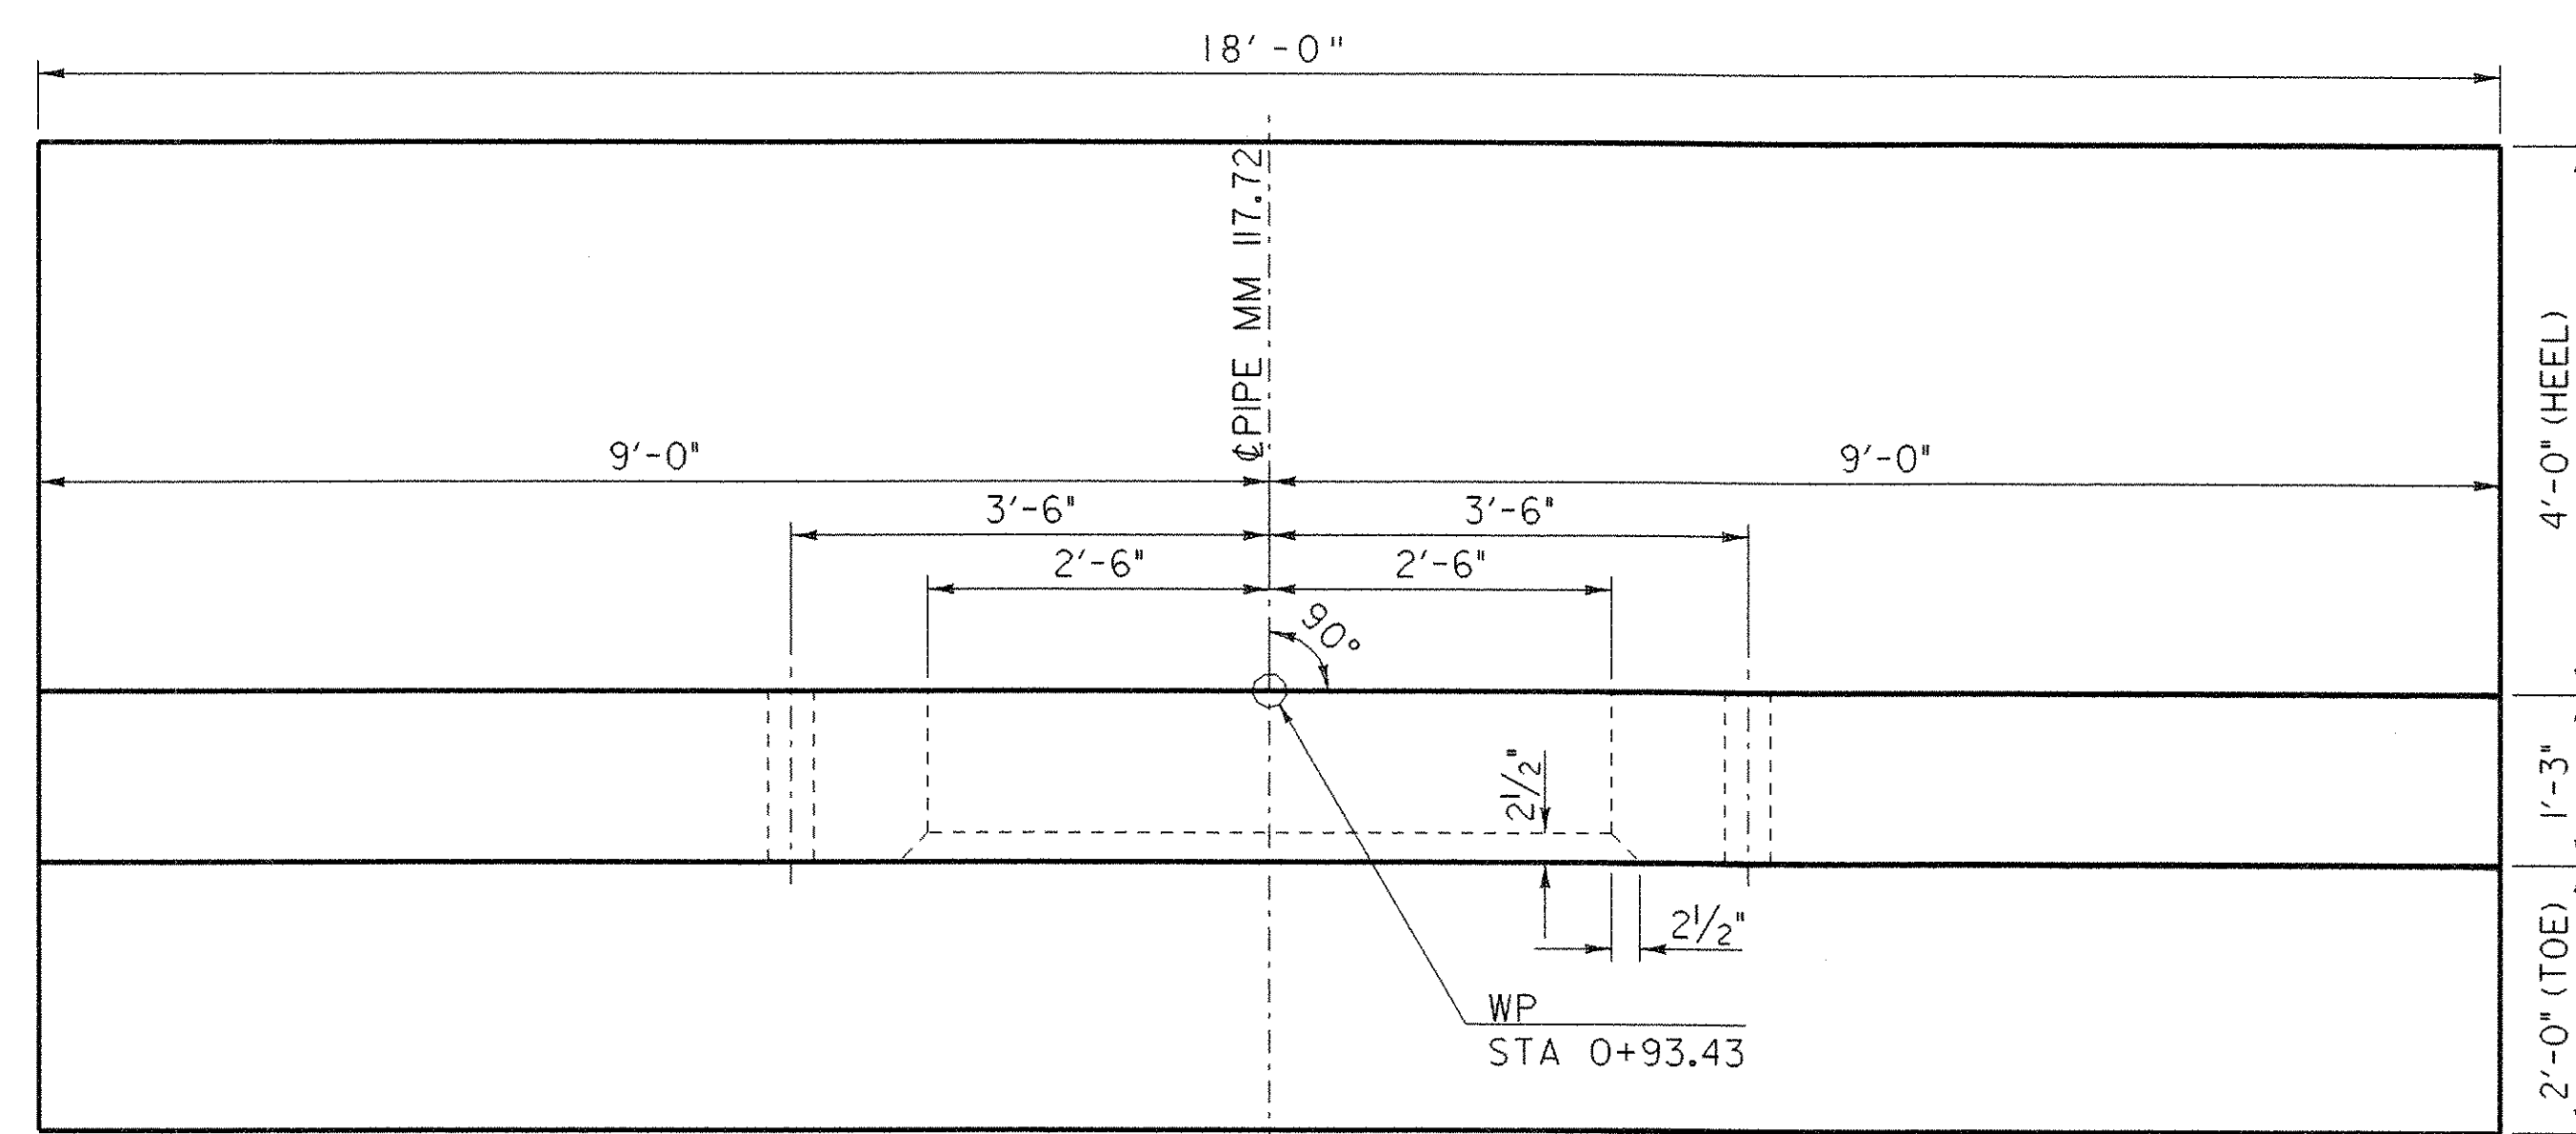

HEADWALL PLAN FOR MM 117.72

SCALE 3/4" = 1'-0"

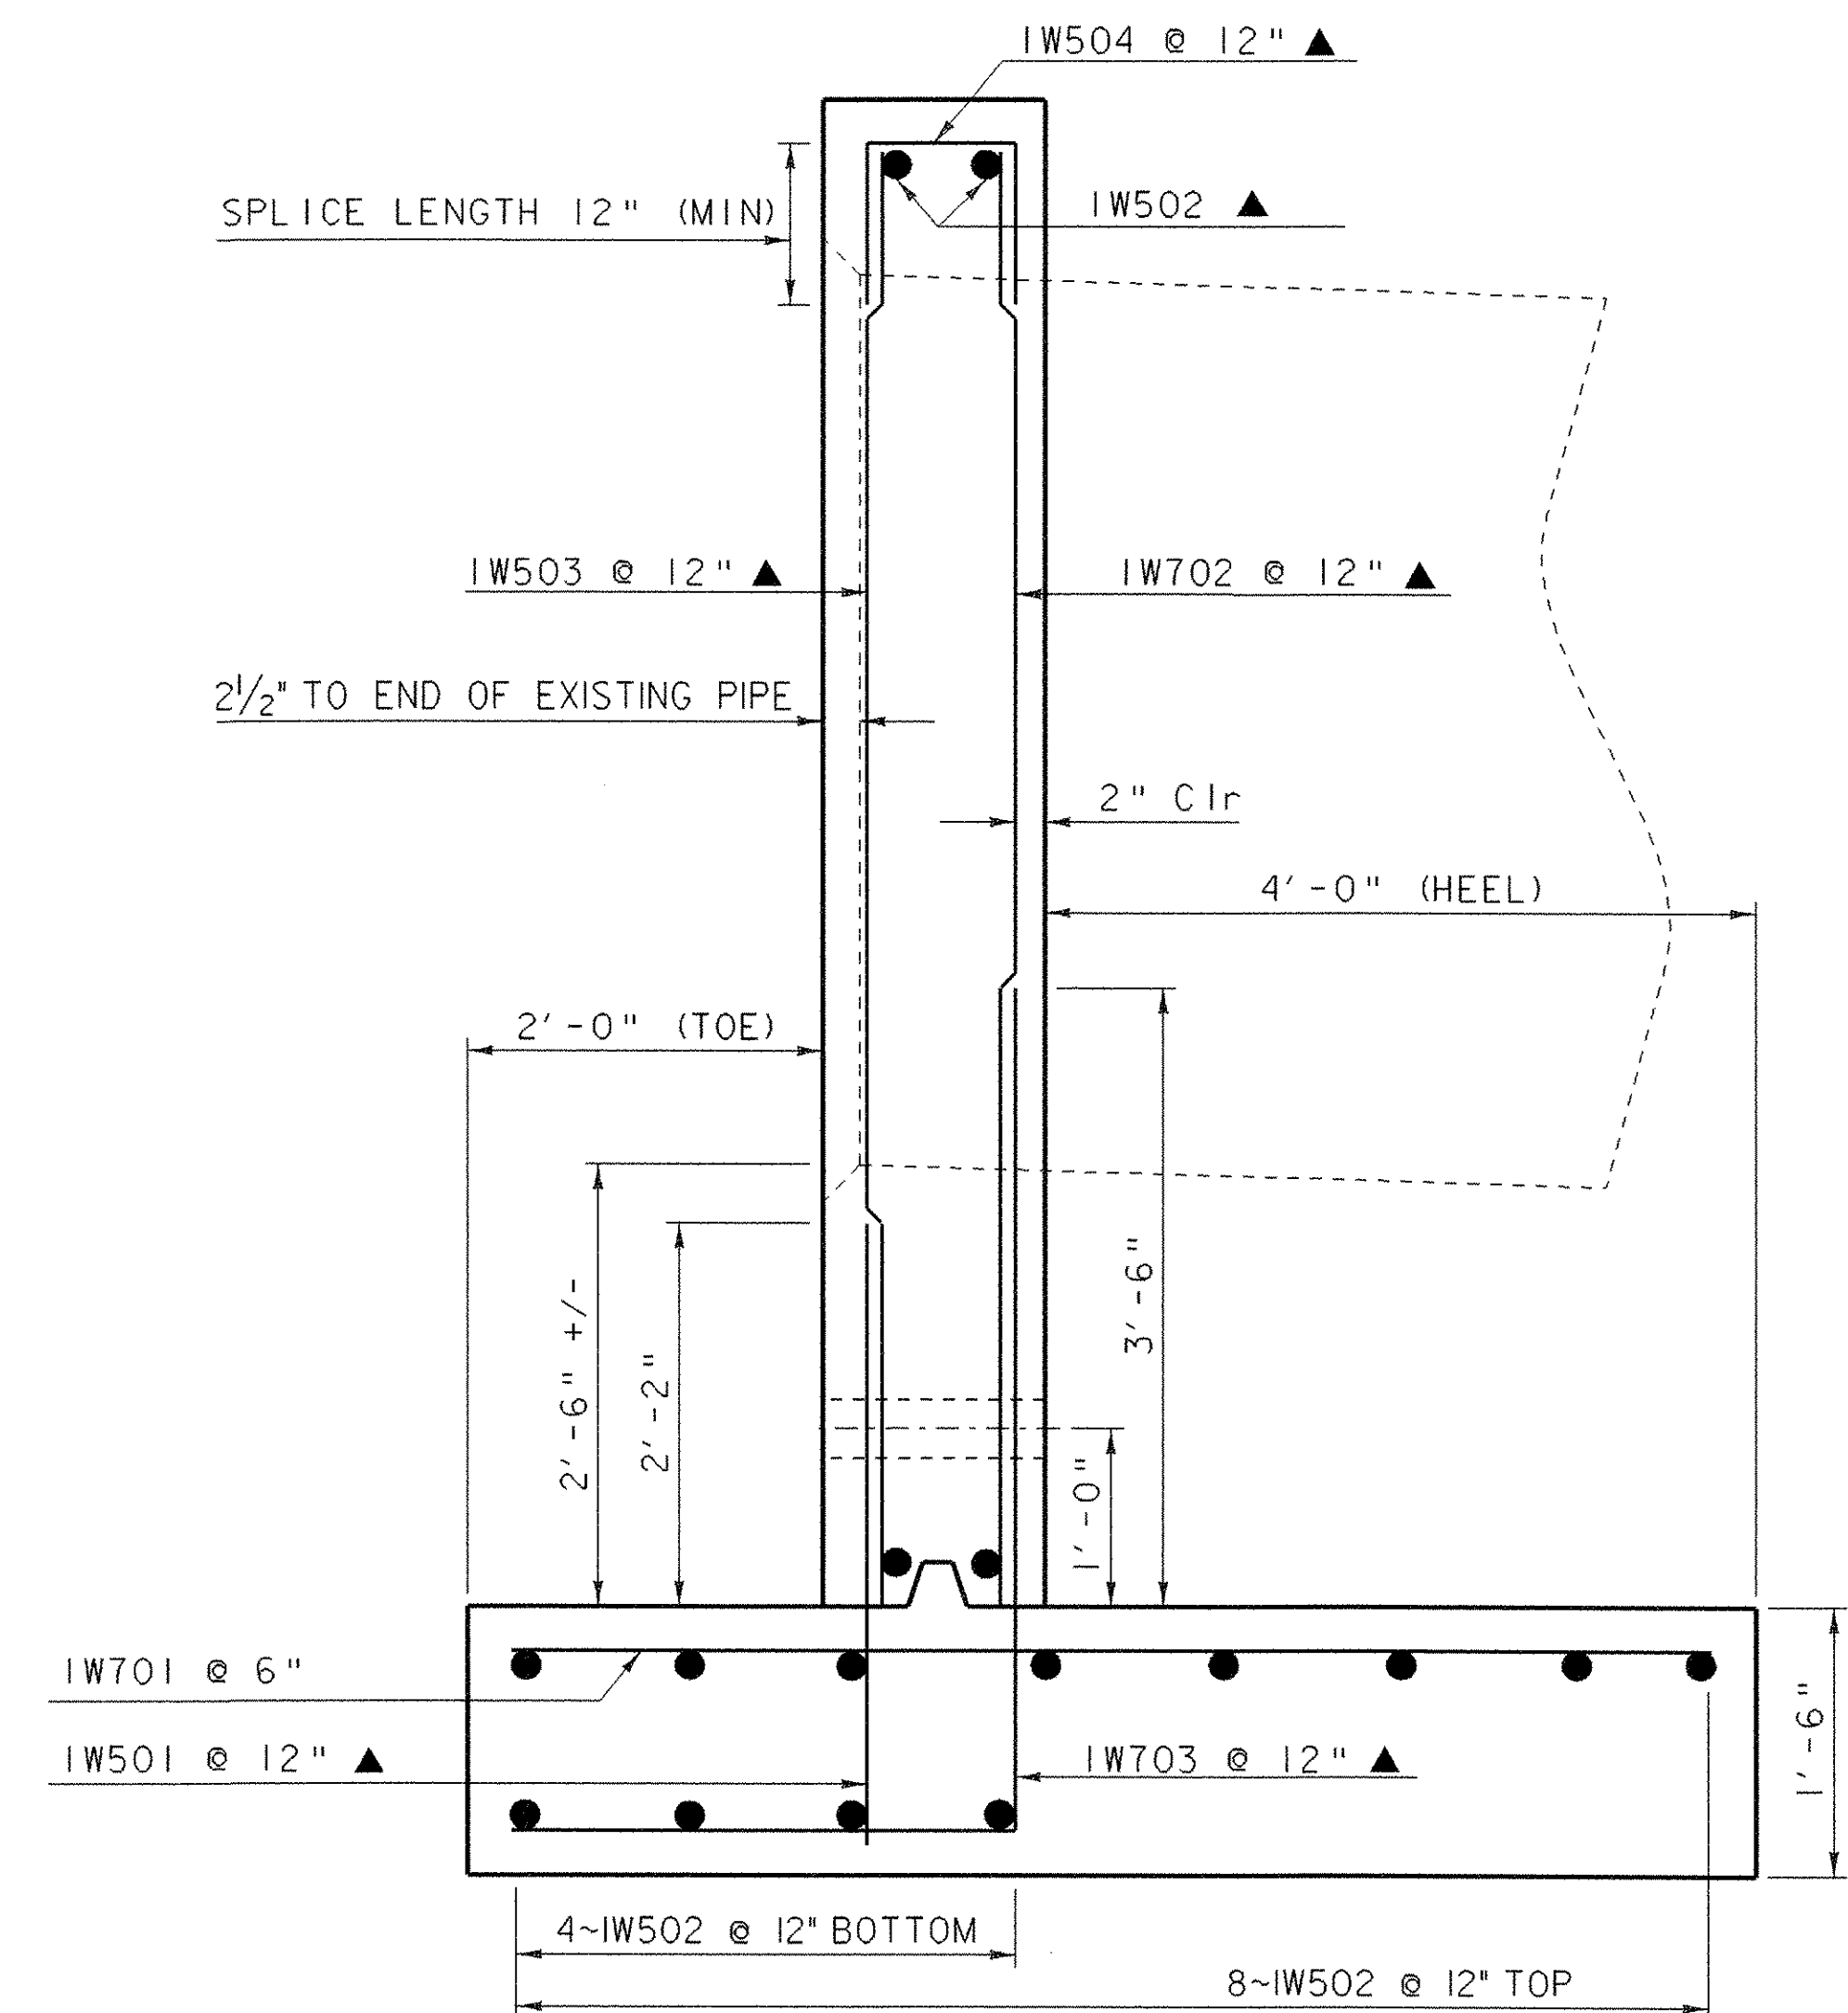

HEADWALL SECTION FOR MM 117.72

SCALE 1" = 1'-0"

**NOTE:**

NF = NEAR FACE  
 FF = FAR FACE  
 EF = EACH FACE  
 ▲ = CUT TO FIT IN FIELD  
 3" CLR. UNLESS OTHERWISE SPECIFIED ON THE PLANS.

PROJECT NAME: BARNET	PLOT DATE: 25-FEB-2008
PROJECT NUMBER: IM SCR(2)	DRAWN BY: R. FOSTER
FILE NAME: d07a102headwall.dgn	CHECKED BY: W. SYMONDS
PROJECT LEADER: K. UPMAL	SHEET 11 OF 20
DESIGNED BY: R. FOSTER	
MM 117.72 HEADWALL DETAILS	