 
 
 
 
 
 
 
 

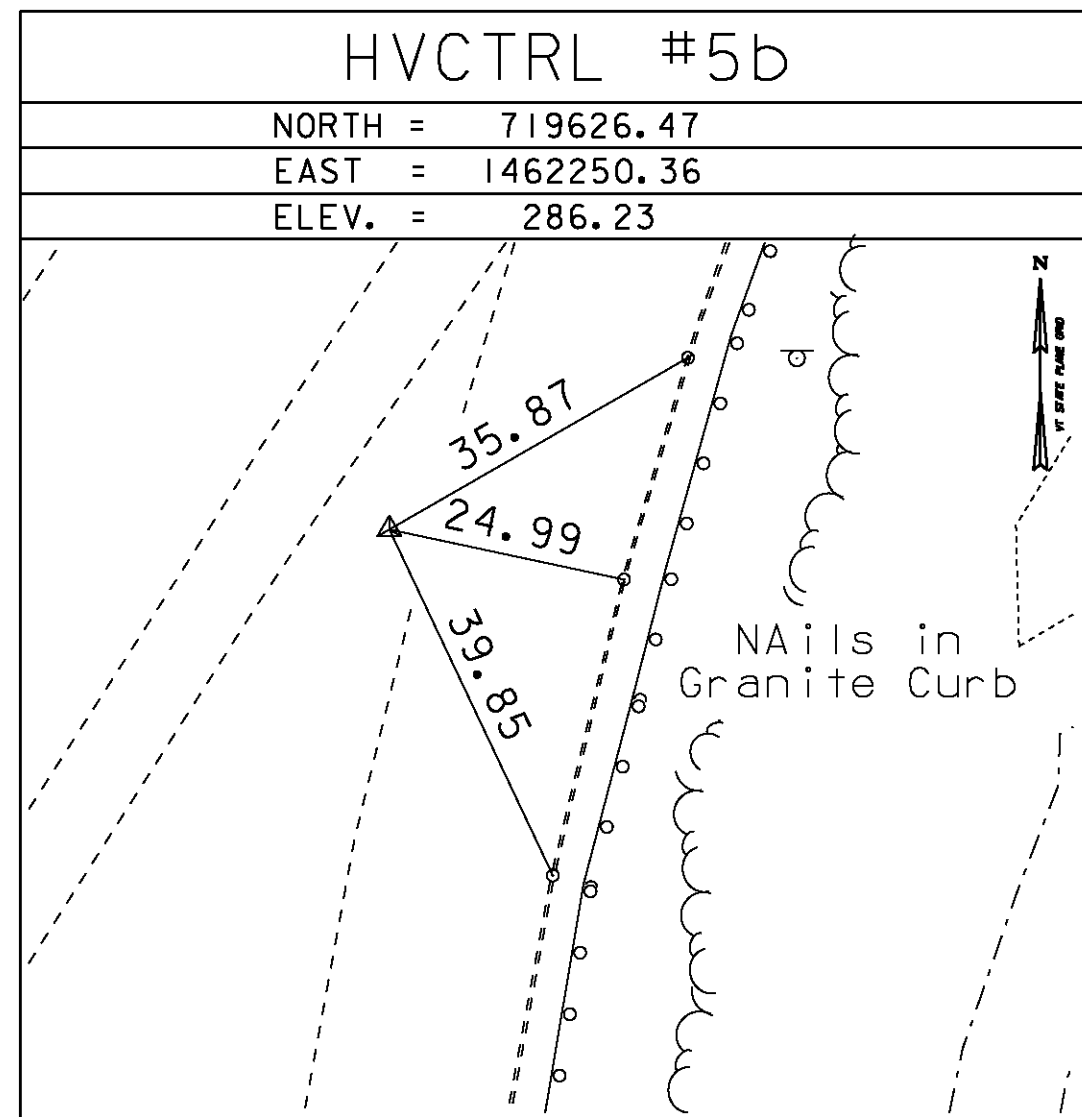


GPS CONTROL POINTS

TRAVERSE TIES

ALIGNMENT TIES

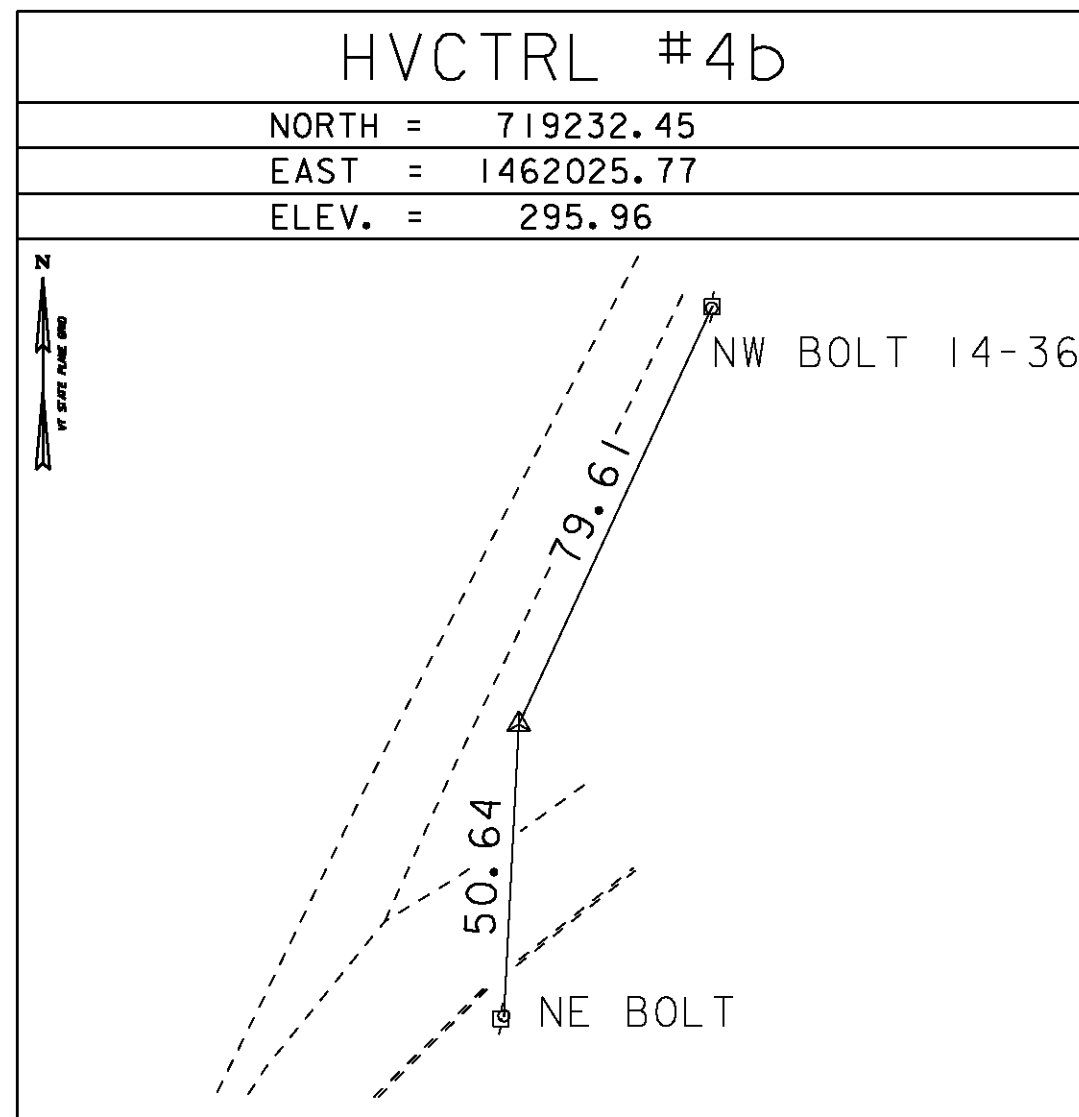

x07a104b

DATUM	
VERTICAL	NAVD 88
HORIZONTAL	NAD 83(96)
ADJUSTMENT	Compass

PROJECT NAME:	SOUTH BURLINGTON
PROJECT NUMBER:	SCRP (3)
FILE NAME:	d107a104_+1.dgn
PROJECT LEADER:	K. UPMAL
DESIGNED BY:	B. MCADAMS
TIE SHEET	2
PLOT DATE:	13-JAN-2010
DRAWN BY:	R. BULLOCK
CHECKED BY:	B. KIPP
SHEET	5 OF 69