




0+50

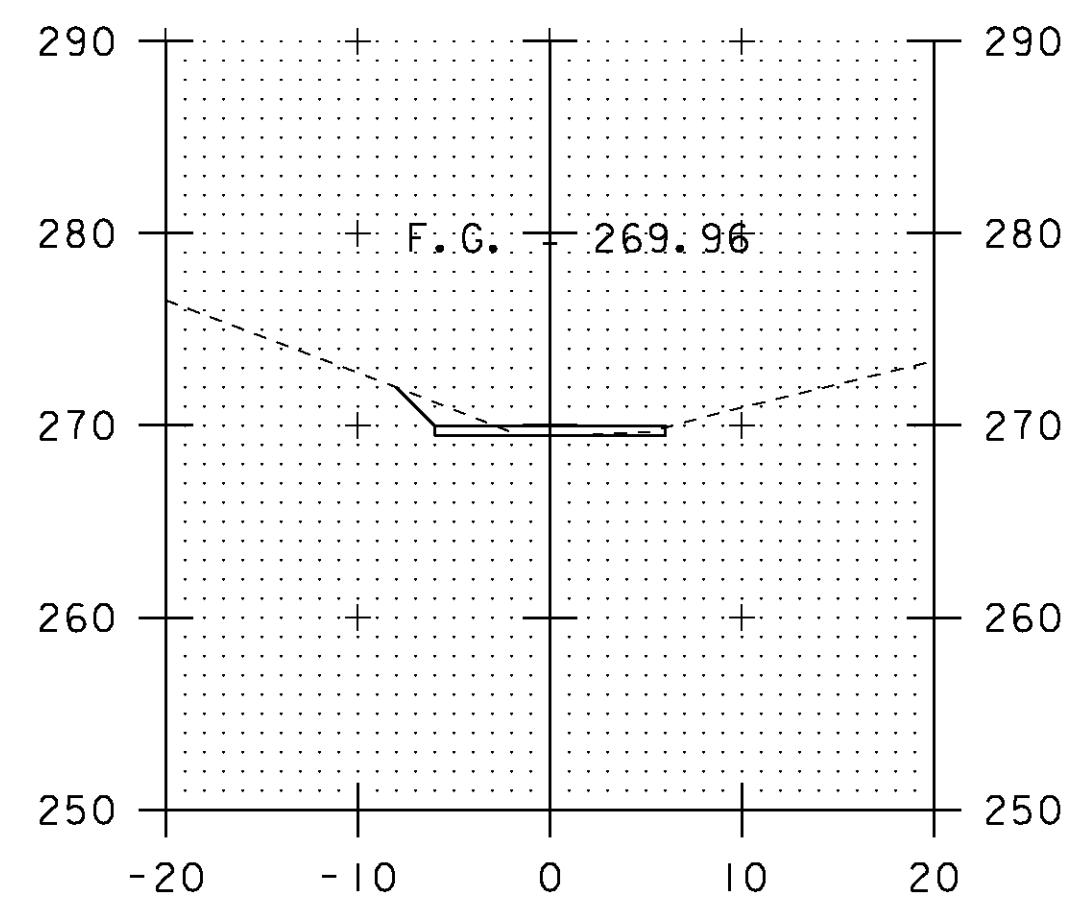


1+25

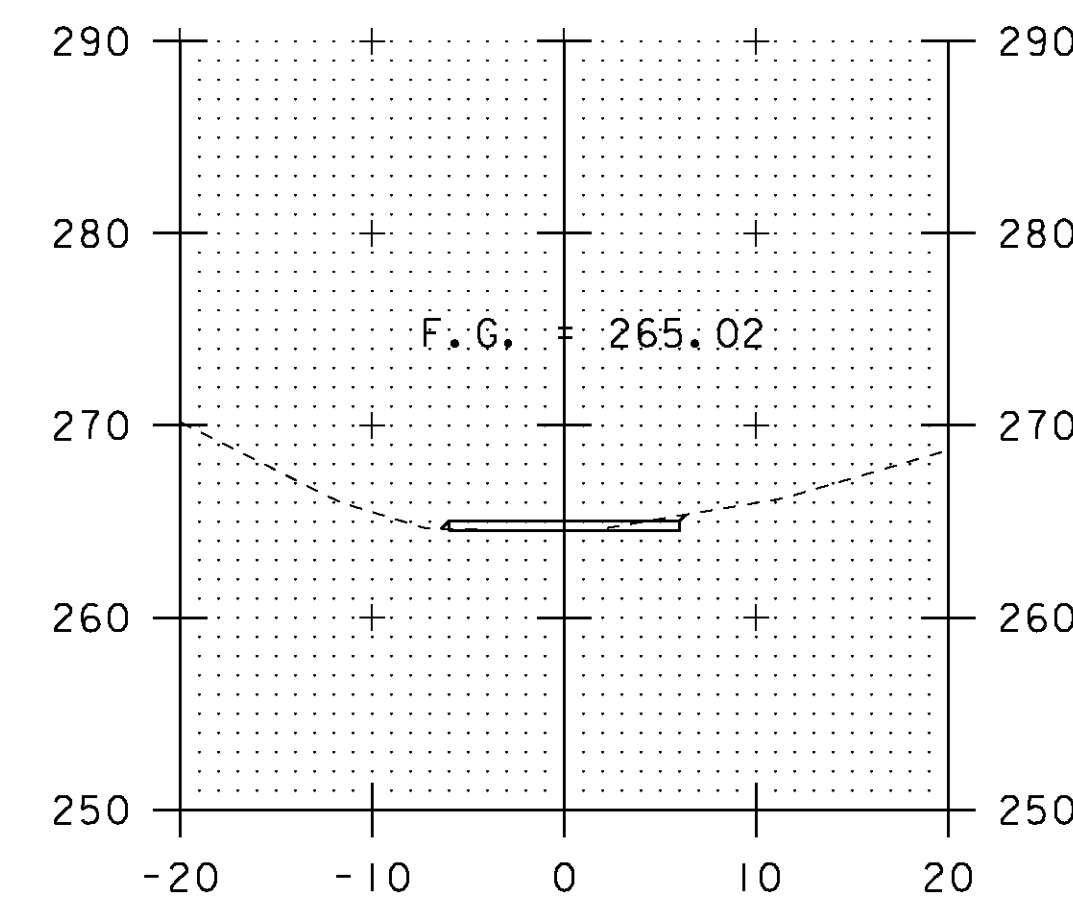


1+83

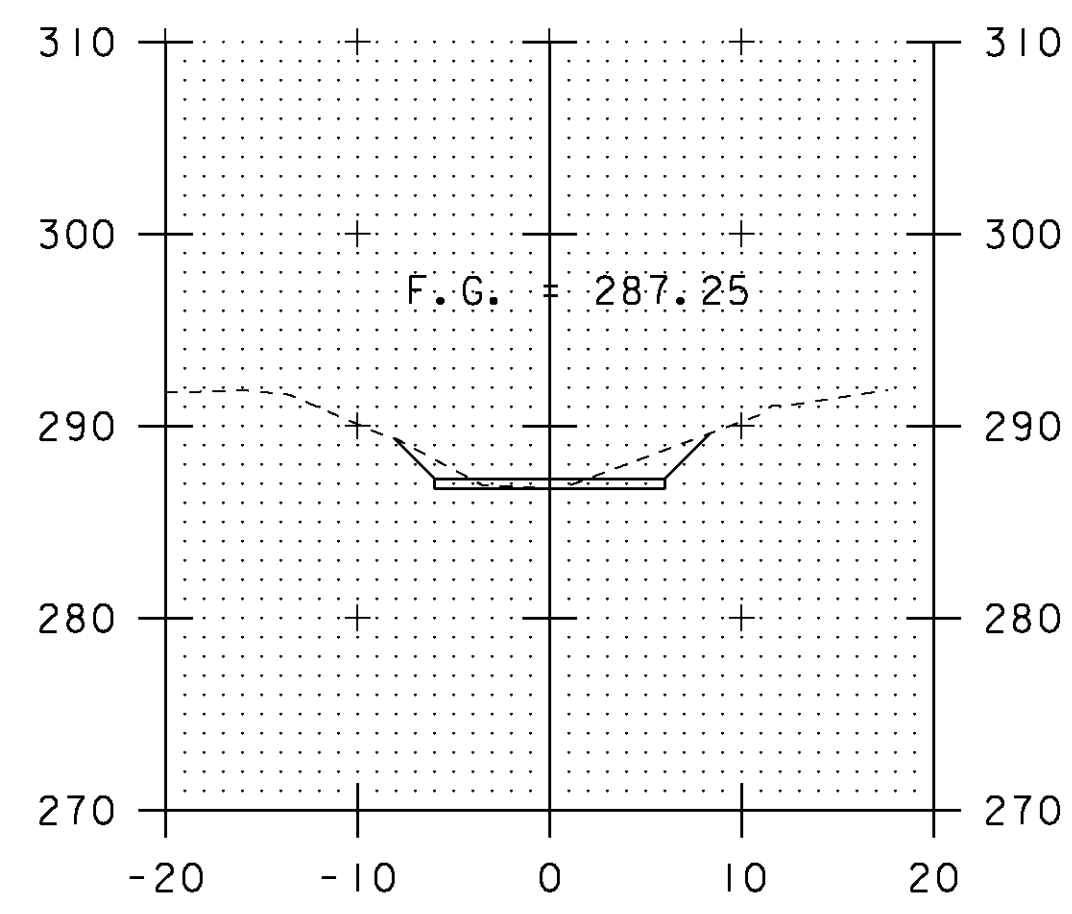


0+25

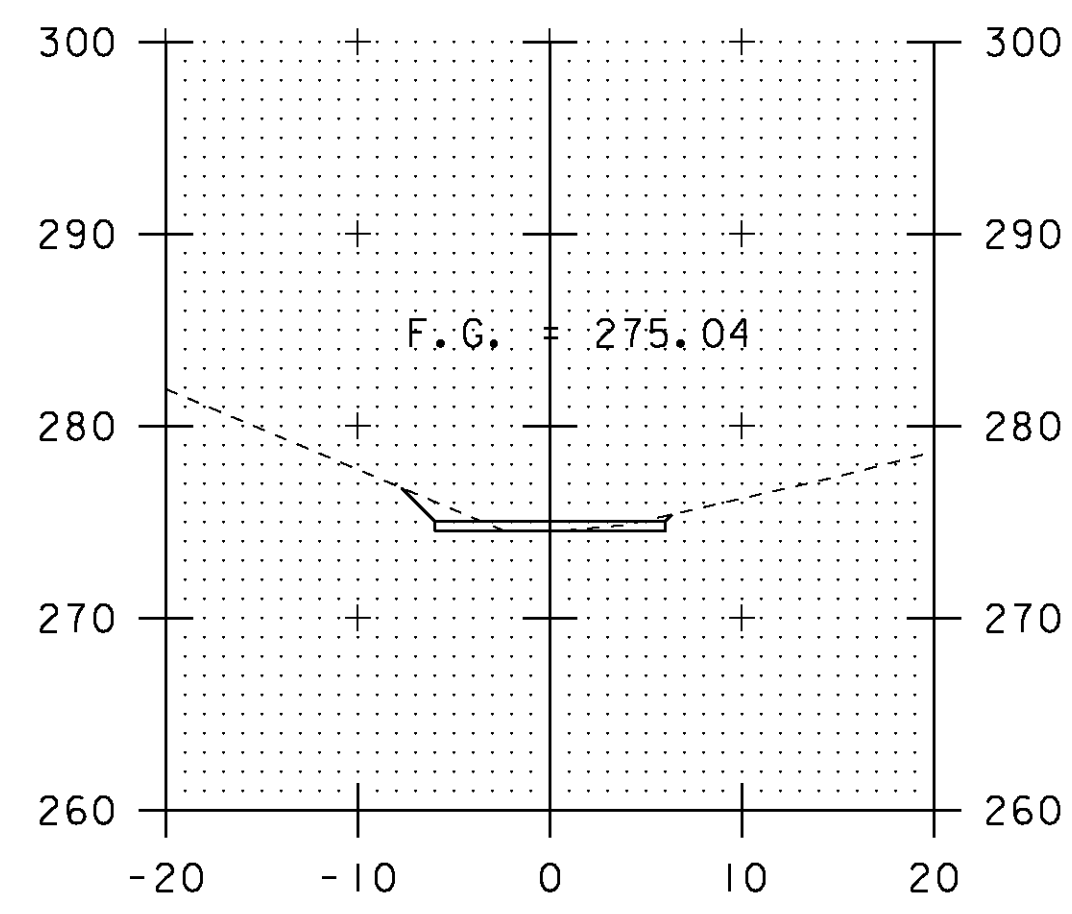


1+00

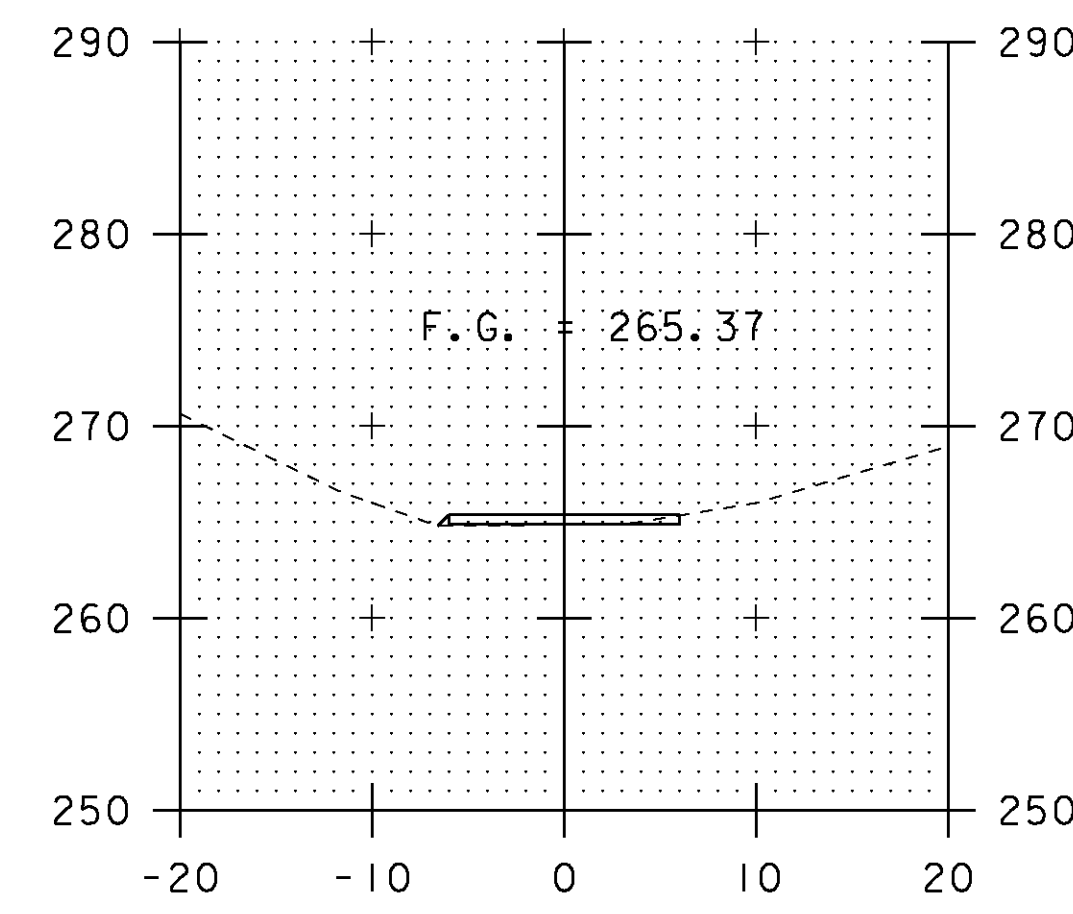


1+75

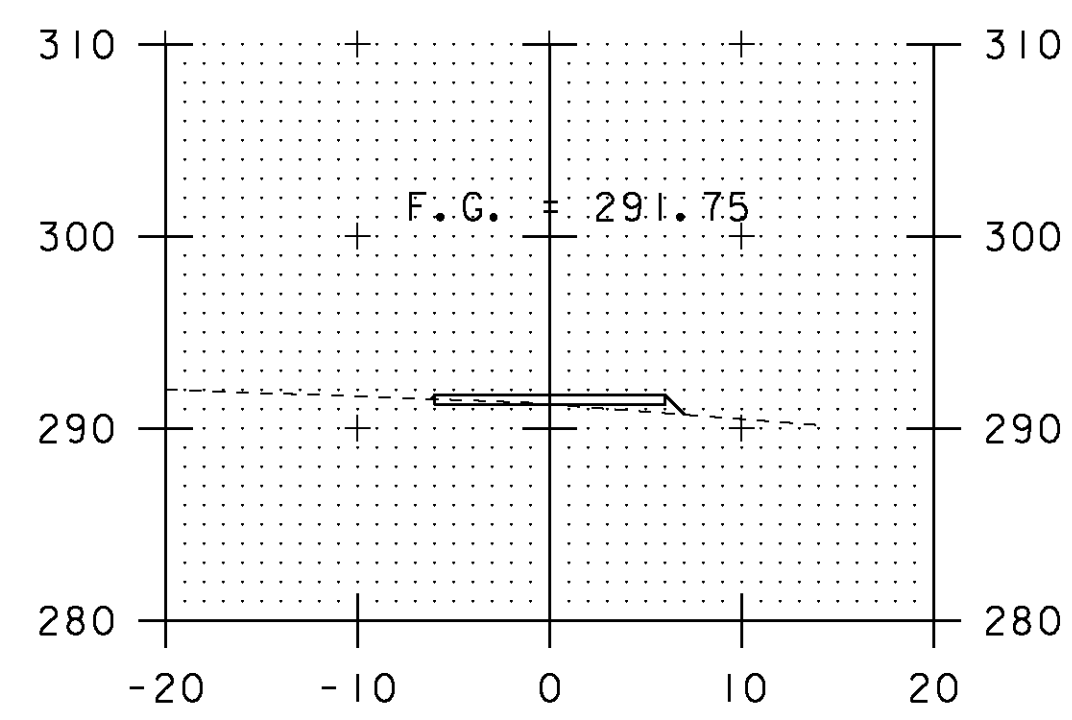

0+00

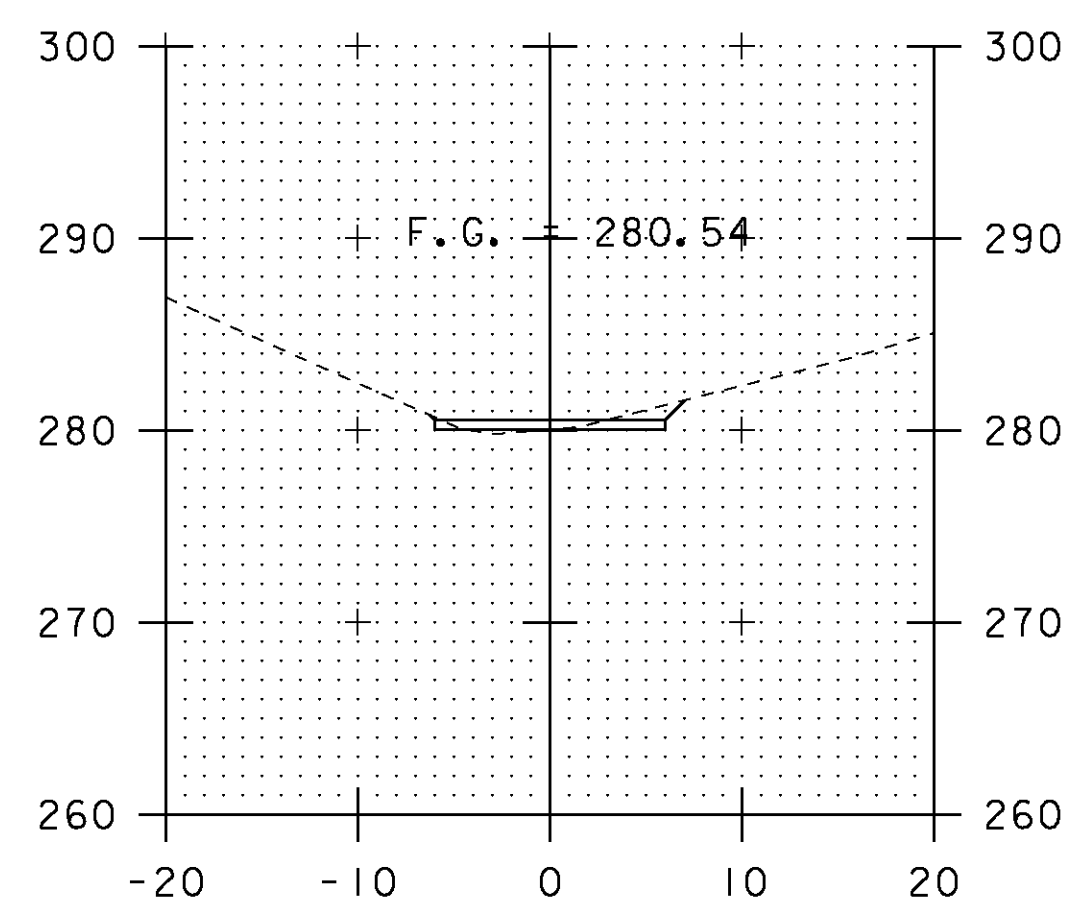


0+75

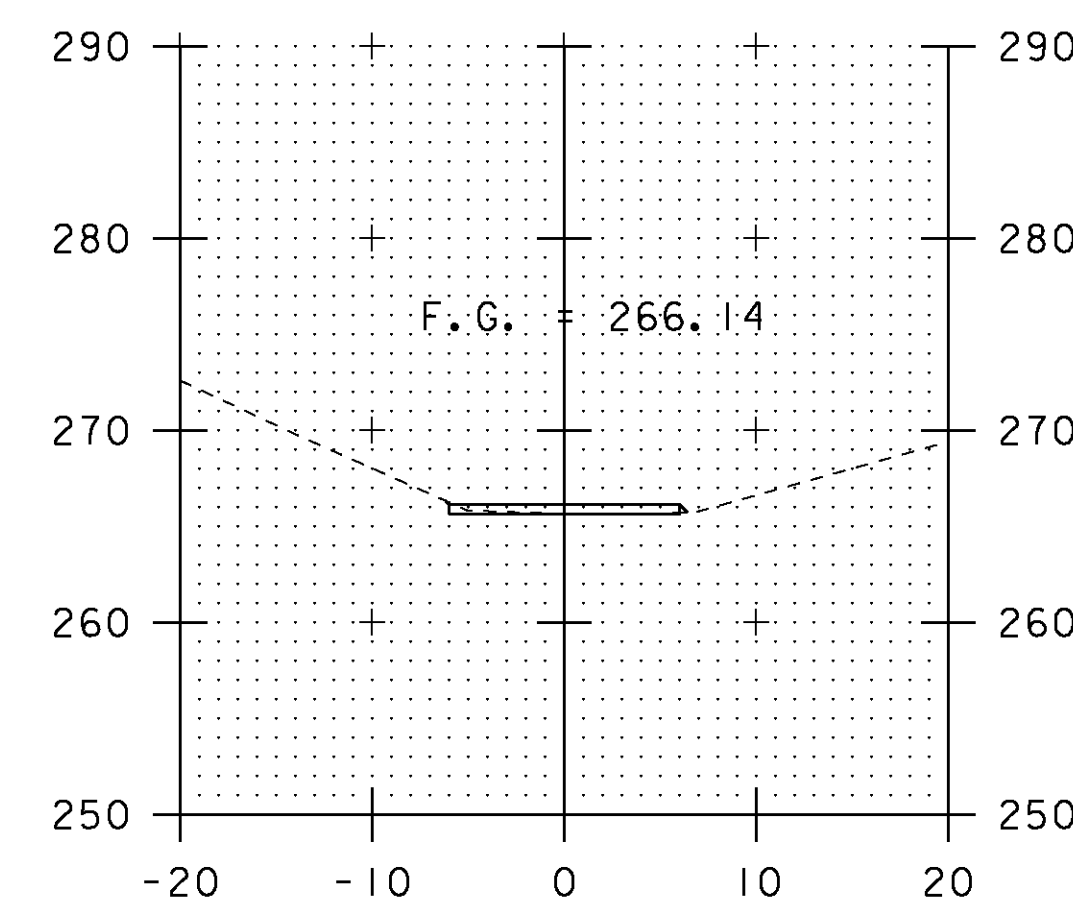

1+50

STA. 0+00 TO STA. 1+83

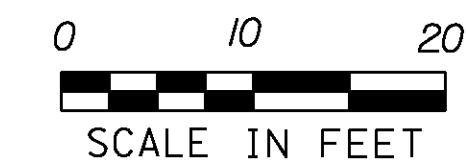

PROJECT NAME: SOUTH BURLINGTON	
PROJECT NUMBER: IM SCRP(3)	
FILE NAME: d07a104_nul.dgn	PLOT DATE: 13-JAN-2010
PROJECT LEADER: K. UPMAL	DRAWN BY: B. McADAMS
DESIGNED BY: B. KIPP/B. McADAMS	CHECKED BY: B. KIPP
ACCESS ROAD CROSS SECTIONS	SHEET 10 OF 69