




1+00

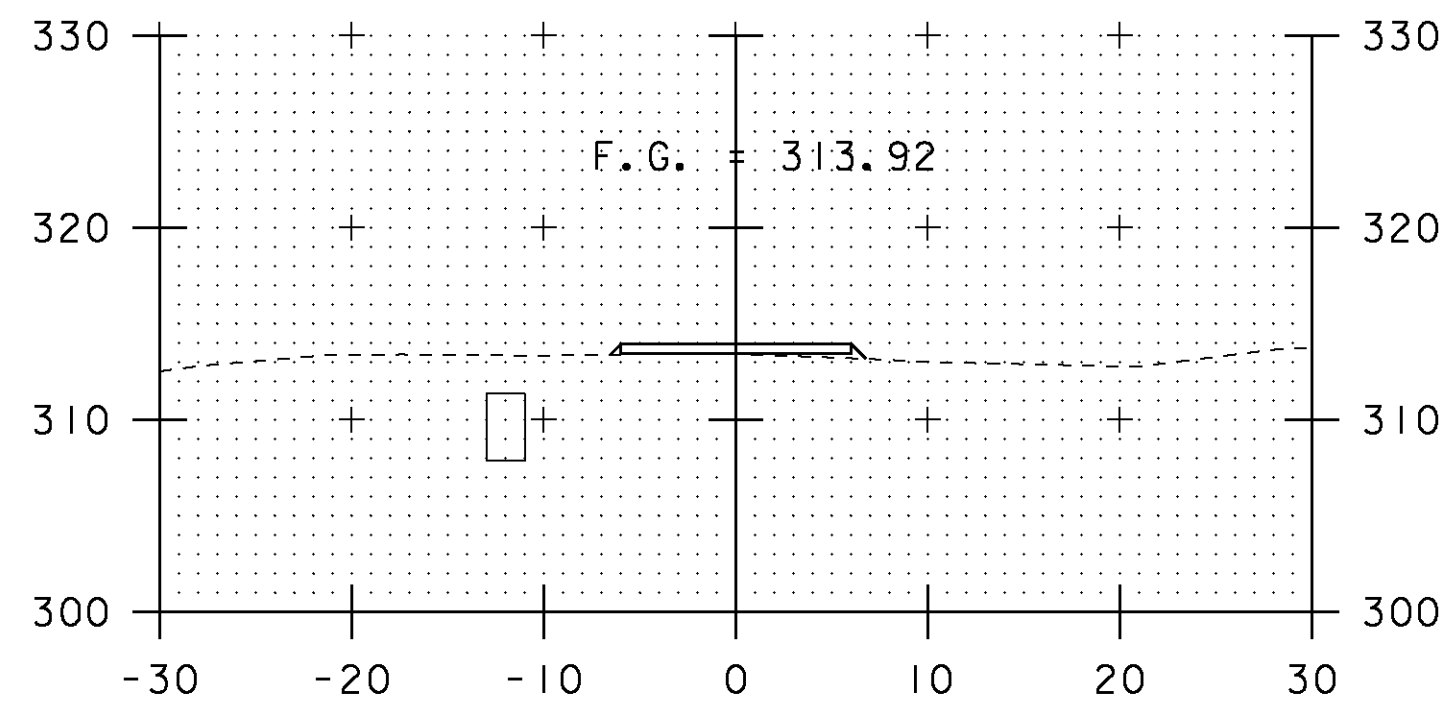


2+50

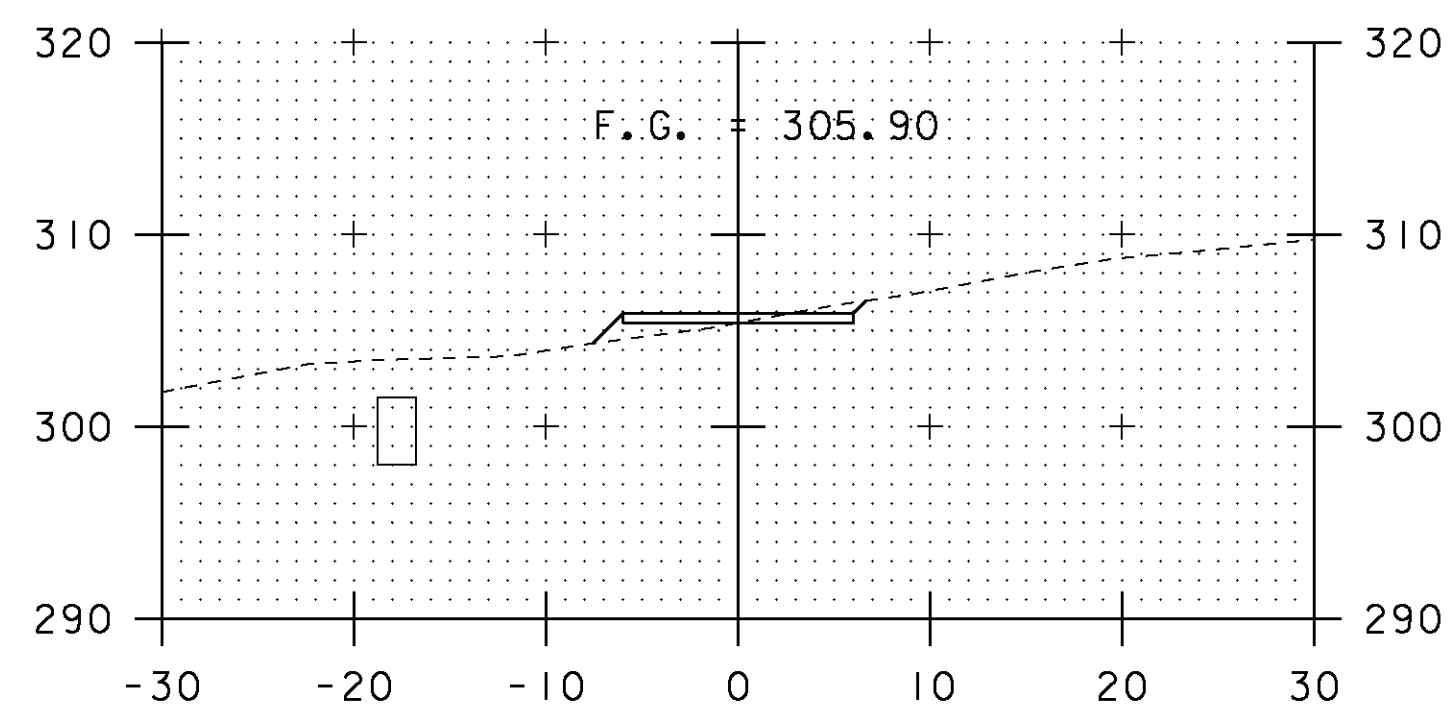


4+00

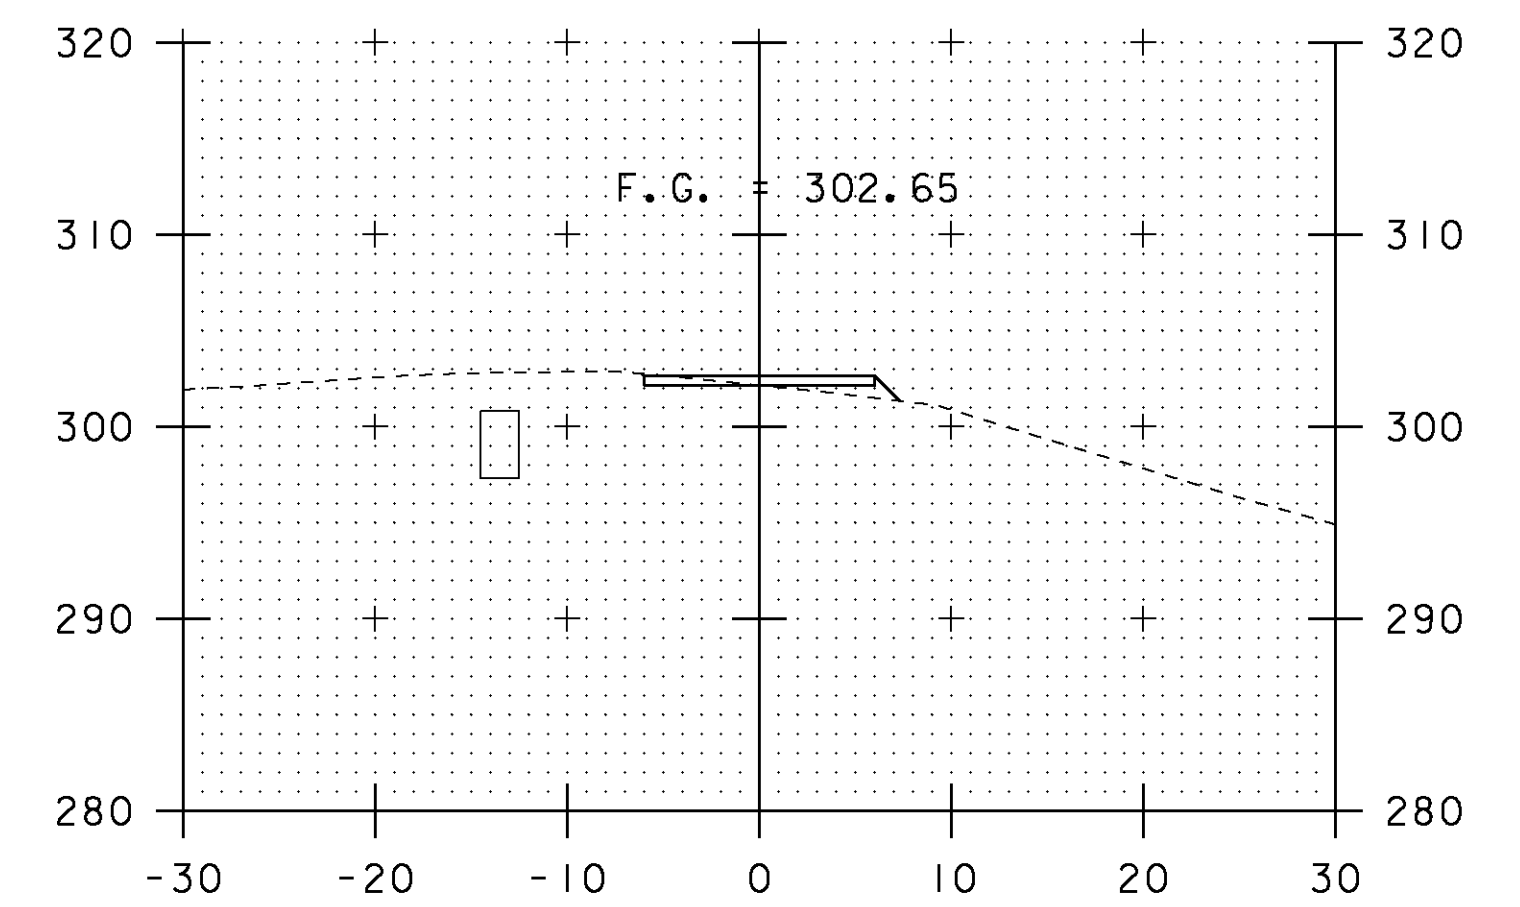


5+50

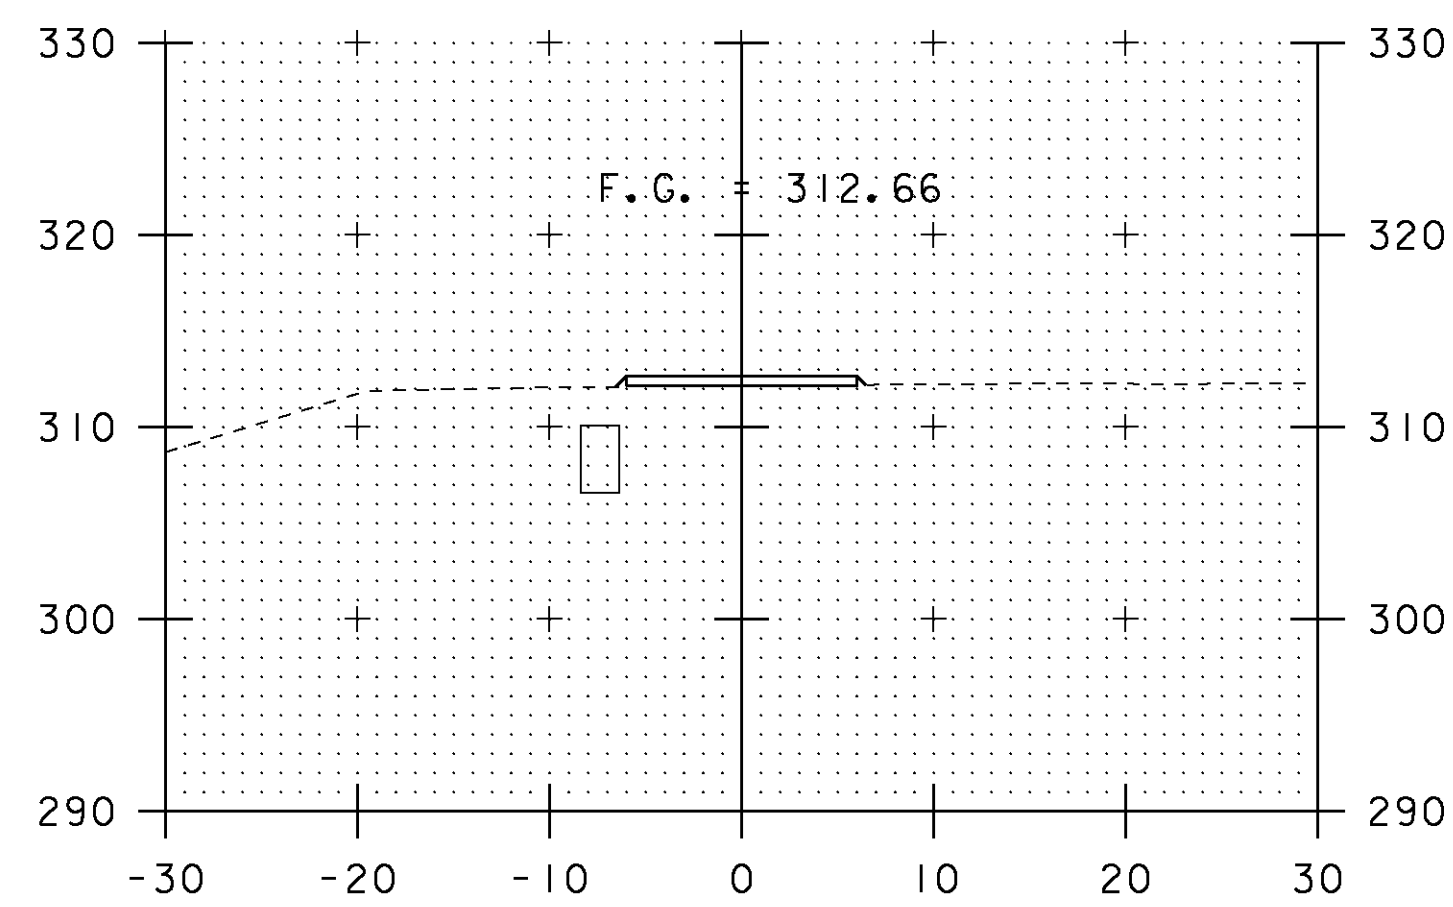


0+50

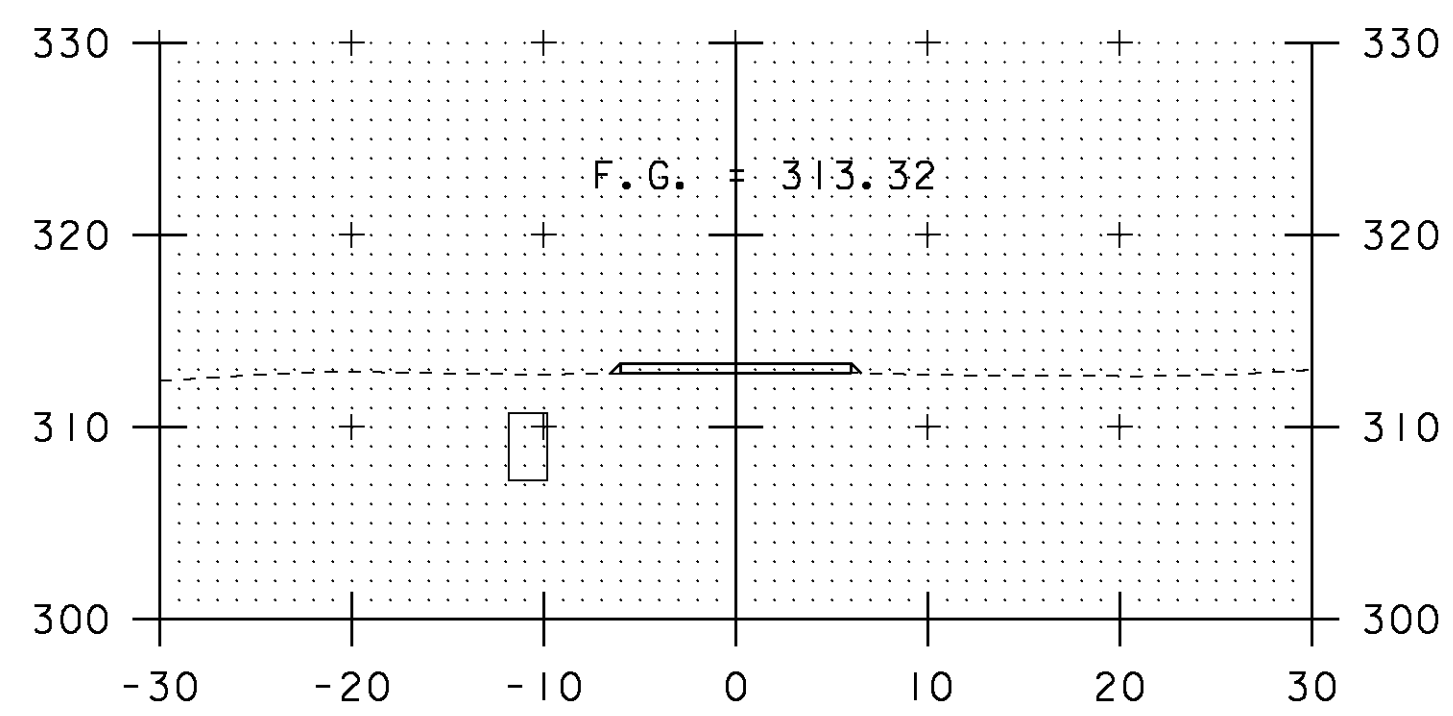


2+00

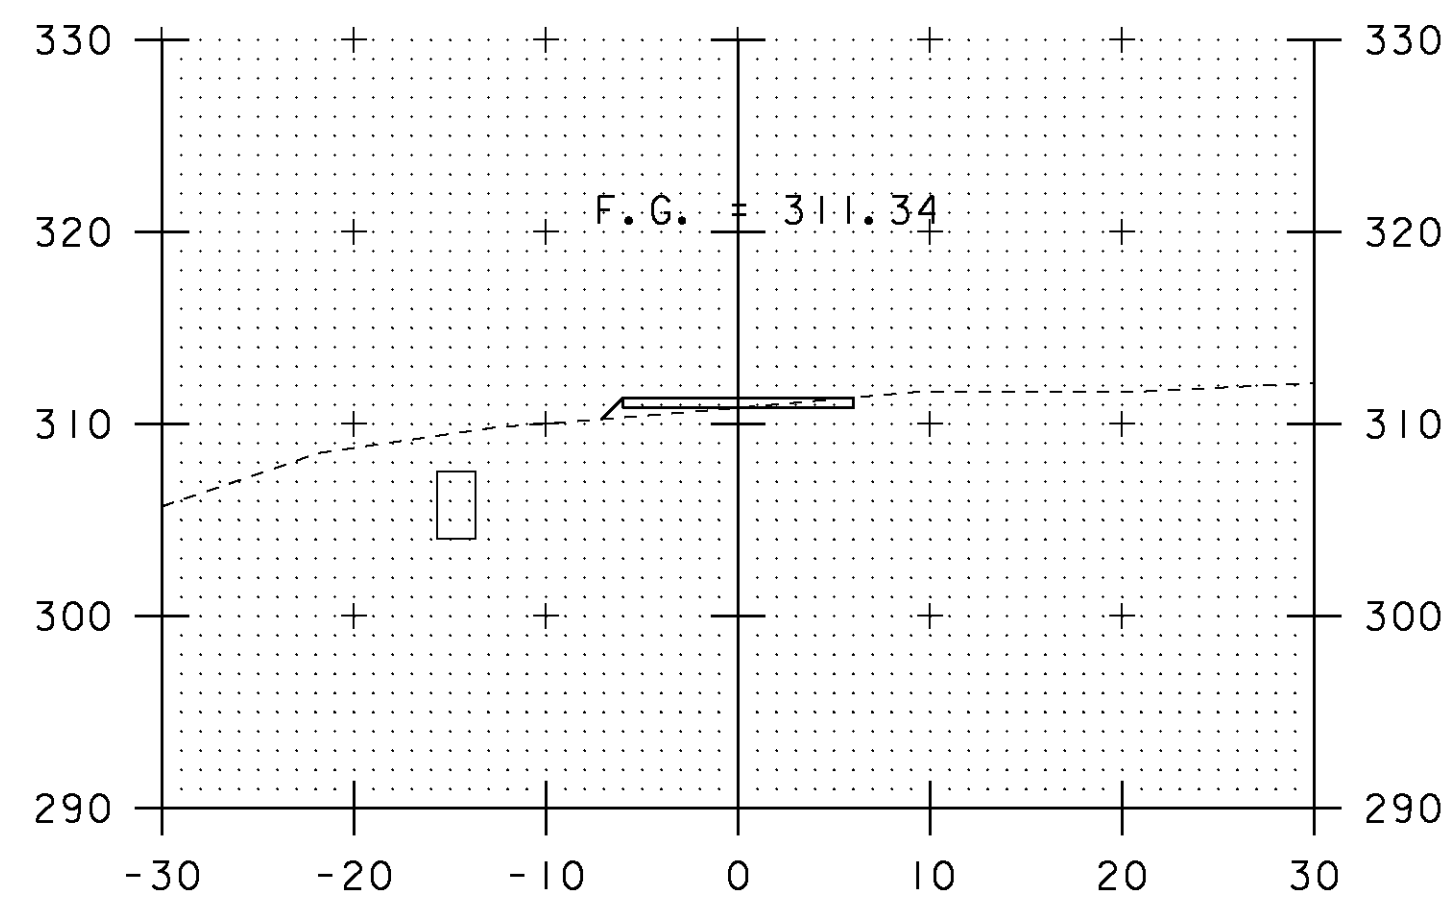


3+50

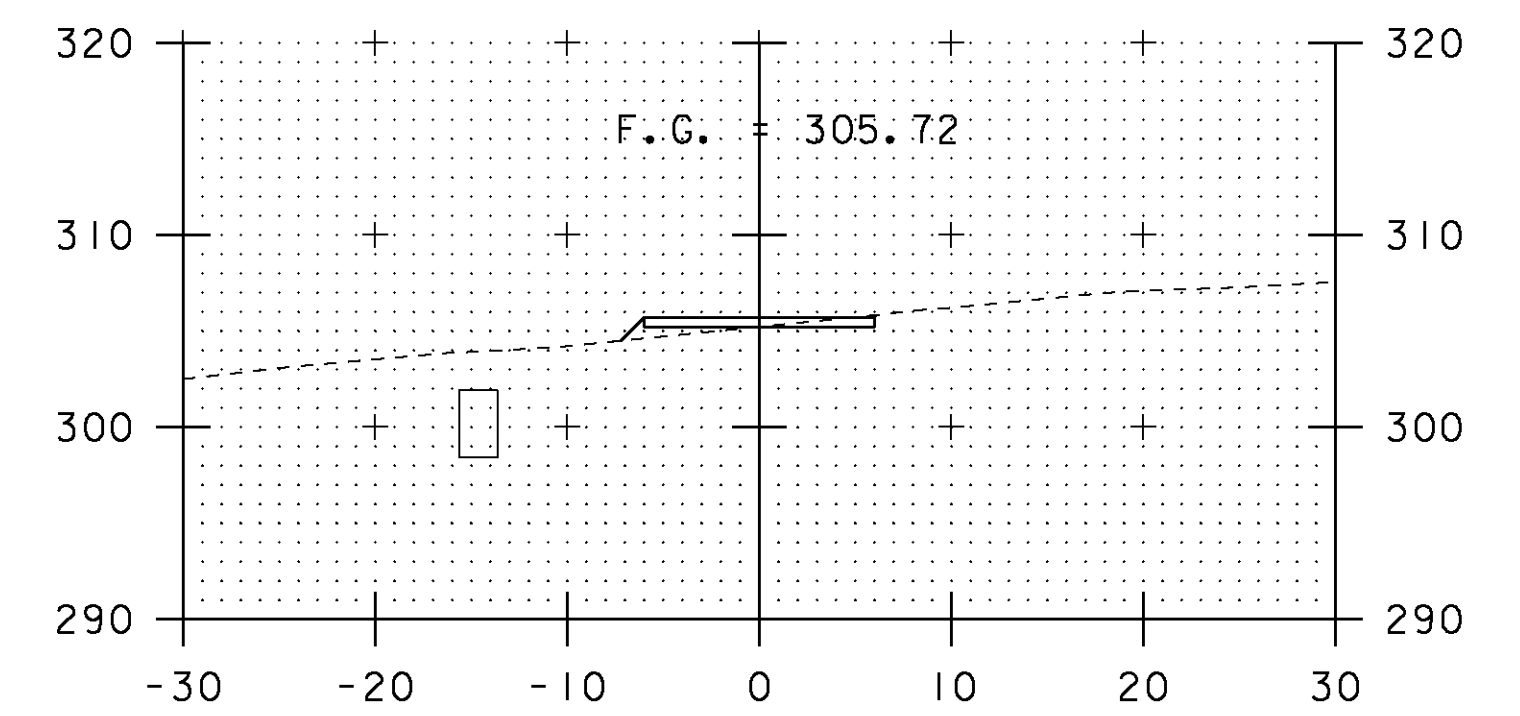


5+00

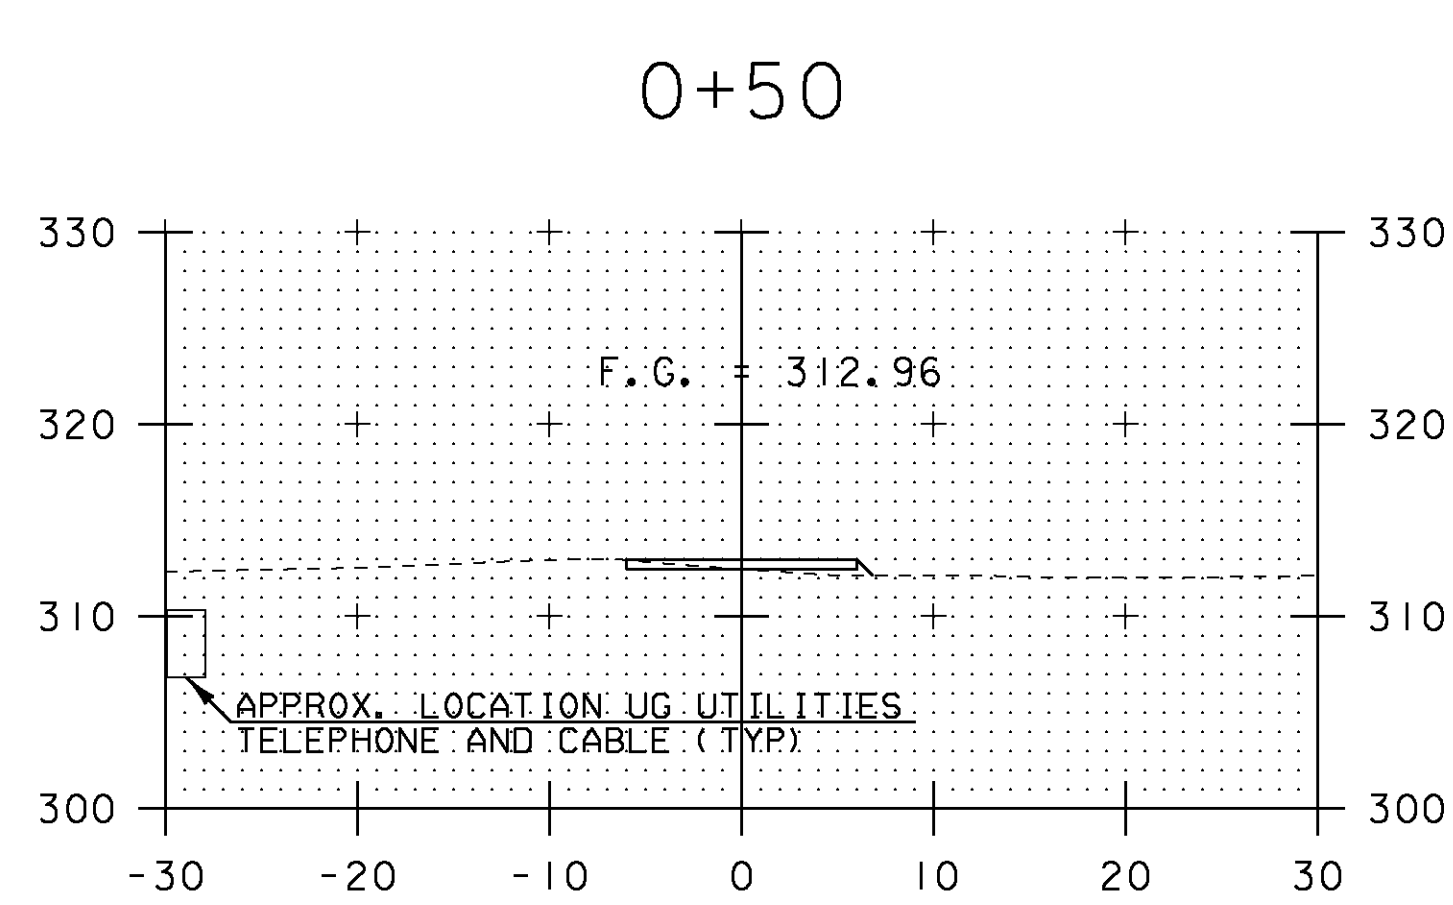


0+00

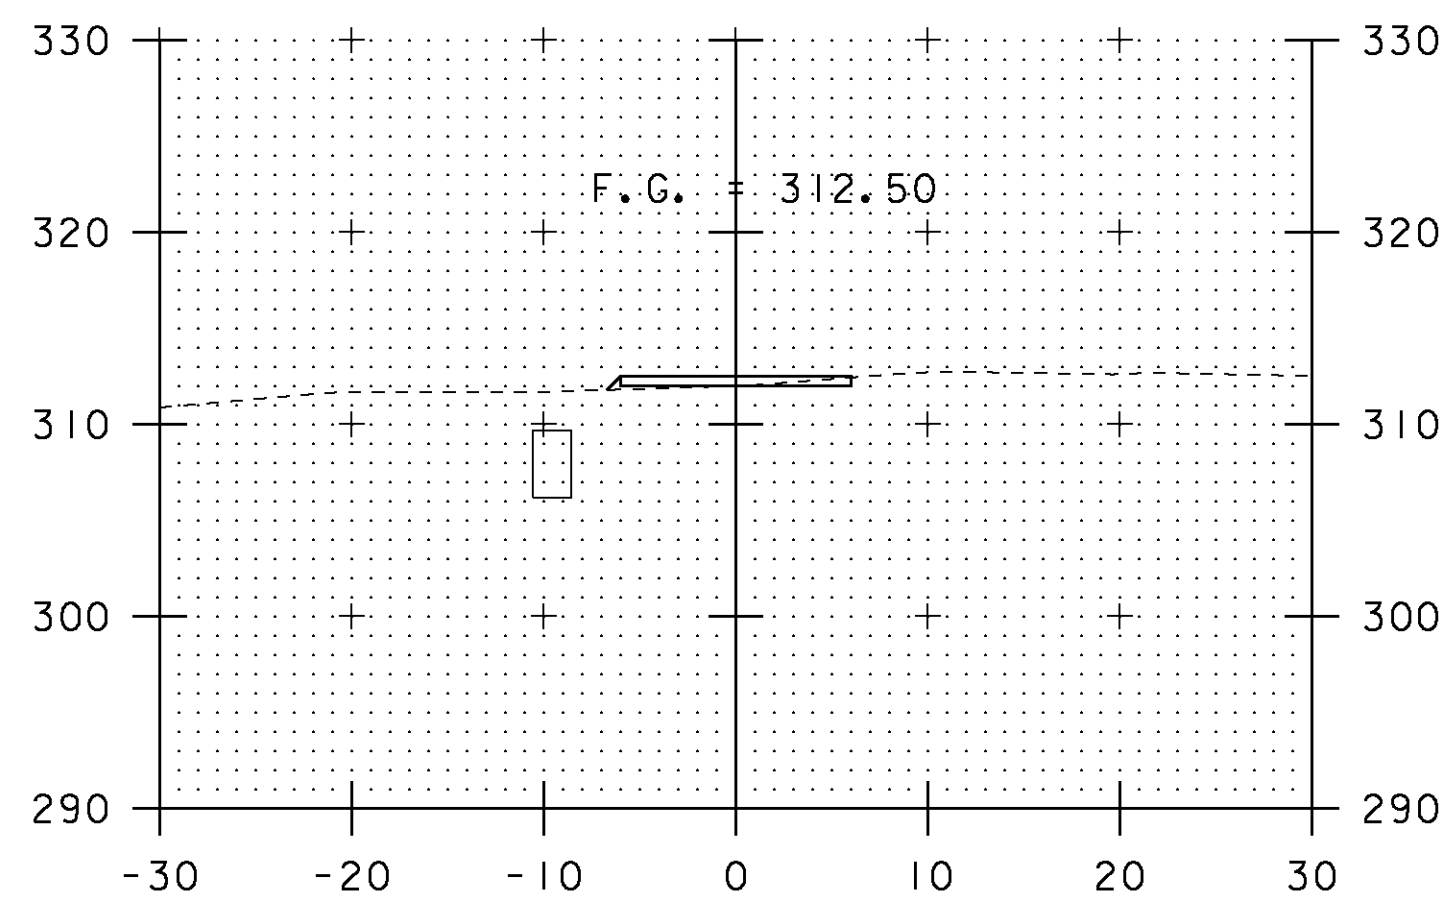

1+50

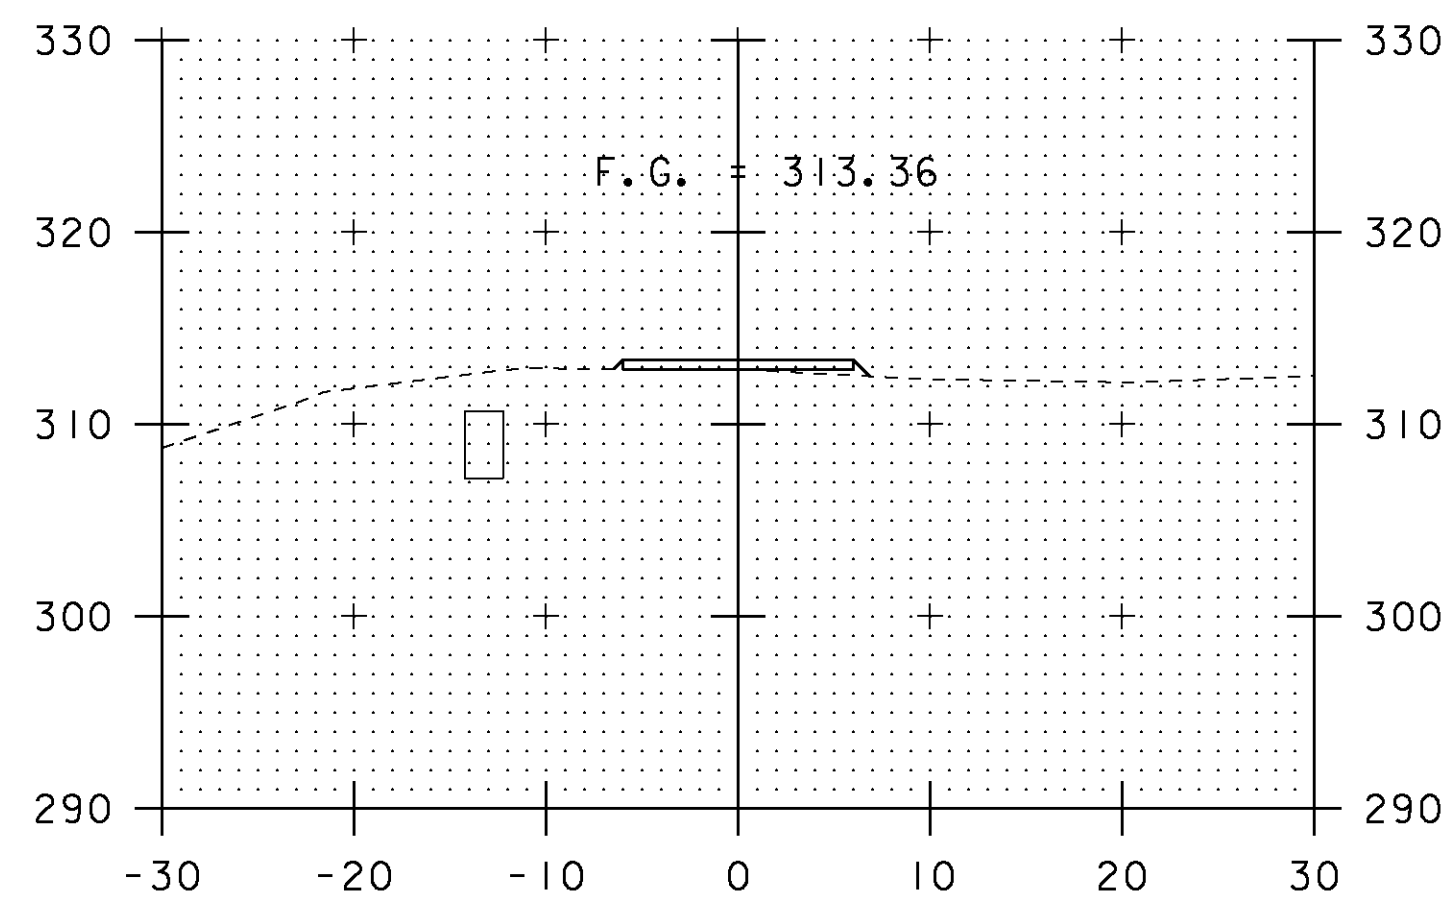


3+00

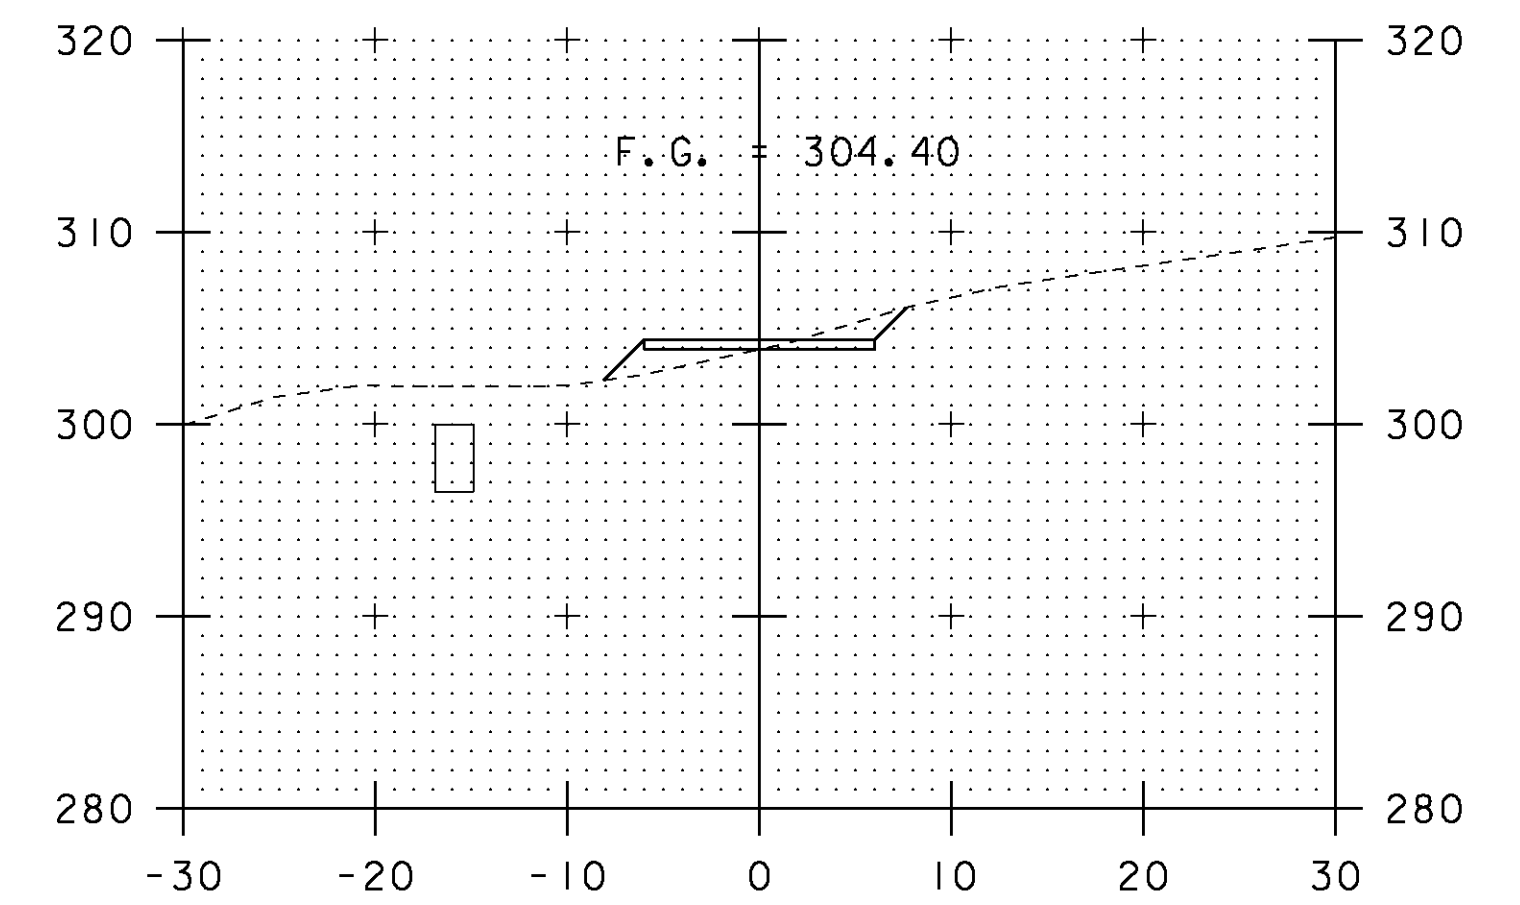

4+50

STA. 0+00 TO STA. 5+50

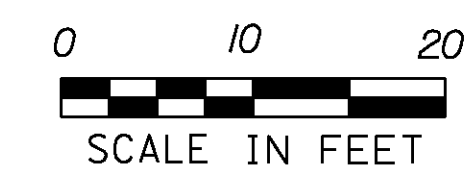

PROJECT NAME: SOUTH BURLINGTON	
PROJECT NUMBER: IM SCRP(3)	
FILE NAME: d07a104_nul.dgn	PLOT DATE: 13-JAN-2010
PROJECT LEADER: K. UPMAL	DRAWN BY: B. McADAMS
DESIGNED BY: B. KIPP/B. McADAMS	CHECKED BY: B. KIPP
ACCESS ROAD 2 CROSS SECTIONS	SHEET 19 OF 69