




6+50

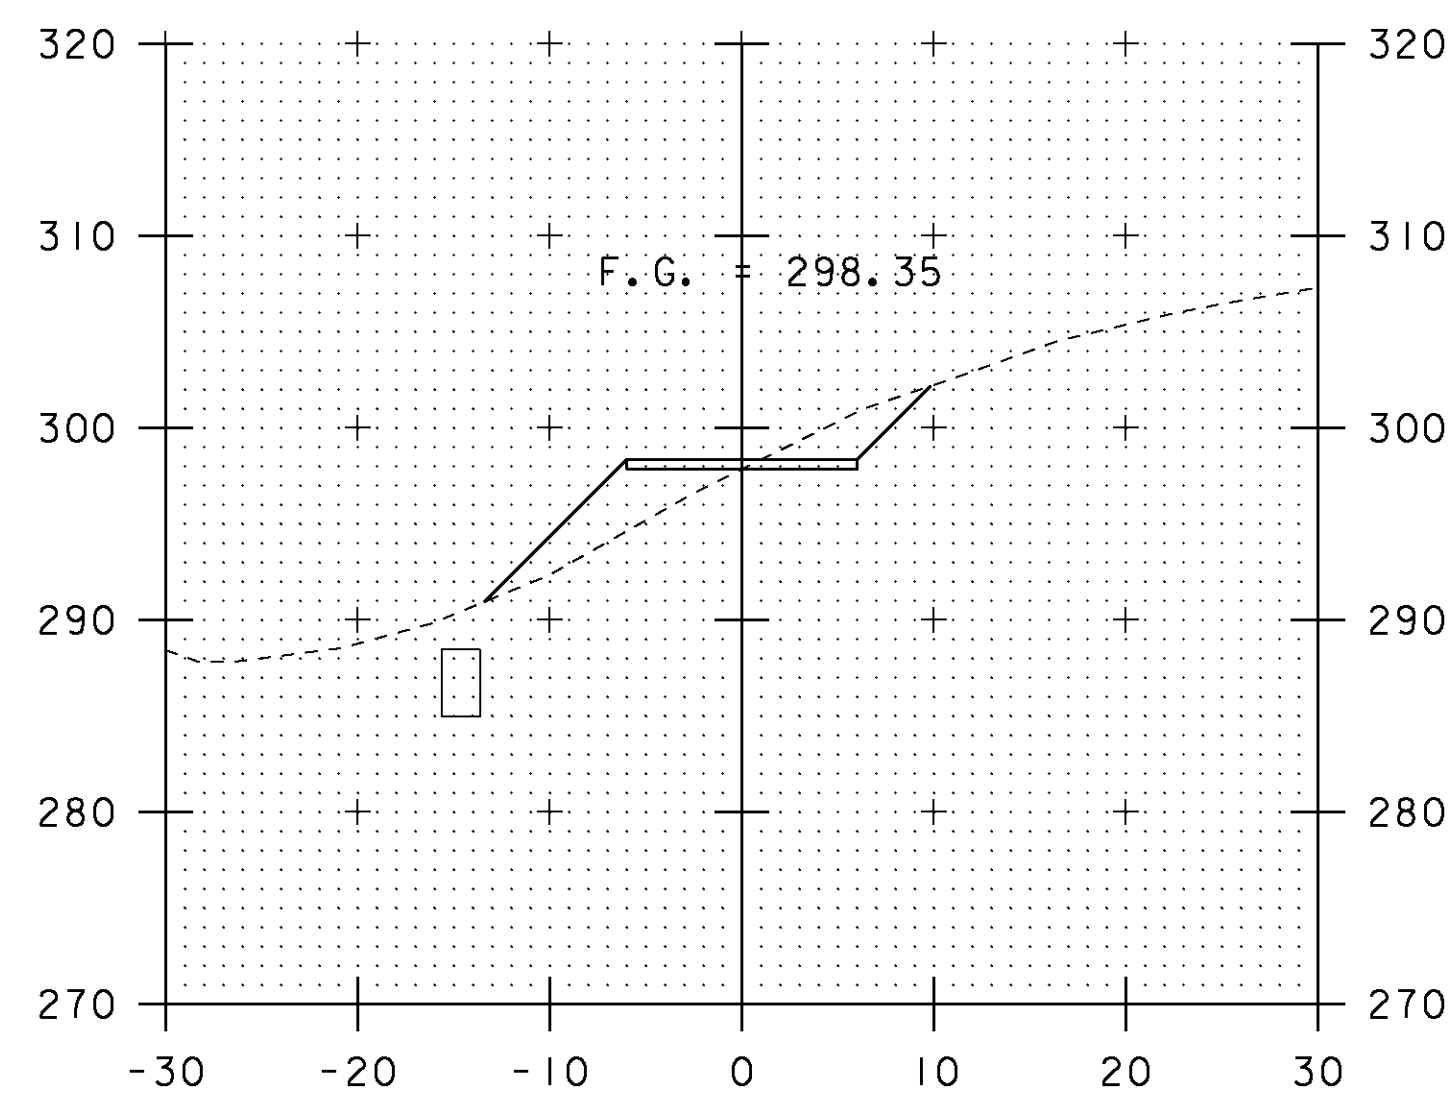


7+50

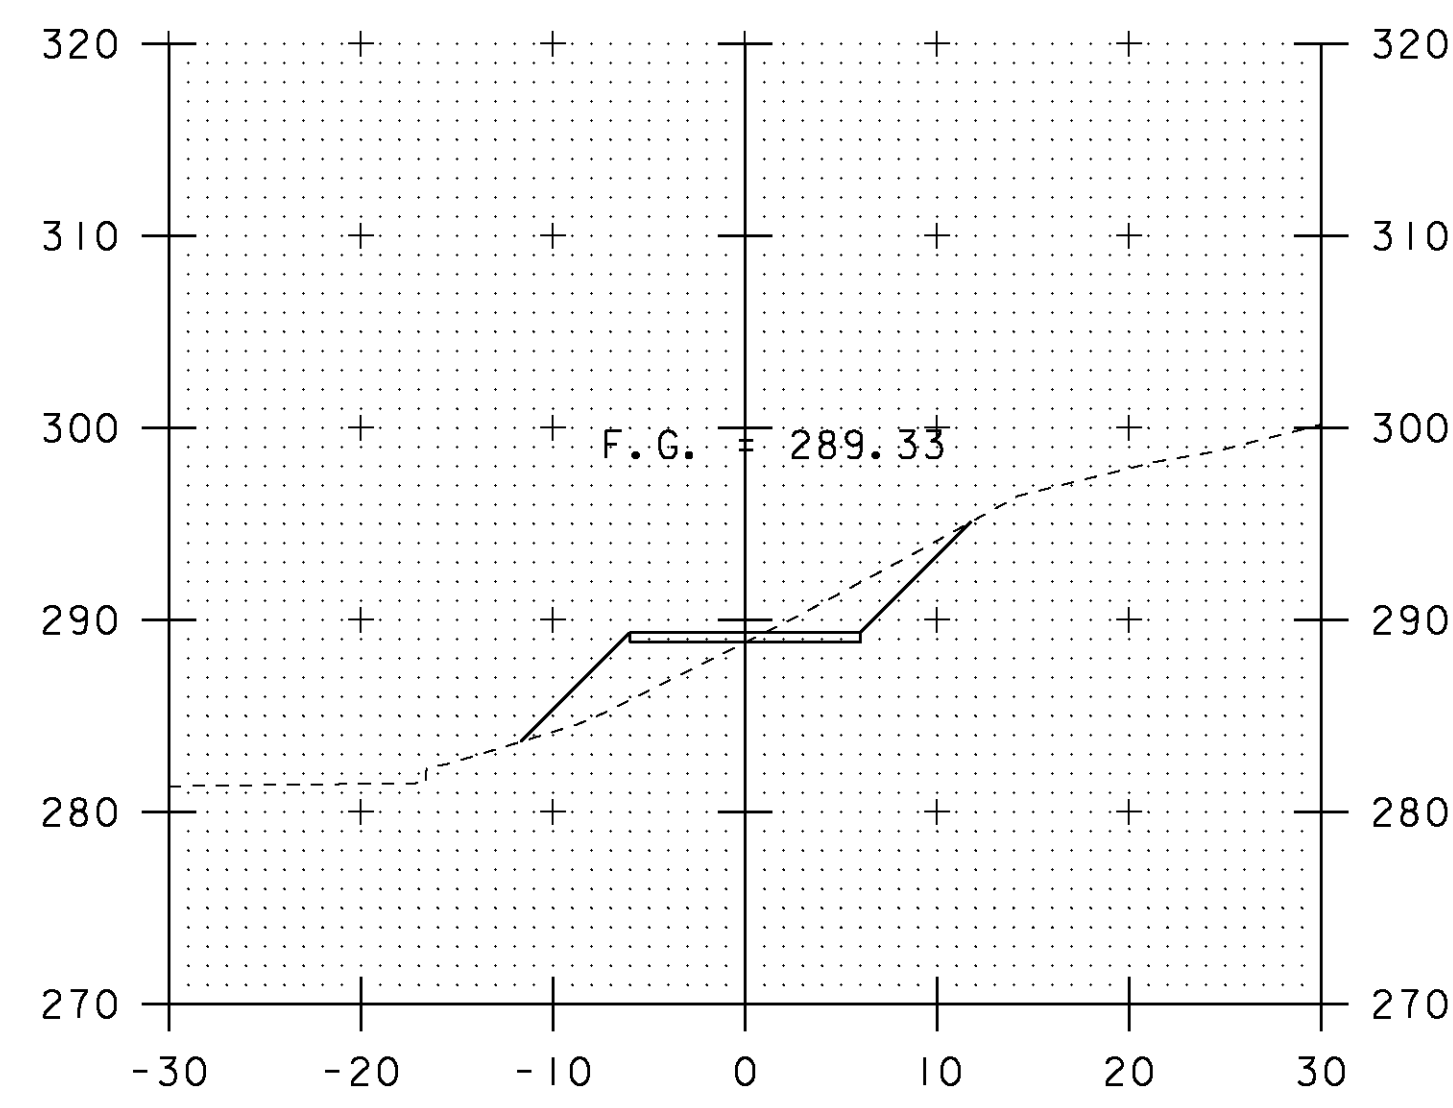


8+50

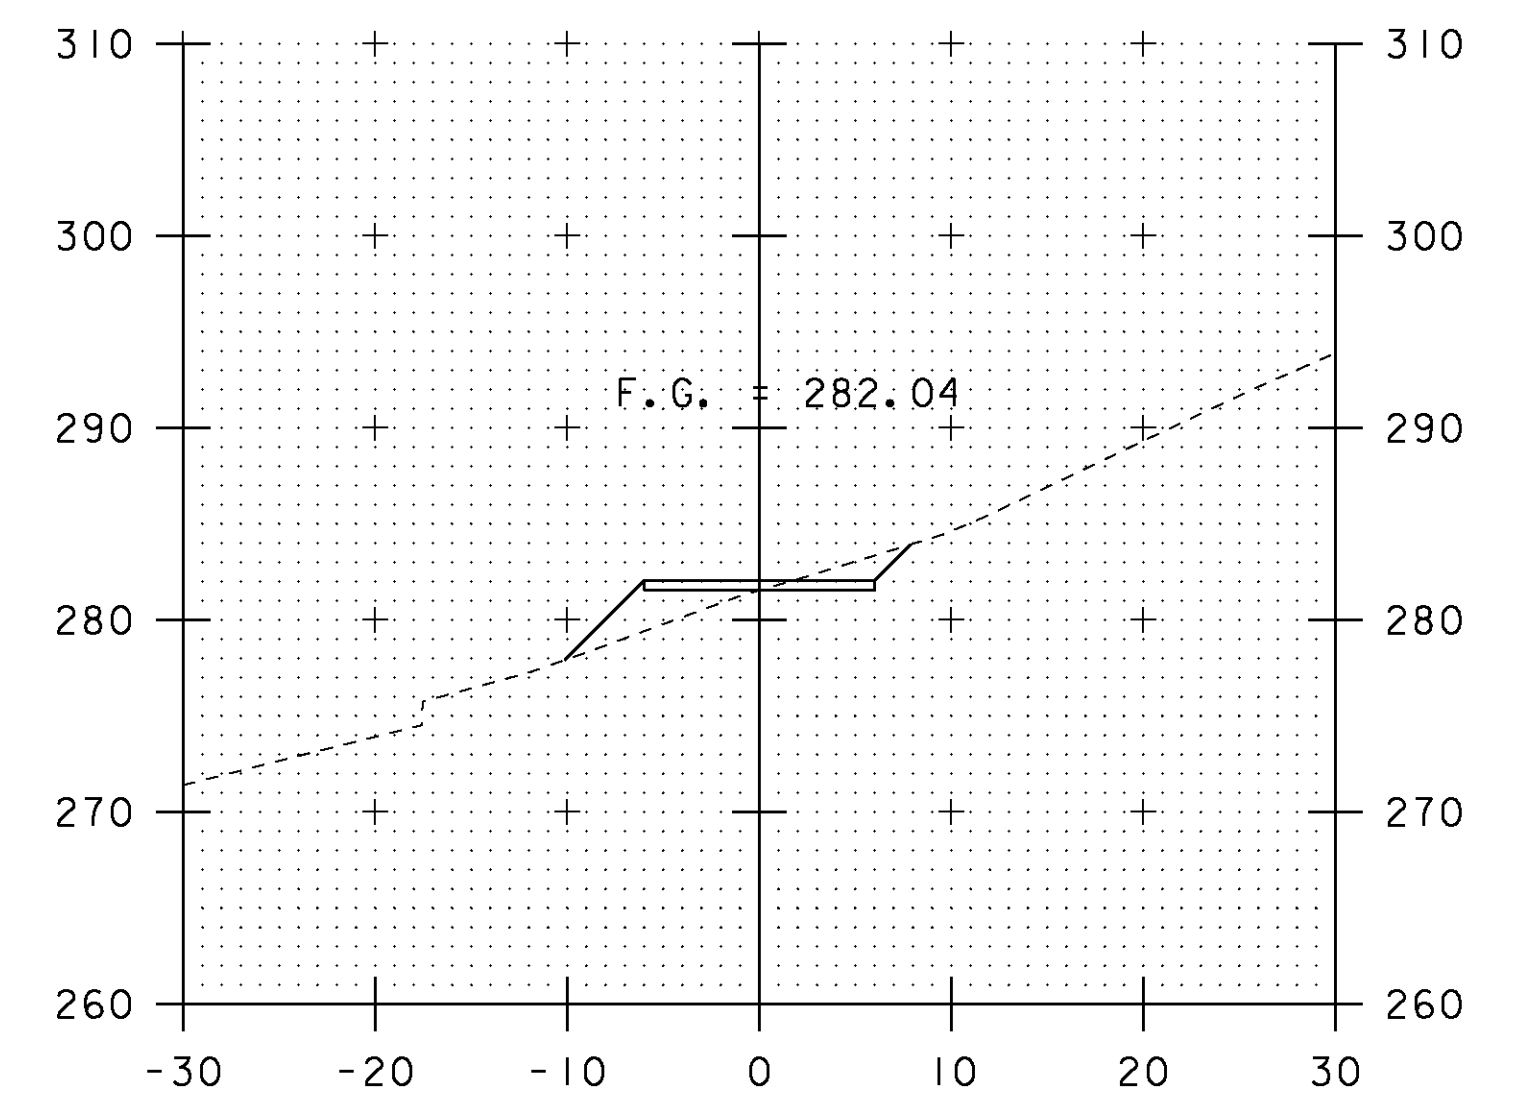


9+50

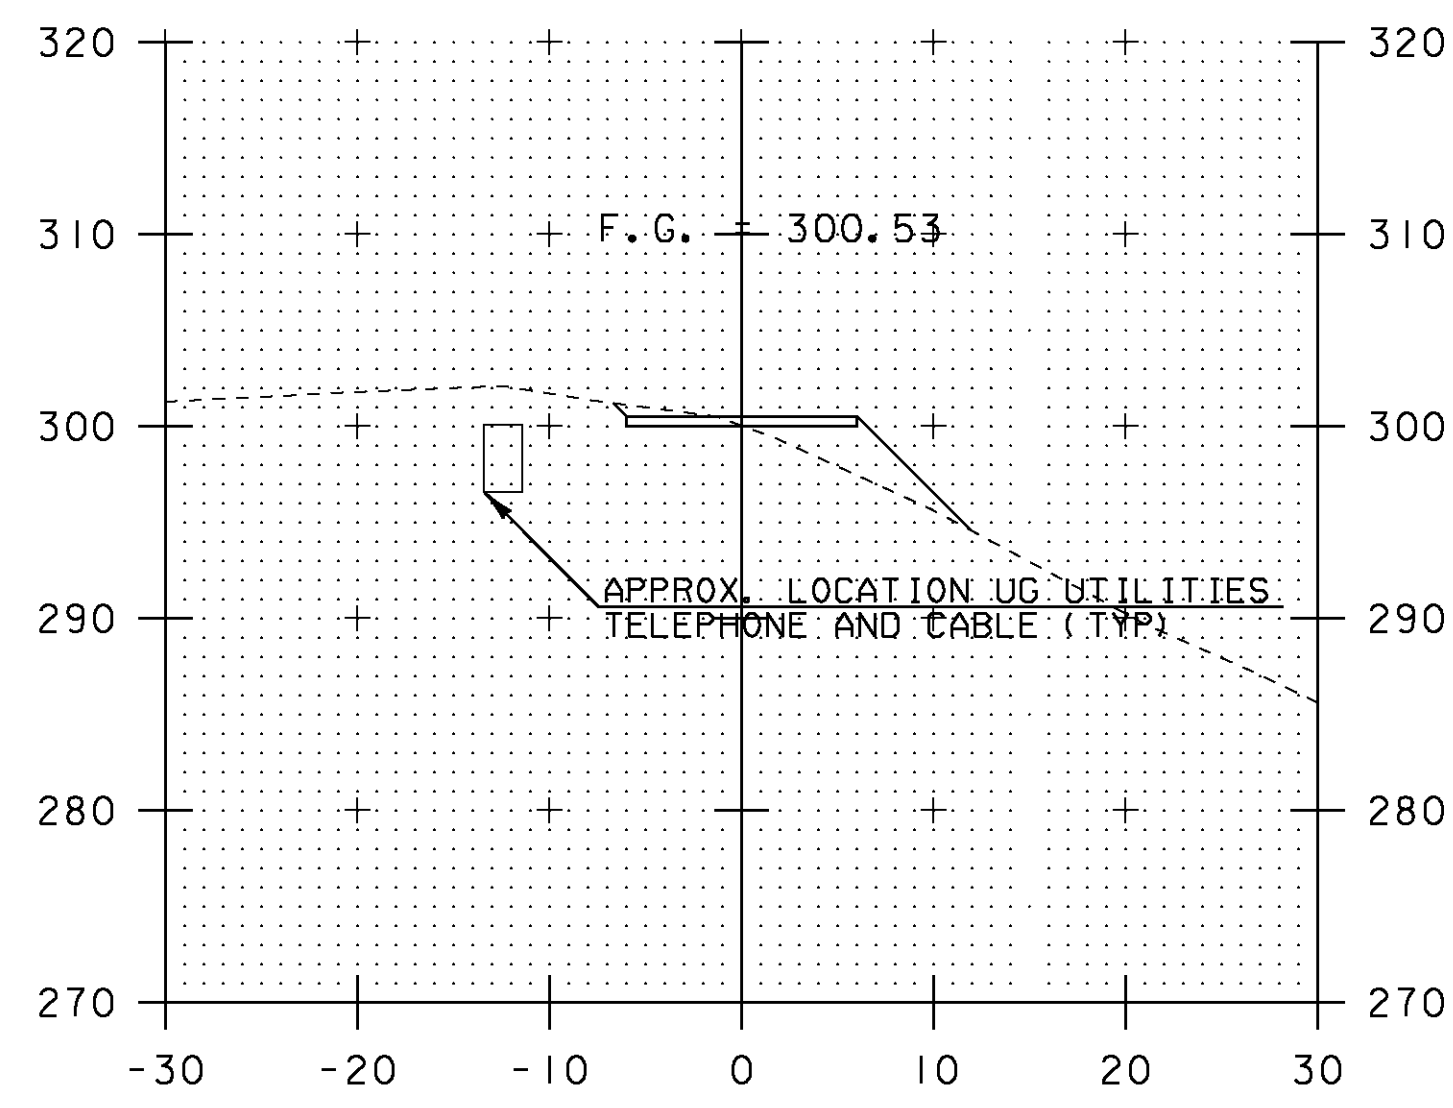


6+00

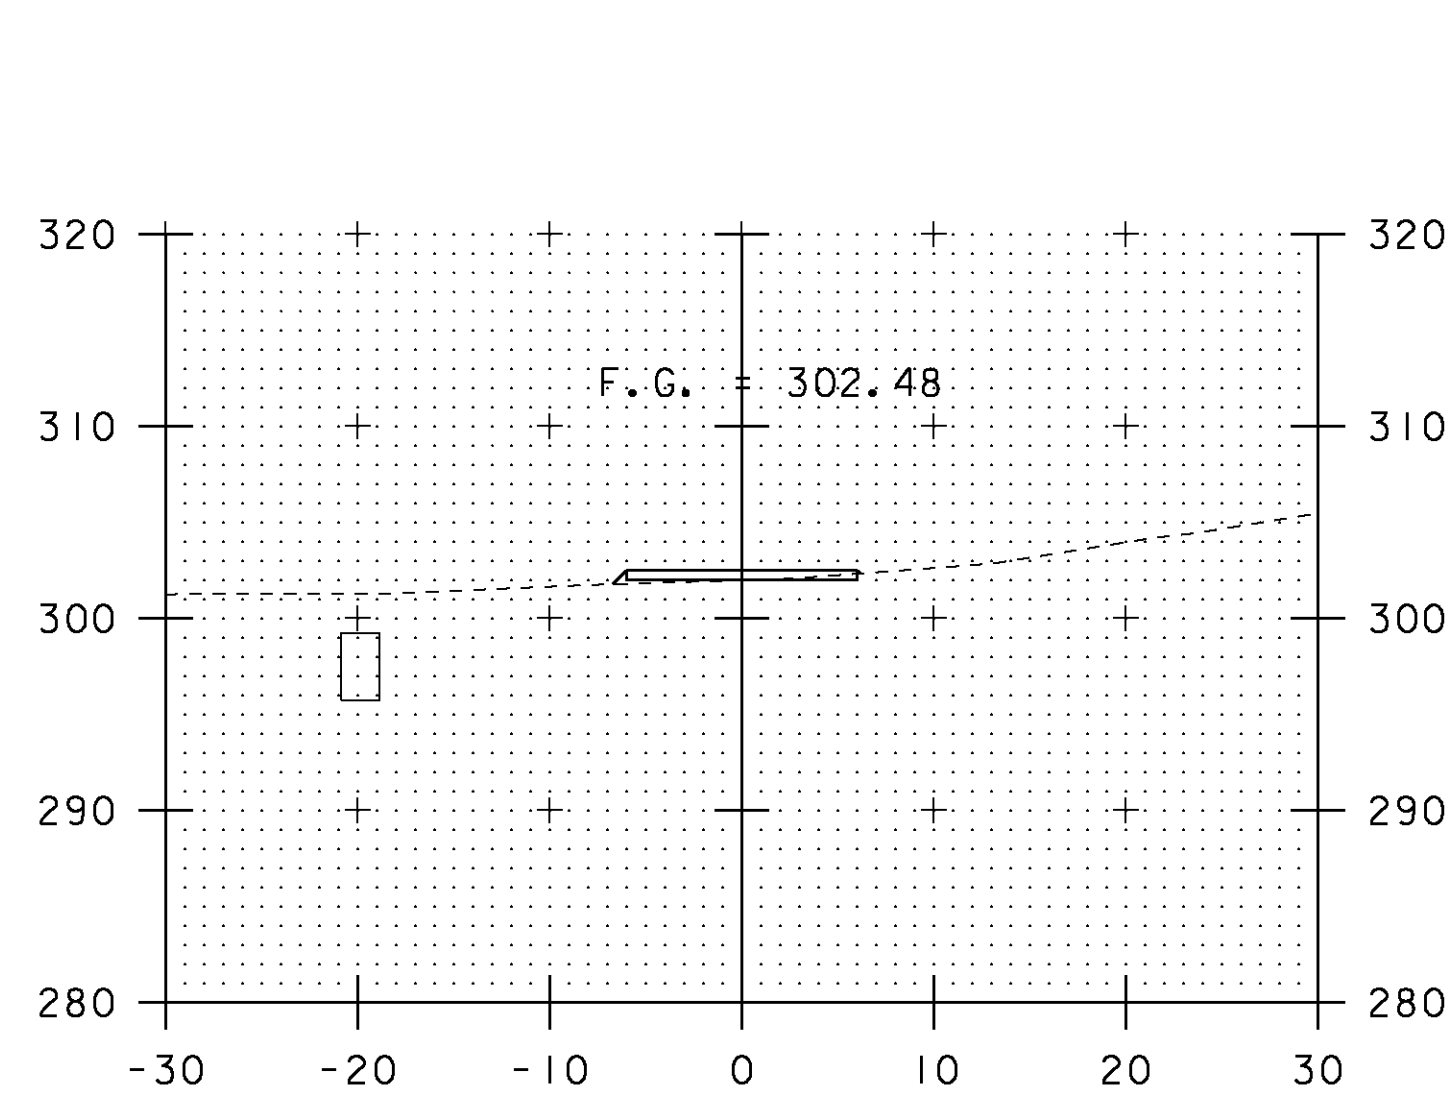

7+00

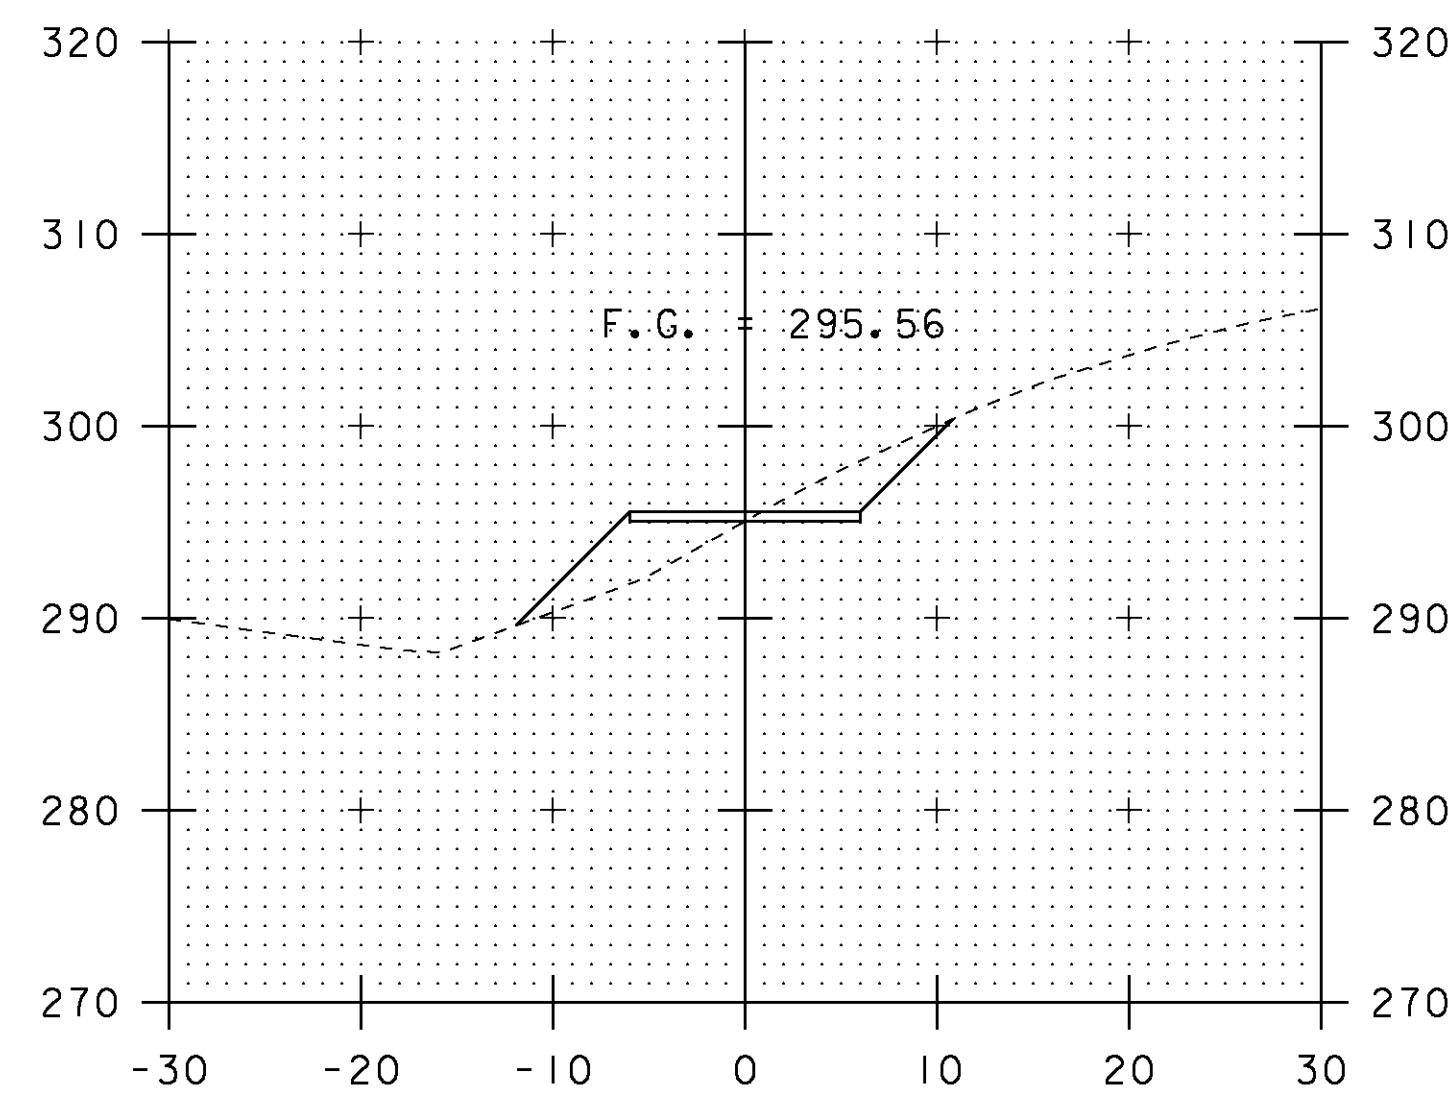


8+00

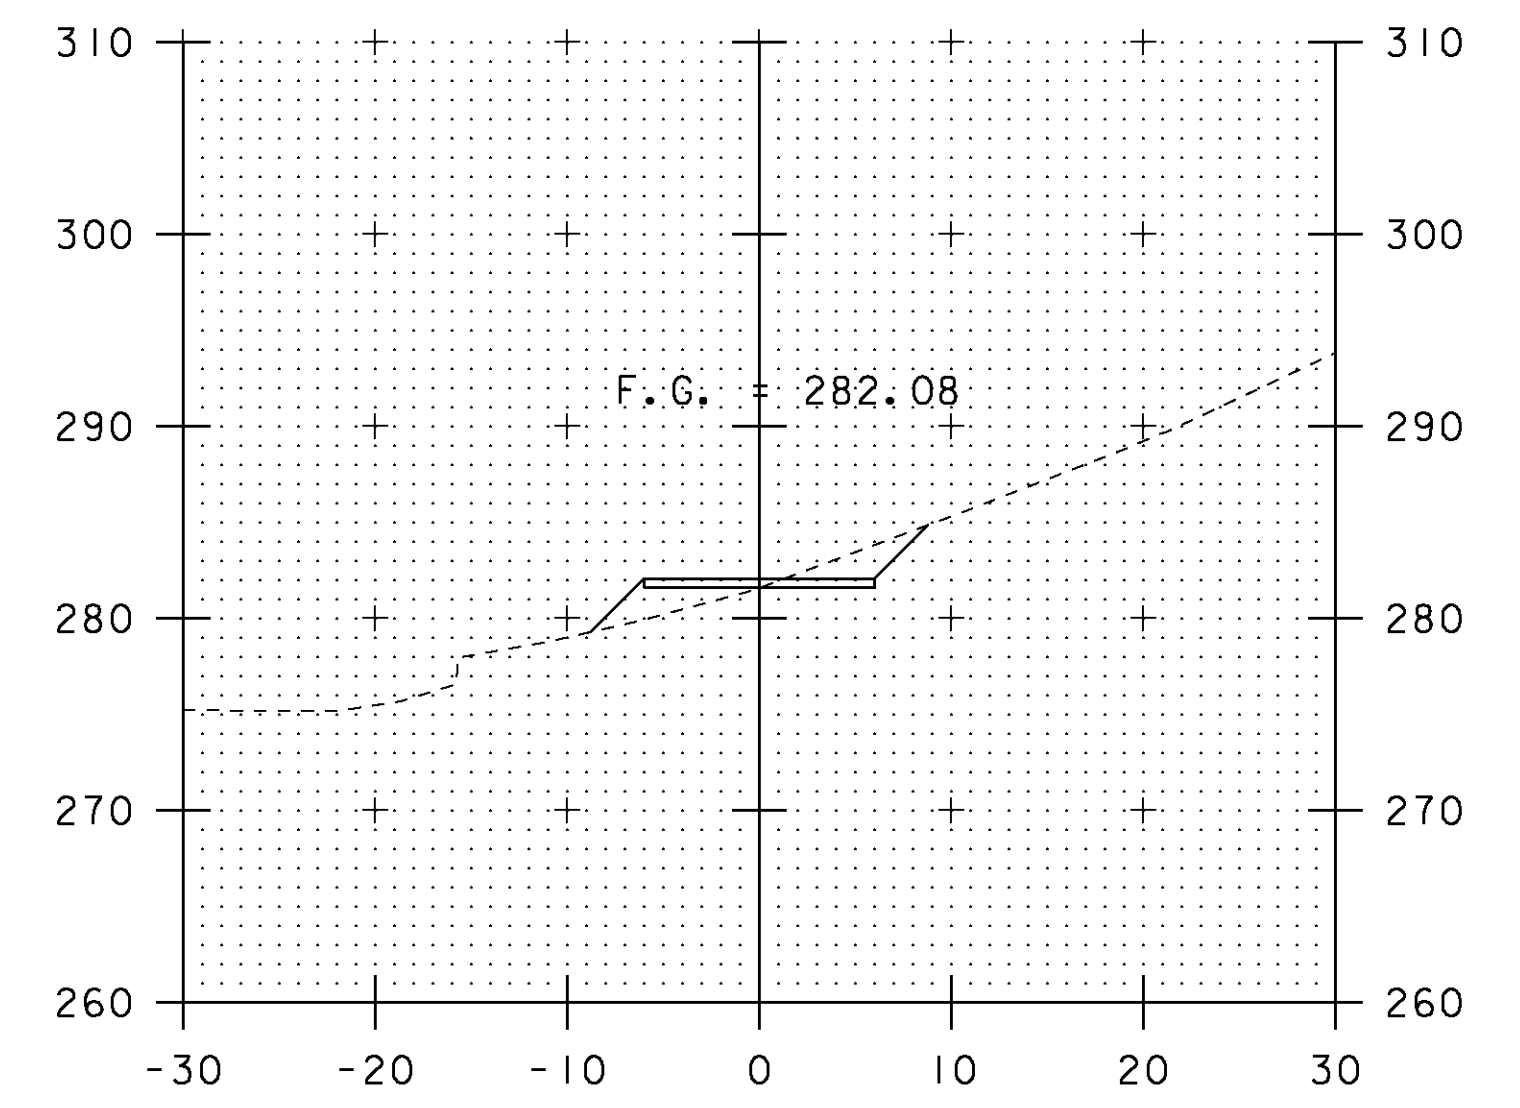

9+00

STA. 6+00 TO STA. 9+50

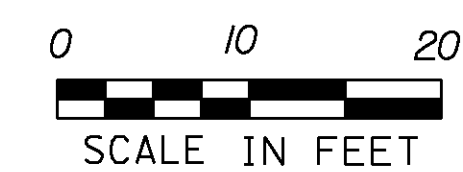

| | |
|---------------------------------|------------------------|
| PROJECT NAME: SOUTH BURLINGTON | |
| PROJECT NUMBER: IM SCRP(3) | |
| FILE NAME: d07a104_nul.dgn | PLOT DATE: 13-JAN-2010 |
| PROJECT LEADER: K. UPMAL | DRAWN BY: B. McADAMS |
| DESIGNED BY: B. KIPP/B. McADAMS | CHECKED BY: B. KIPP |
| ACCESS ROAD 2 CROSS SECTIONS | SHEET 20 OF 69 |