




11+00

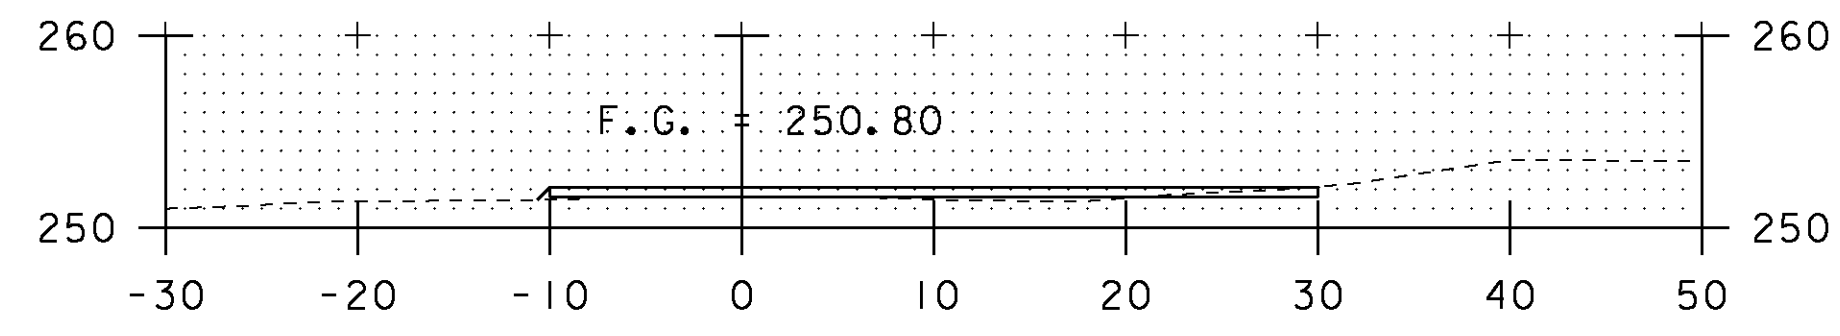


12+50

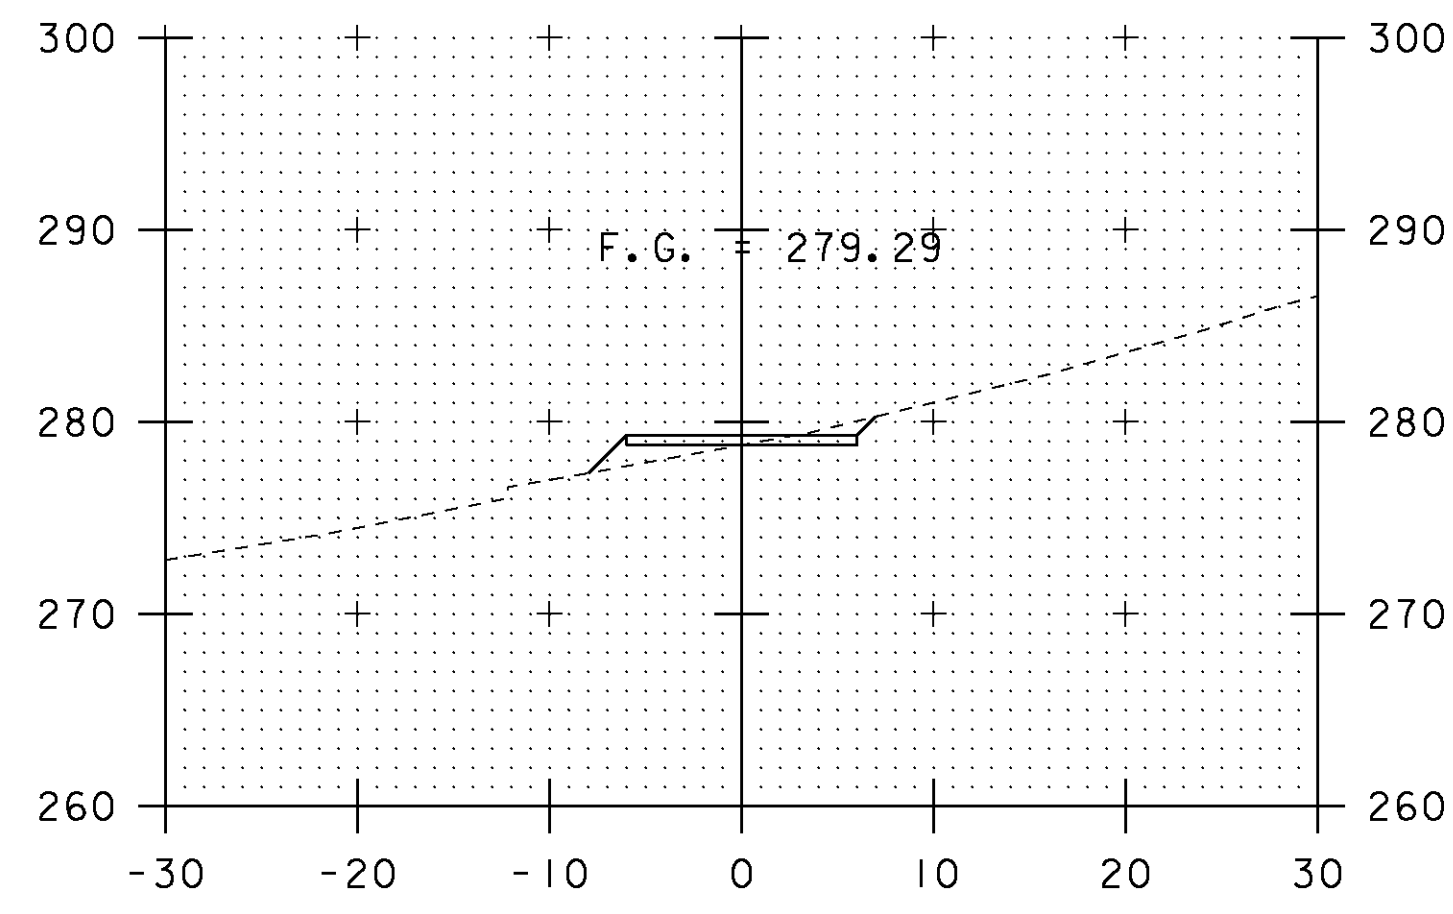


10+50

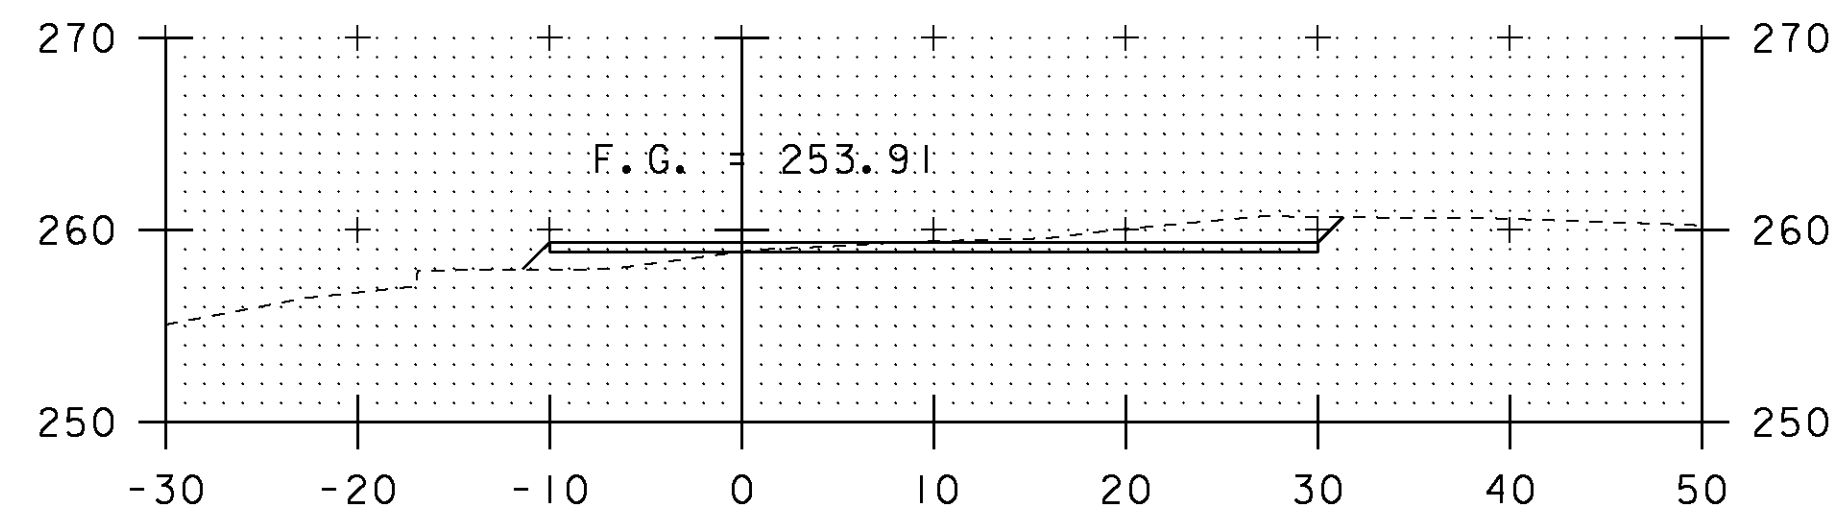

12+00

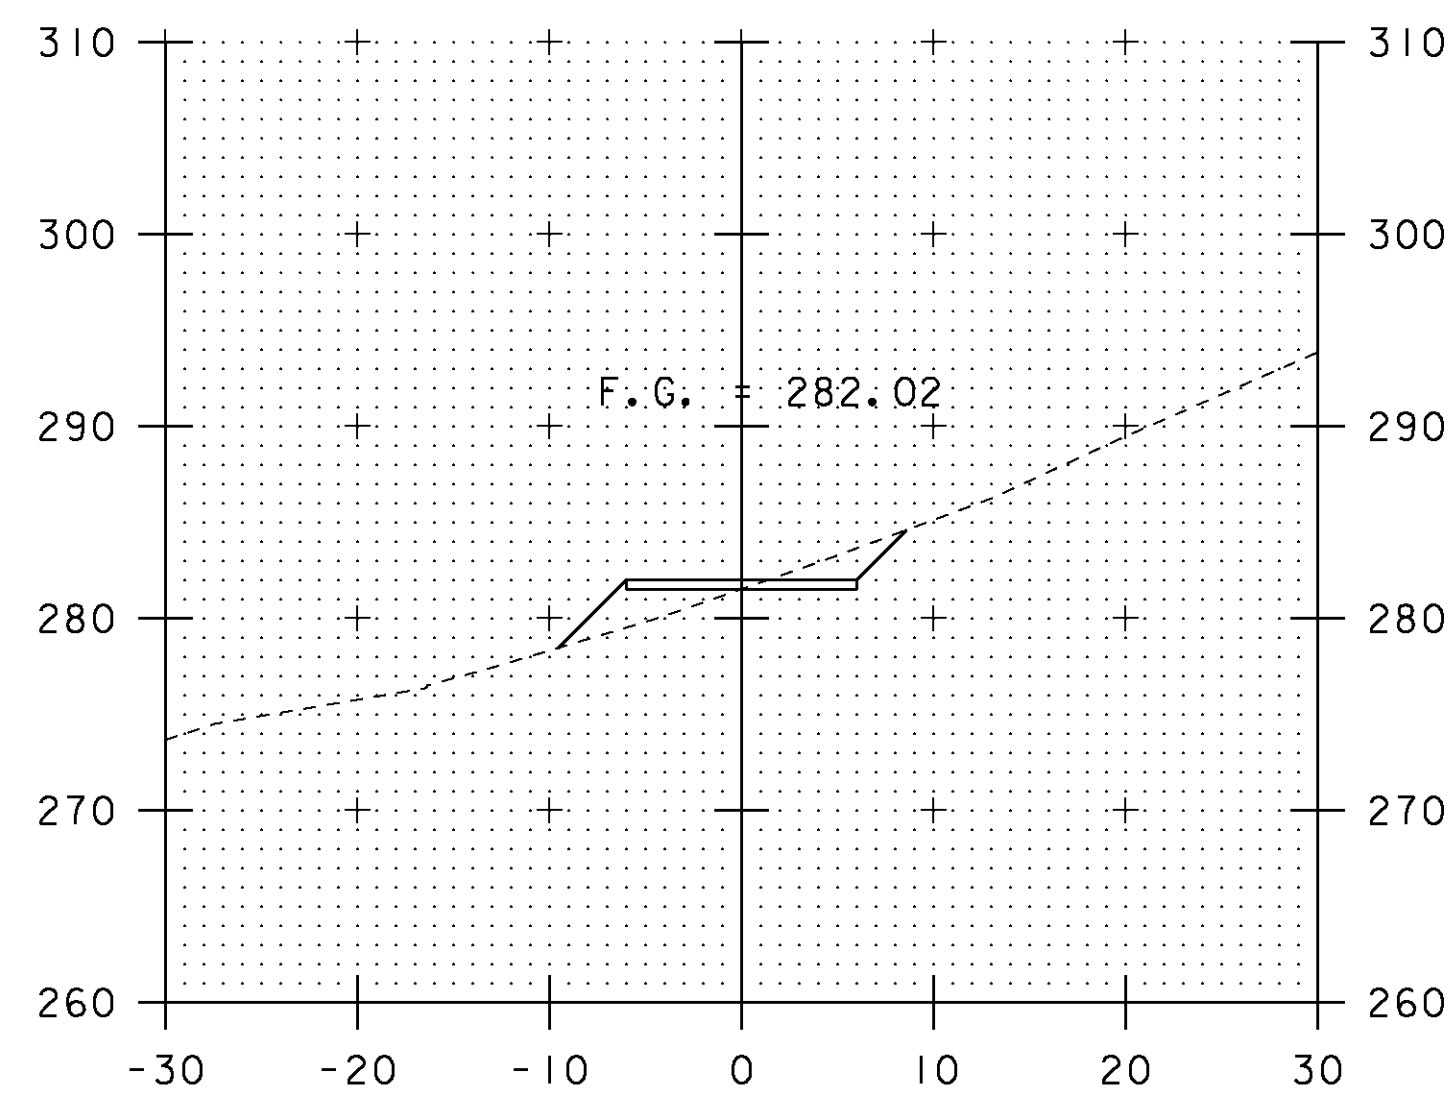


10+00

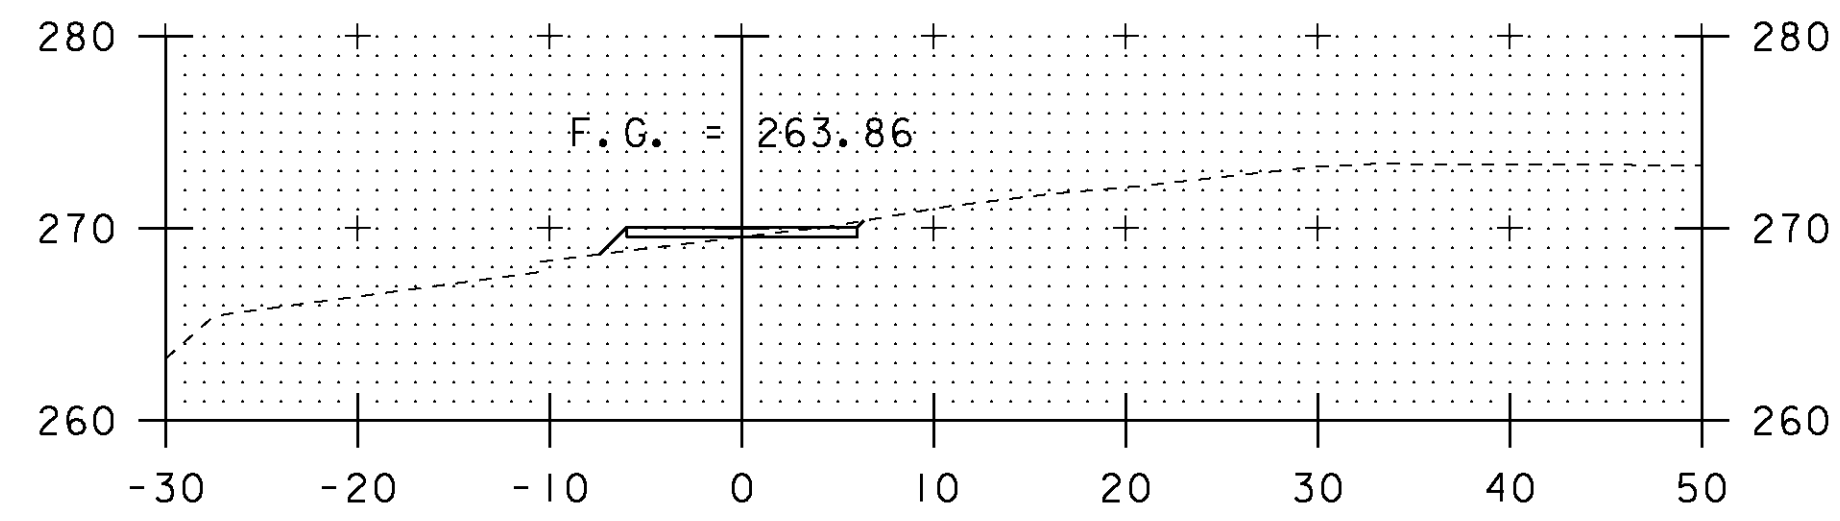

11+50

STA. 10+00 TO STA. 12+50

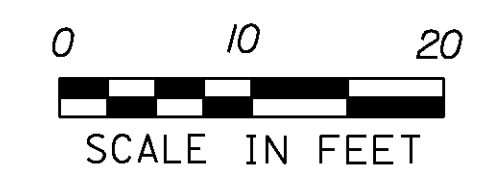

PROJECT NAME: SOUTH BURLINGTON	PLOT DATE: 13-JAN-2010
PROJECT NUMBER: IM SCRP(3)	DRAWN BY: B. McADAMS
FILE NAME: d07a104_nul.dgn	DESIGNED BY: B. KIPP/B. McADAMS
DESIGNED BY: B. KIPP/B. McADAMS	CHECKED BY: B. KIPP
ACCESS ROAD 2 CROSS SECTIONS	SHEET 21 OF 69