




0+50

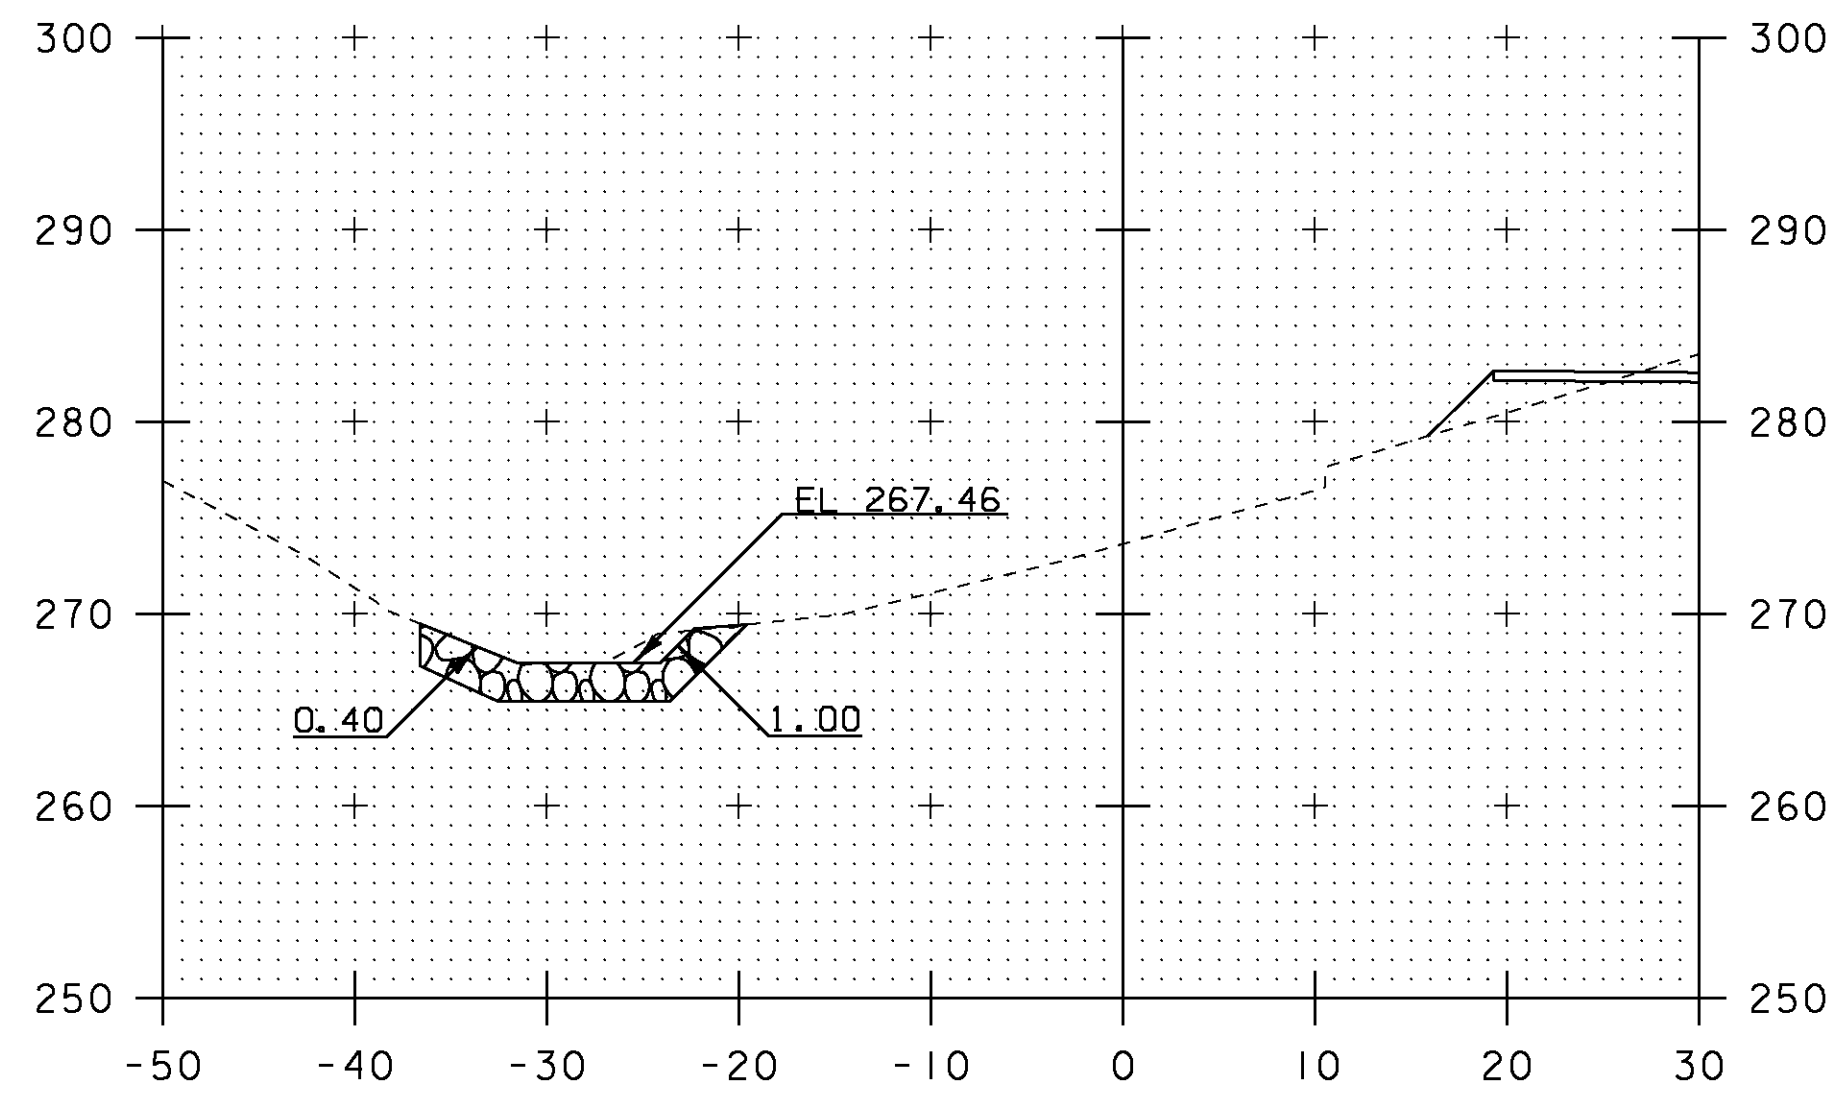


1+50

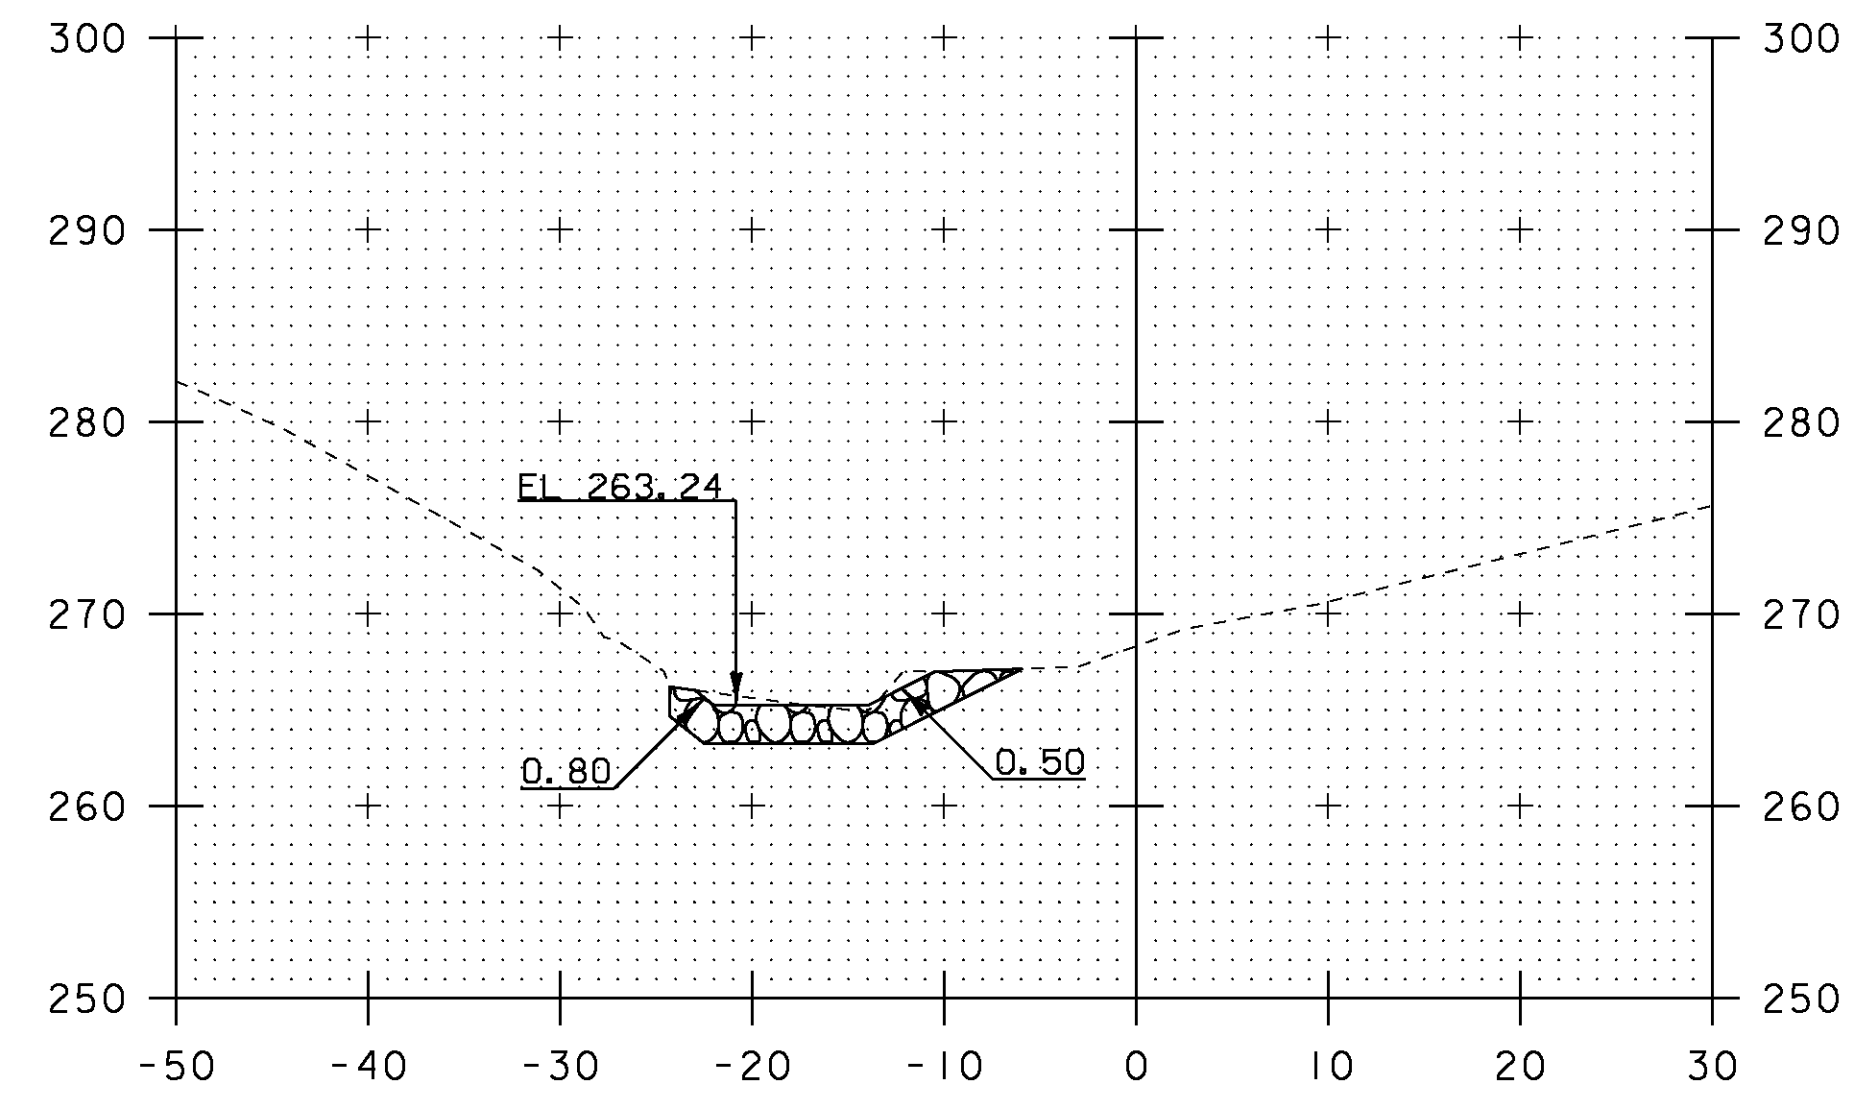


2+00

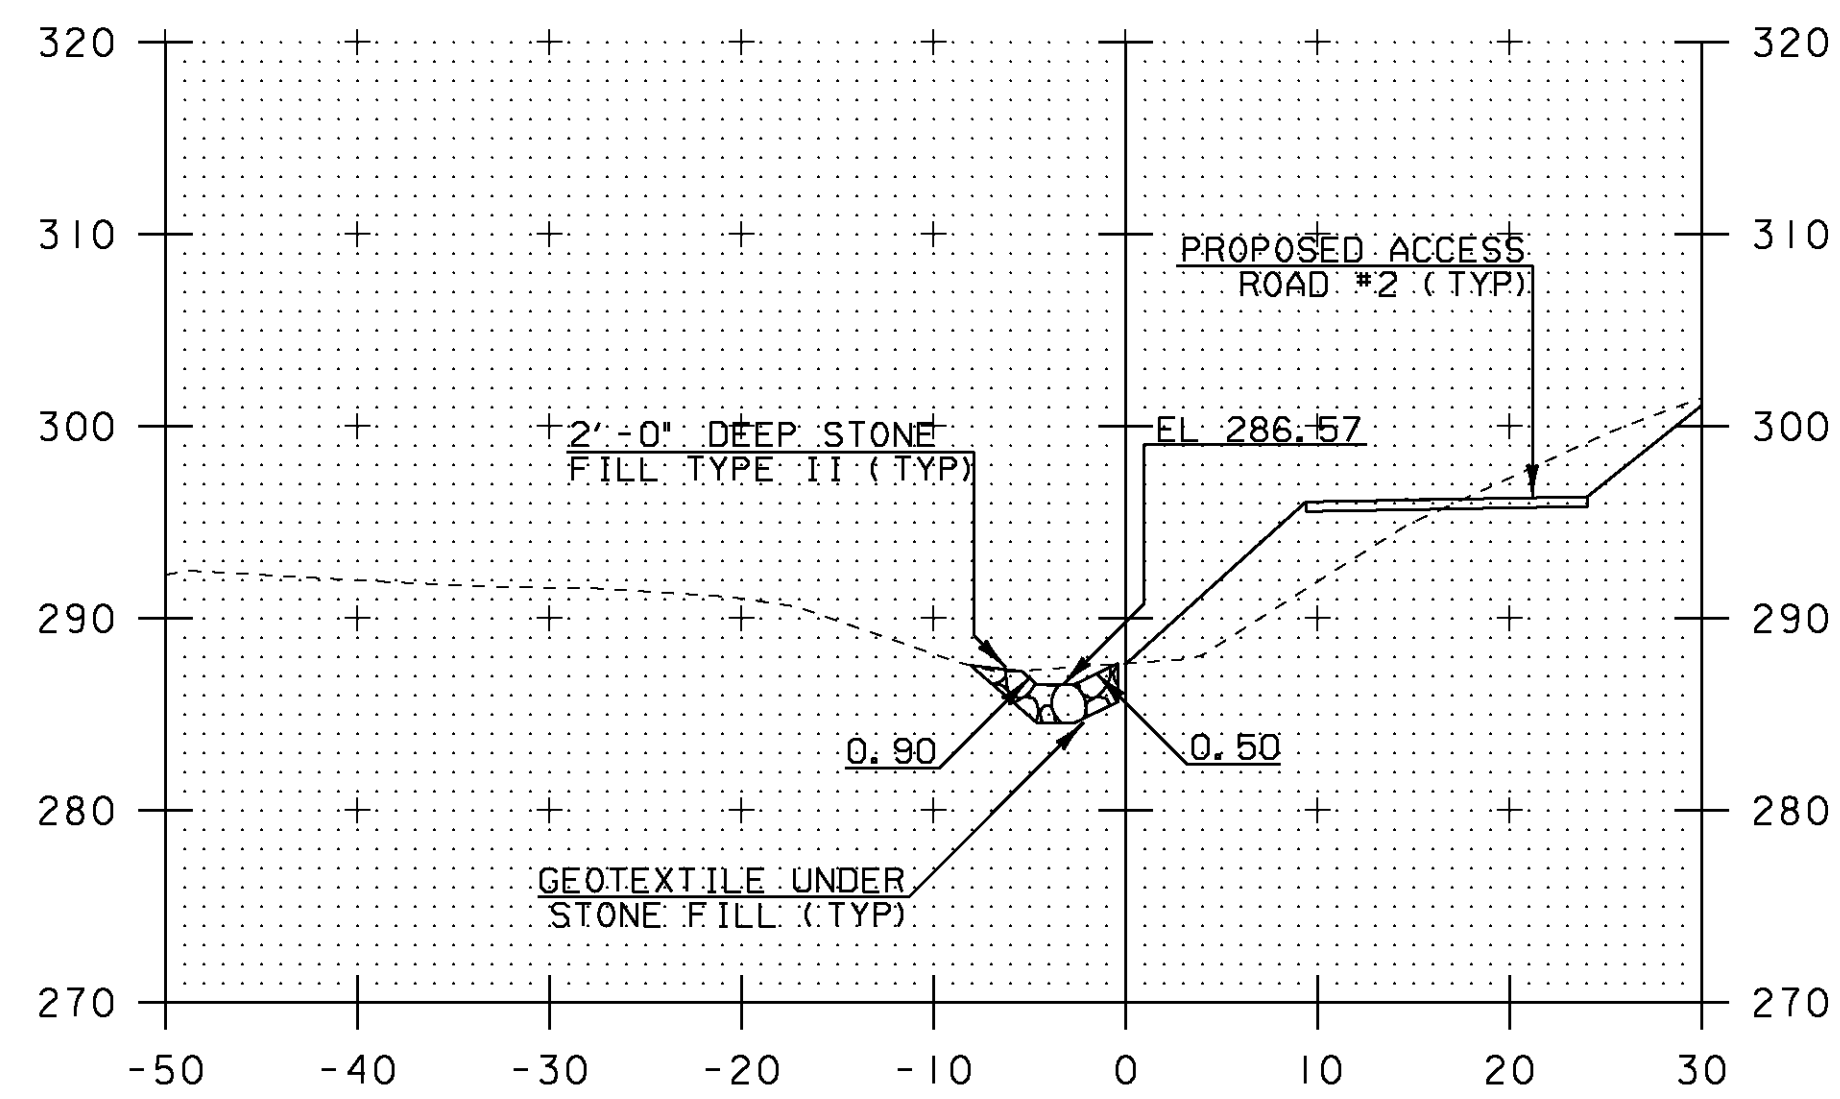

0+00

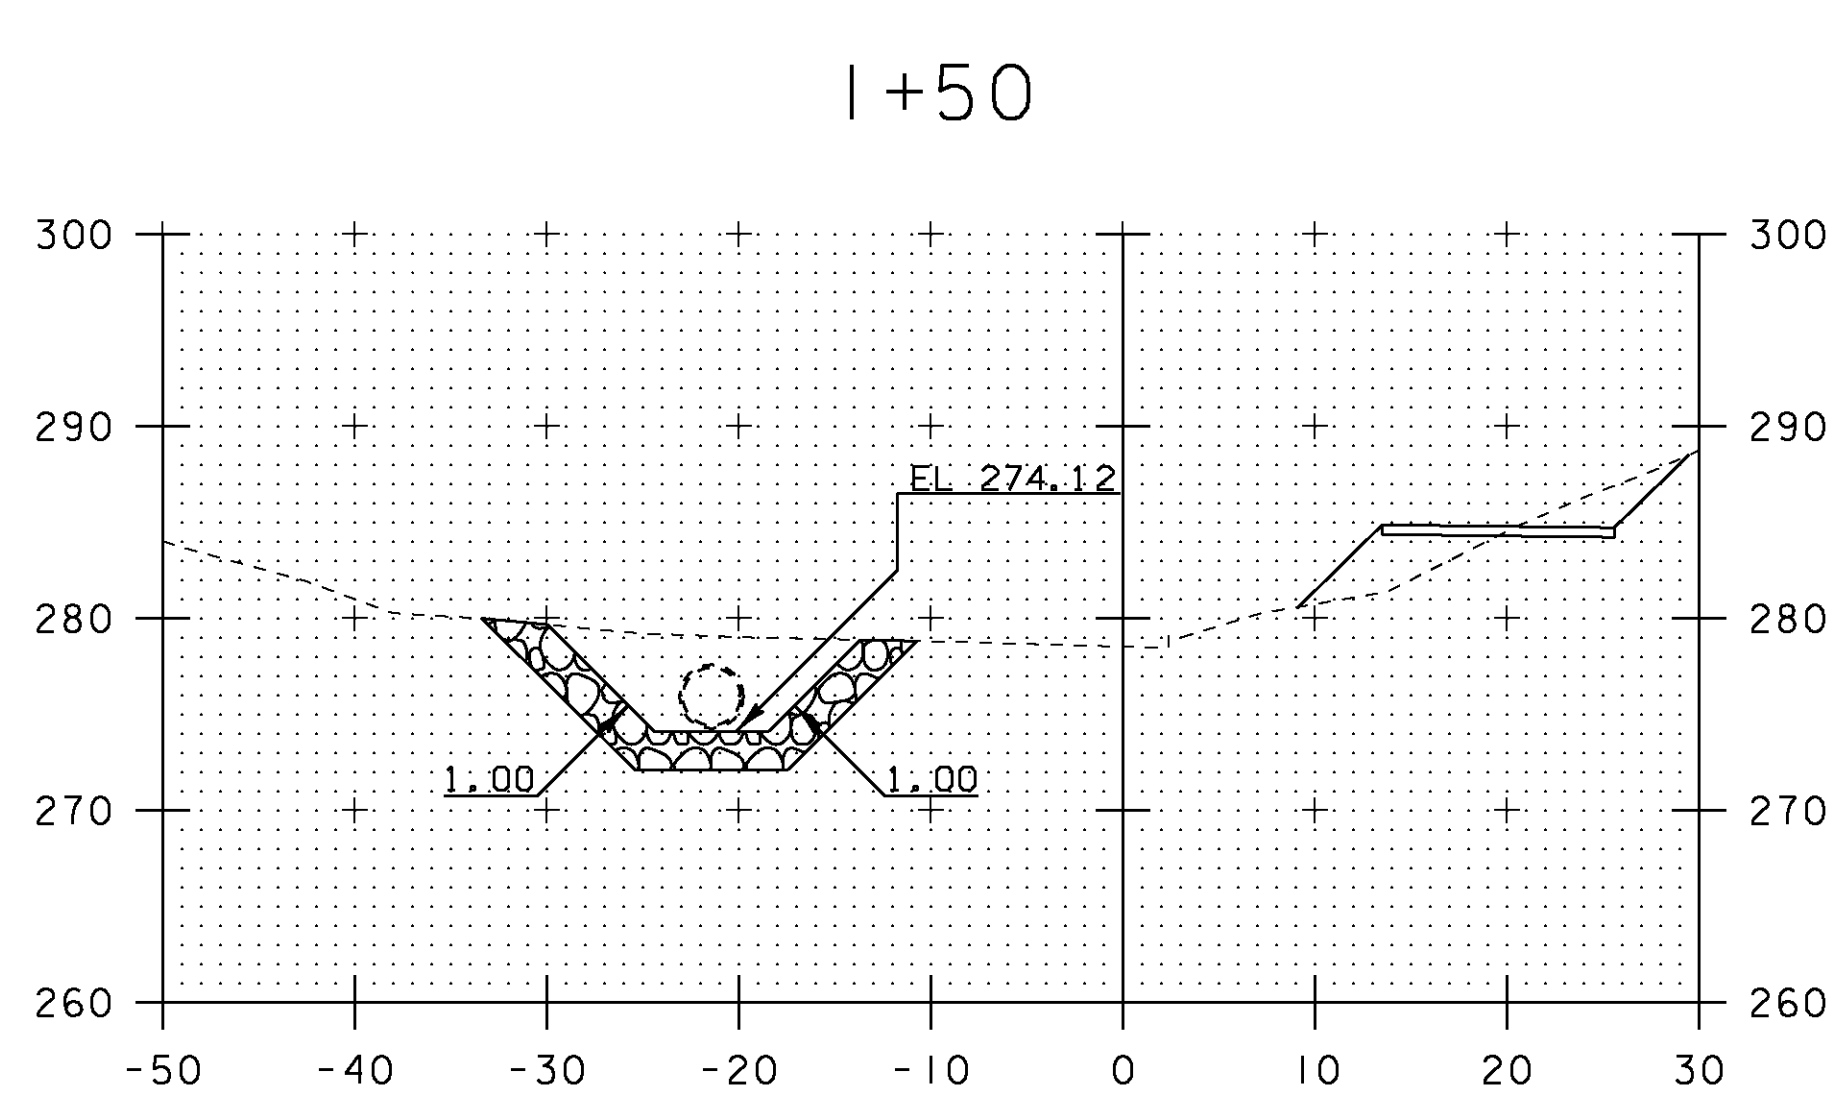

1+00

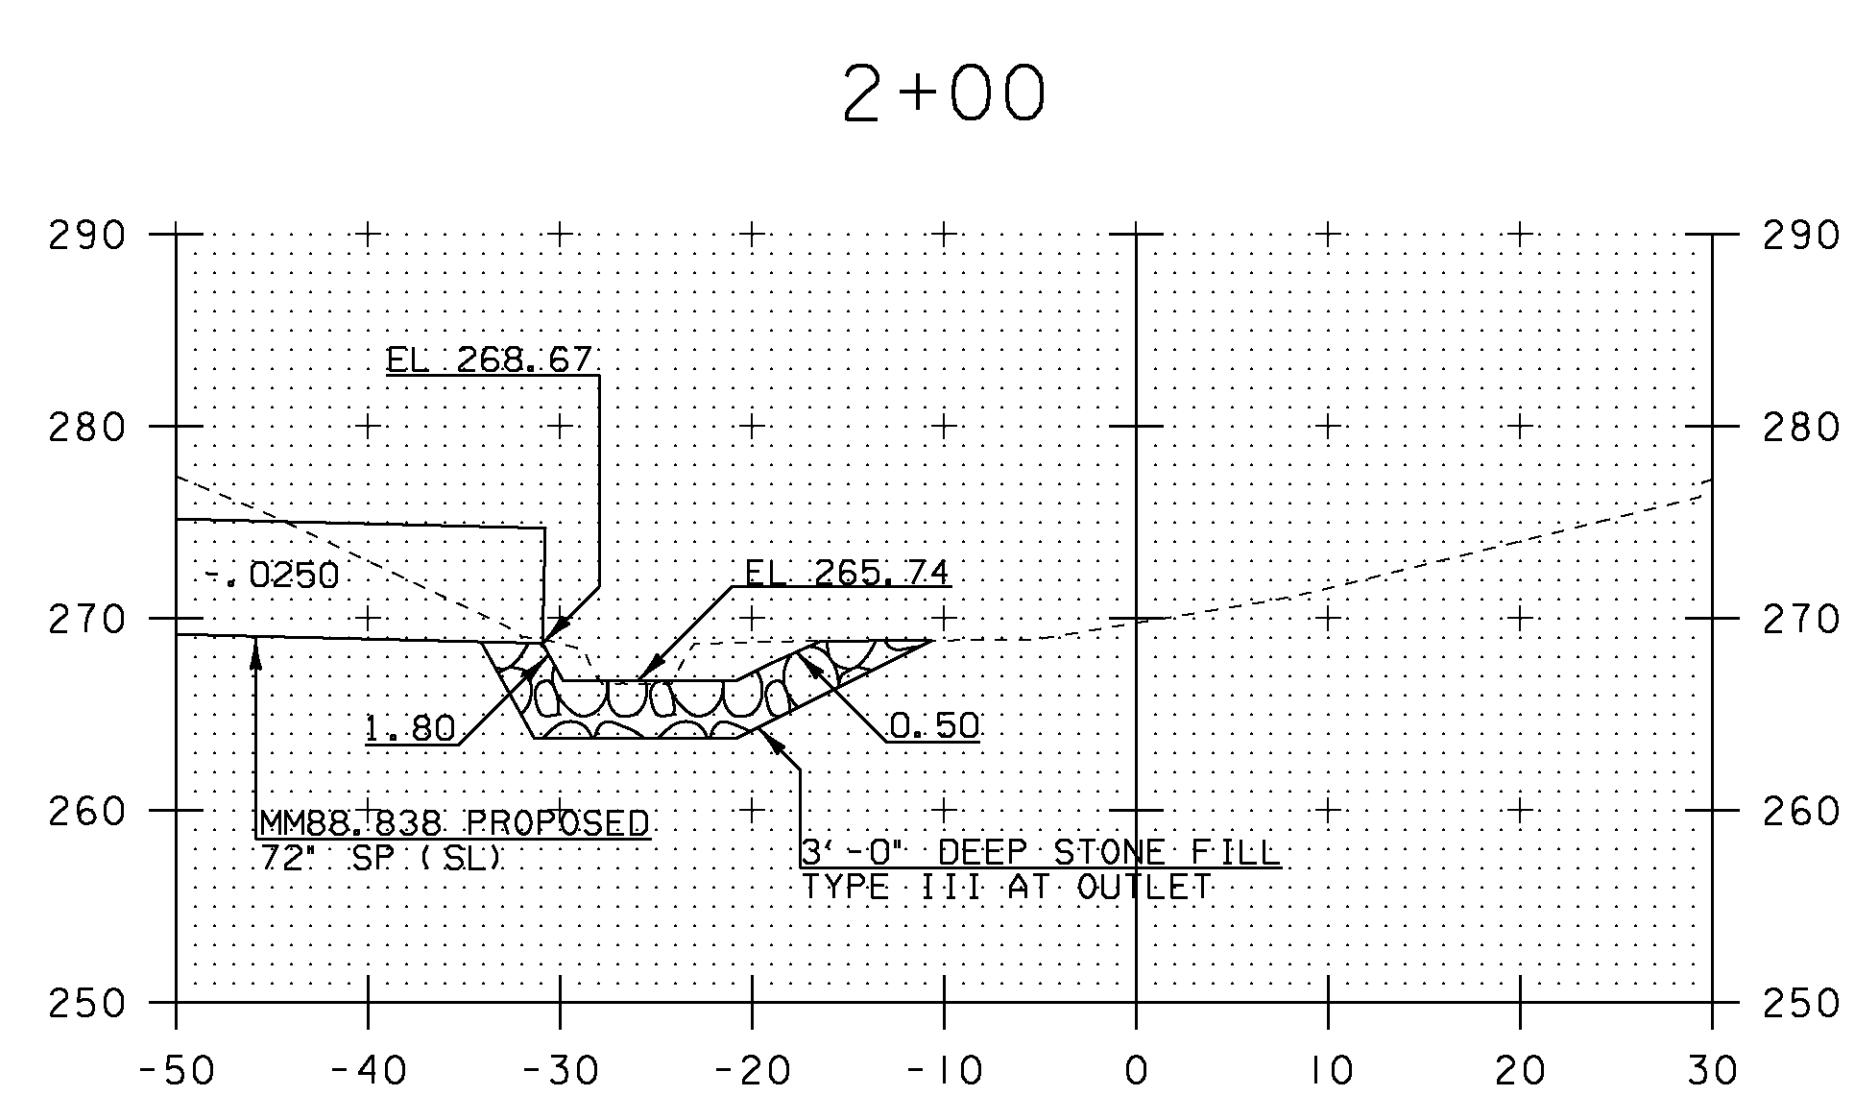

1+85

STA. 0+00 TO STA. 2+00



PROJECT NAME: SOUTH BURLINGTON	PLOT DATE: 13-JAN-2010
PROJECT NUMBER: IM SCRP(3)	DRAWN BY: B. McADAMS
FILE NAME: d07a104_nul.dgn	DESIGNED BY: B. KIPP/B. McADAMS
PROJECT LEADER: K. UPMAL	CHECKED BY: B. KIPP
TRIBUTARY CHANNEL CROSS SECTIONS 1	SHEET 22 OF 69