




2+50

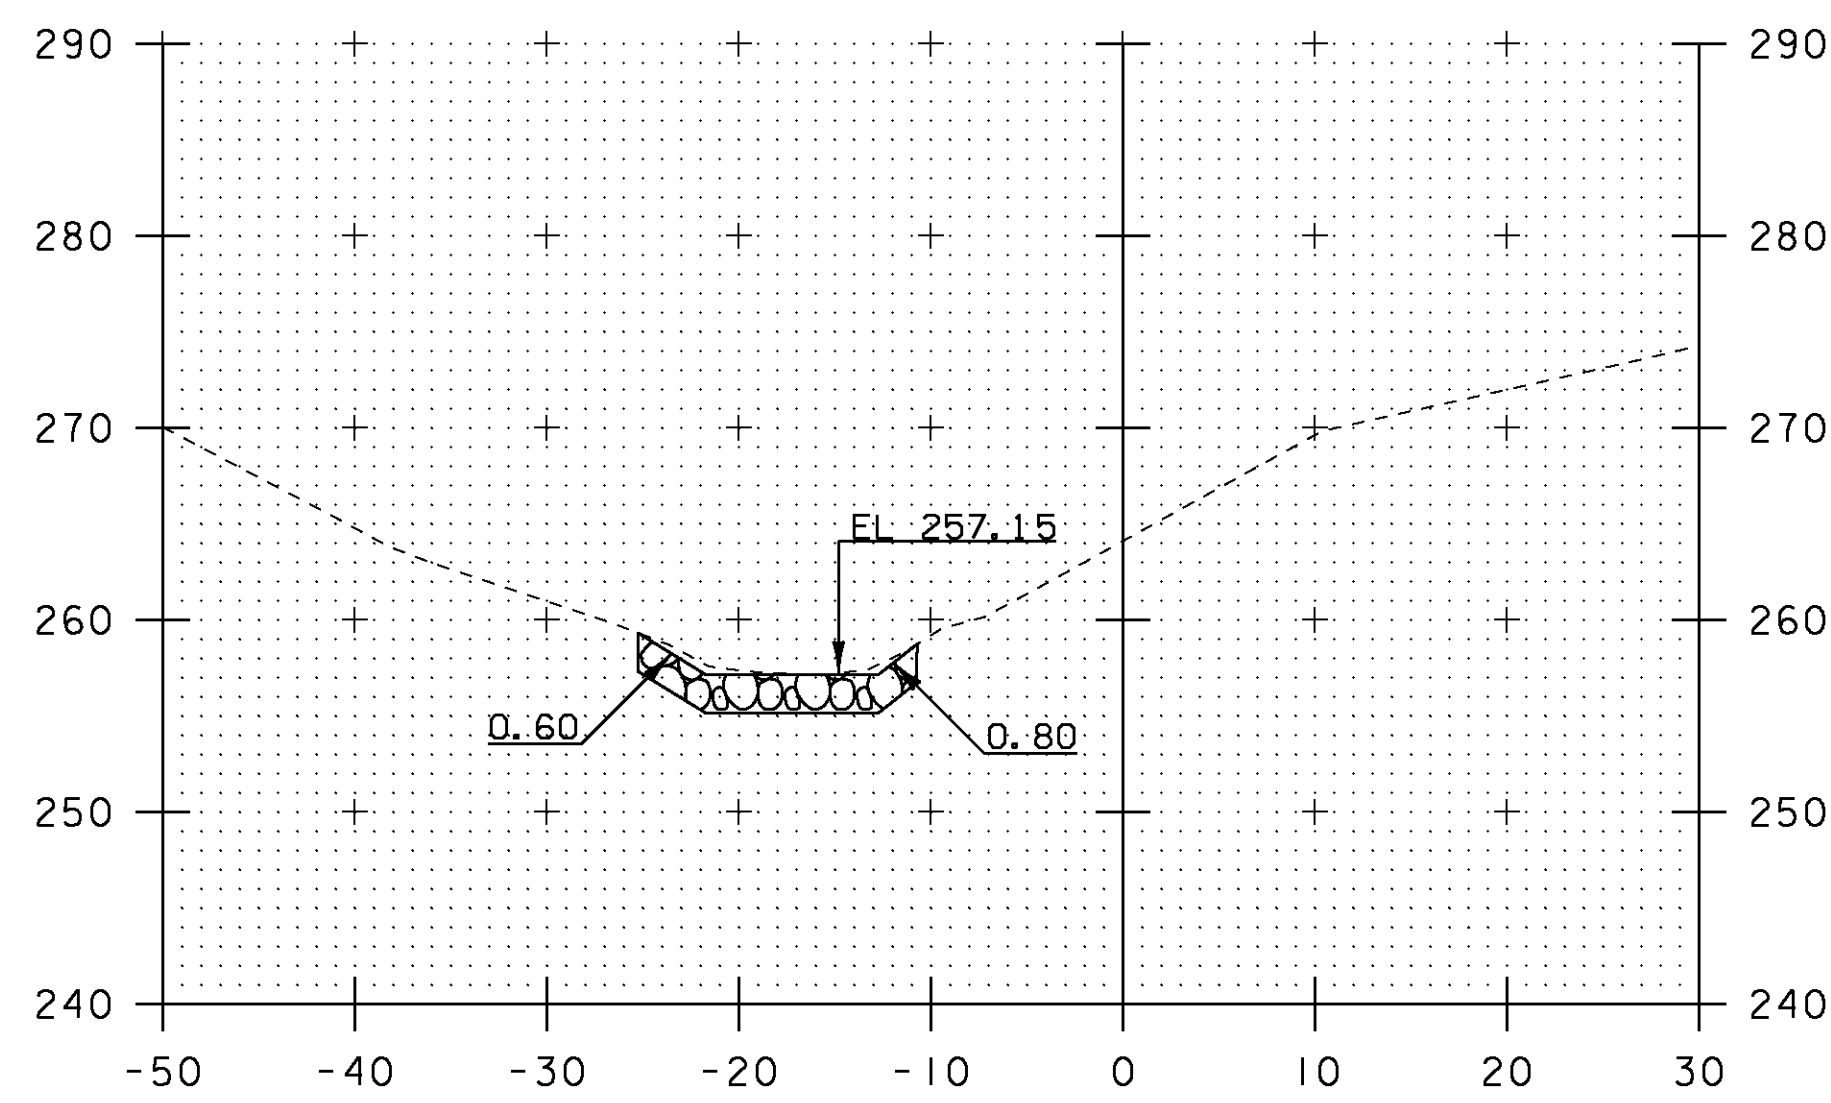


3+00

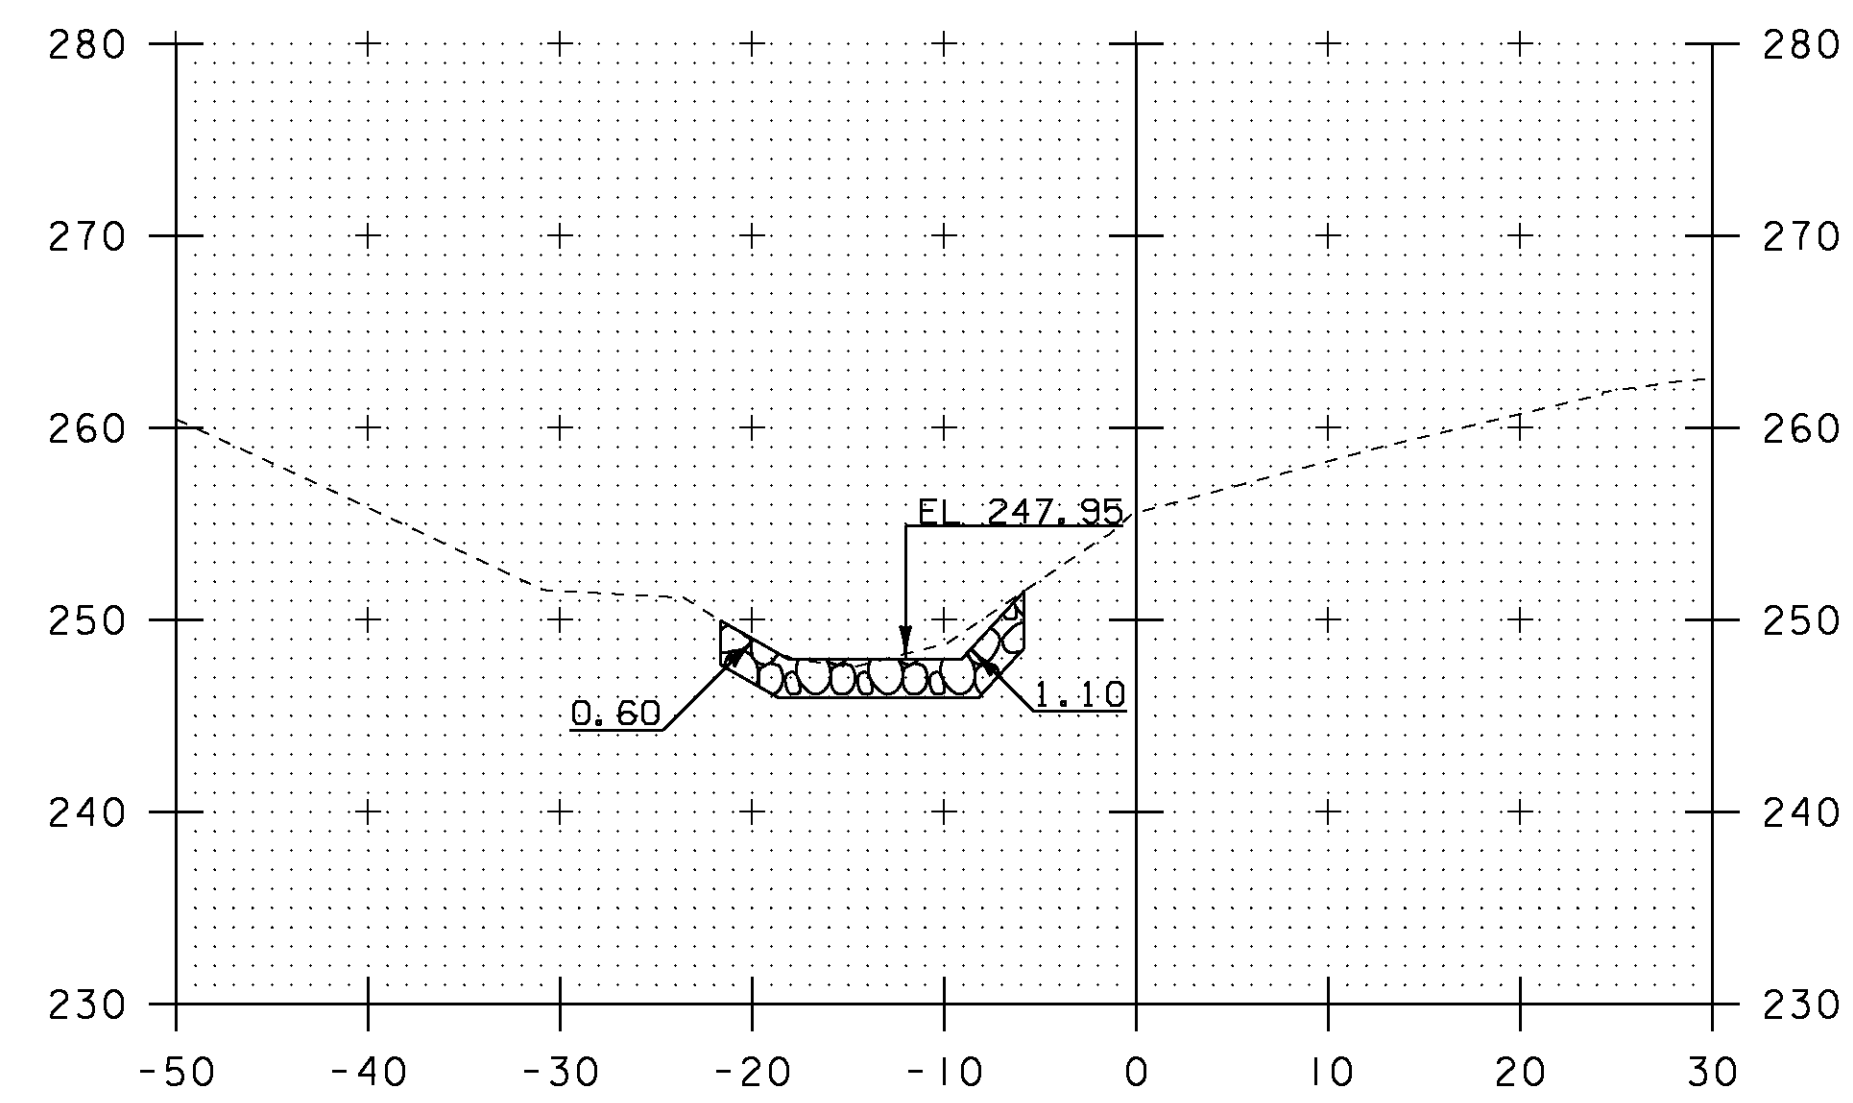


4+00

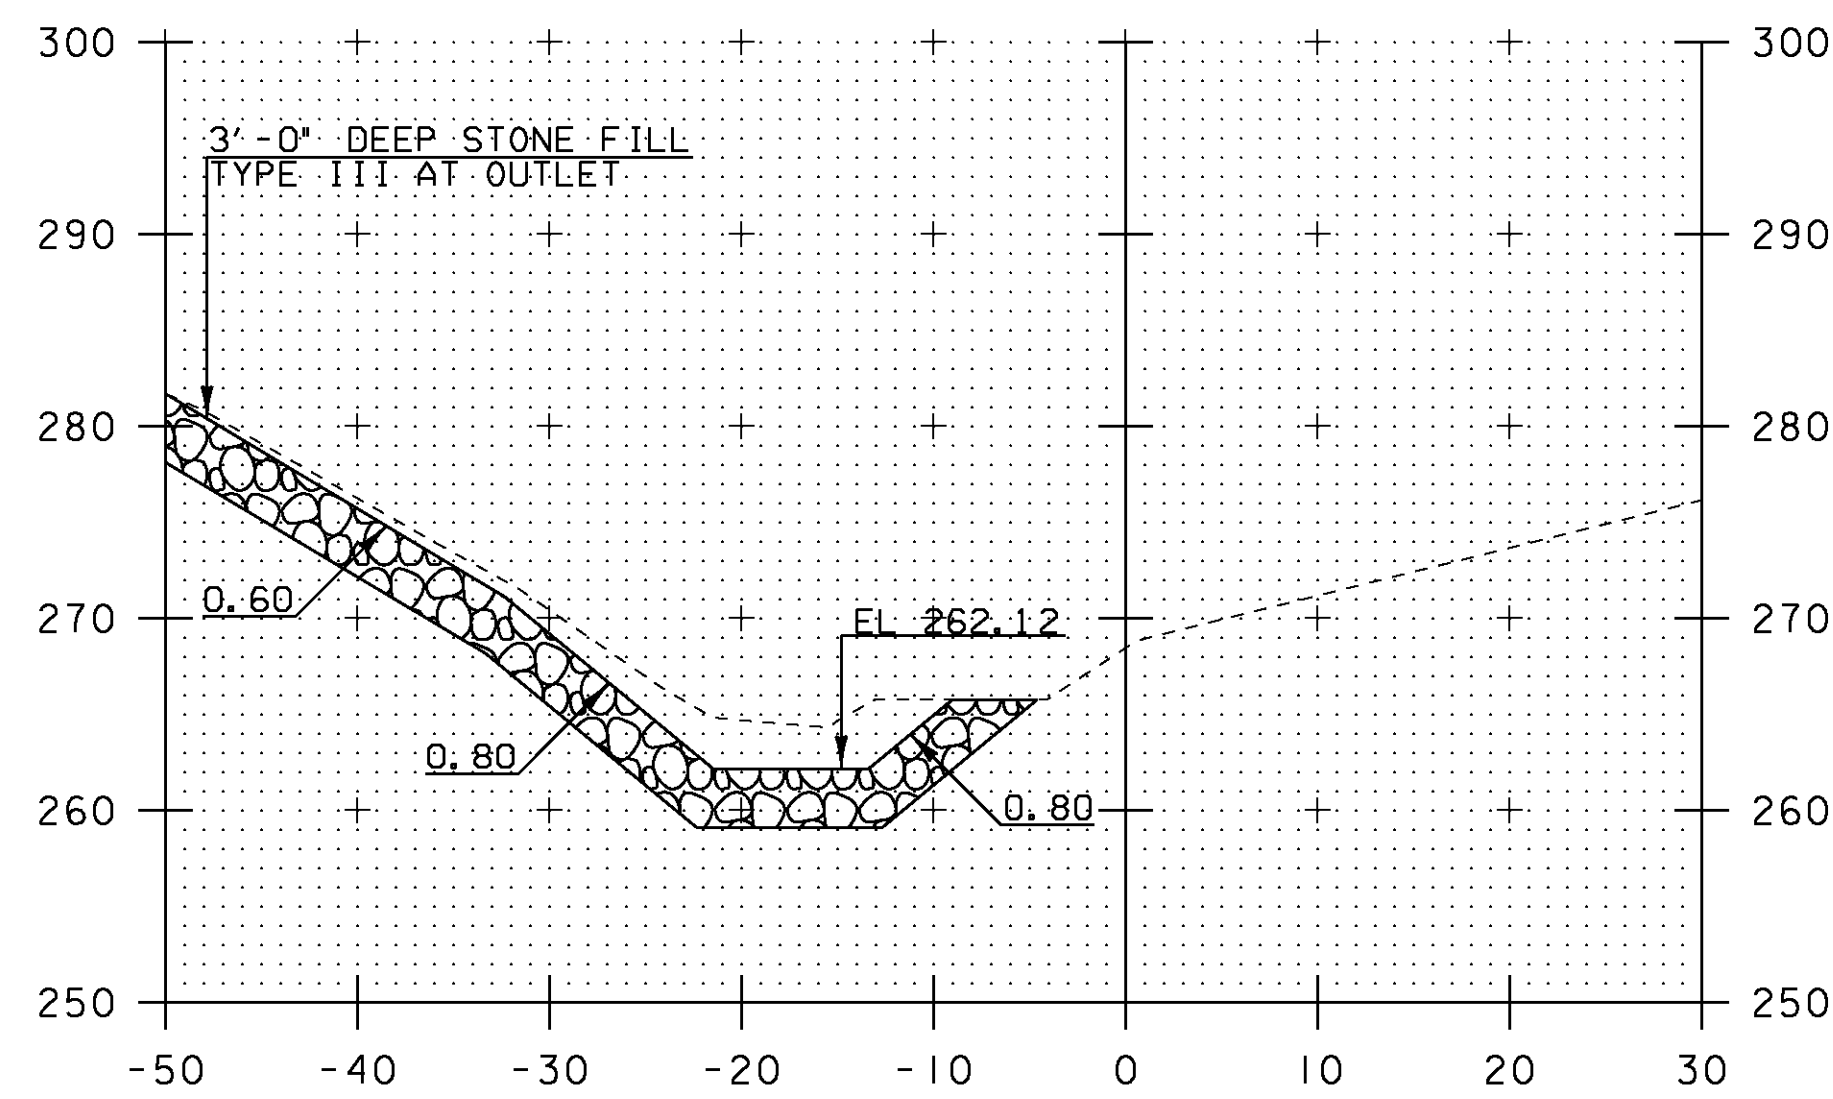

2+14

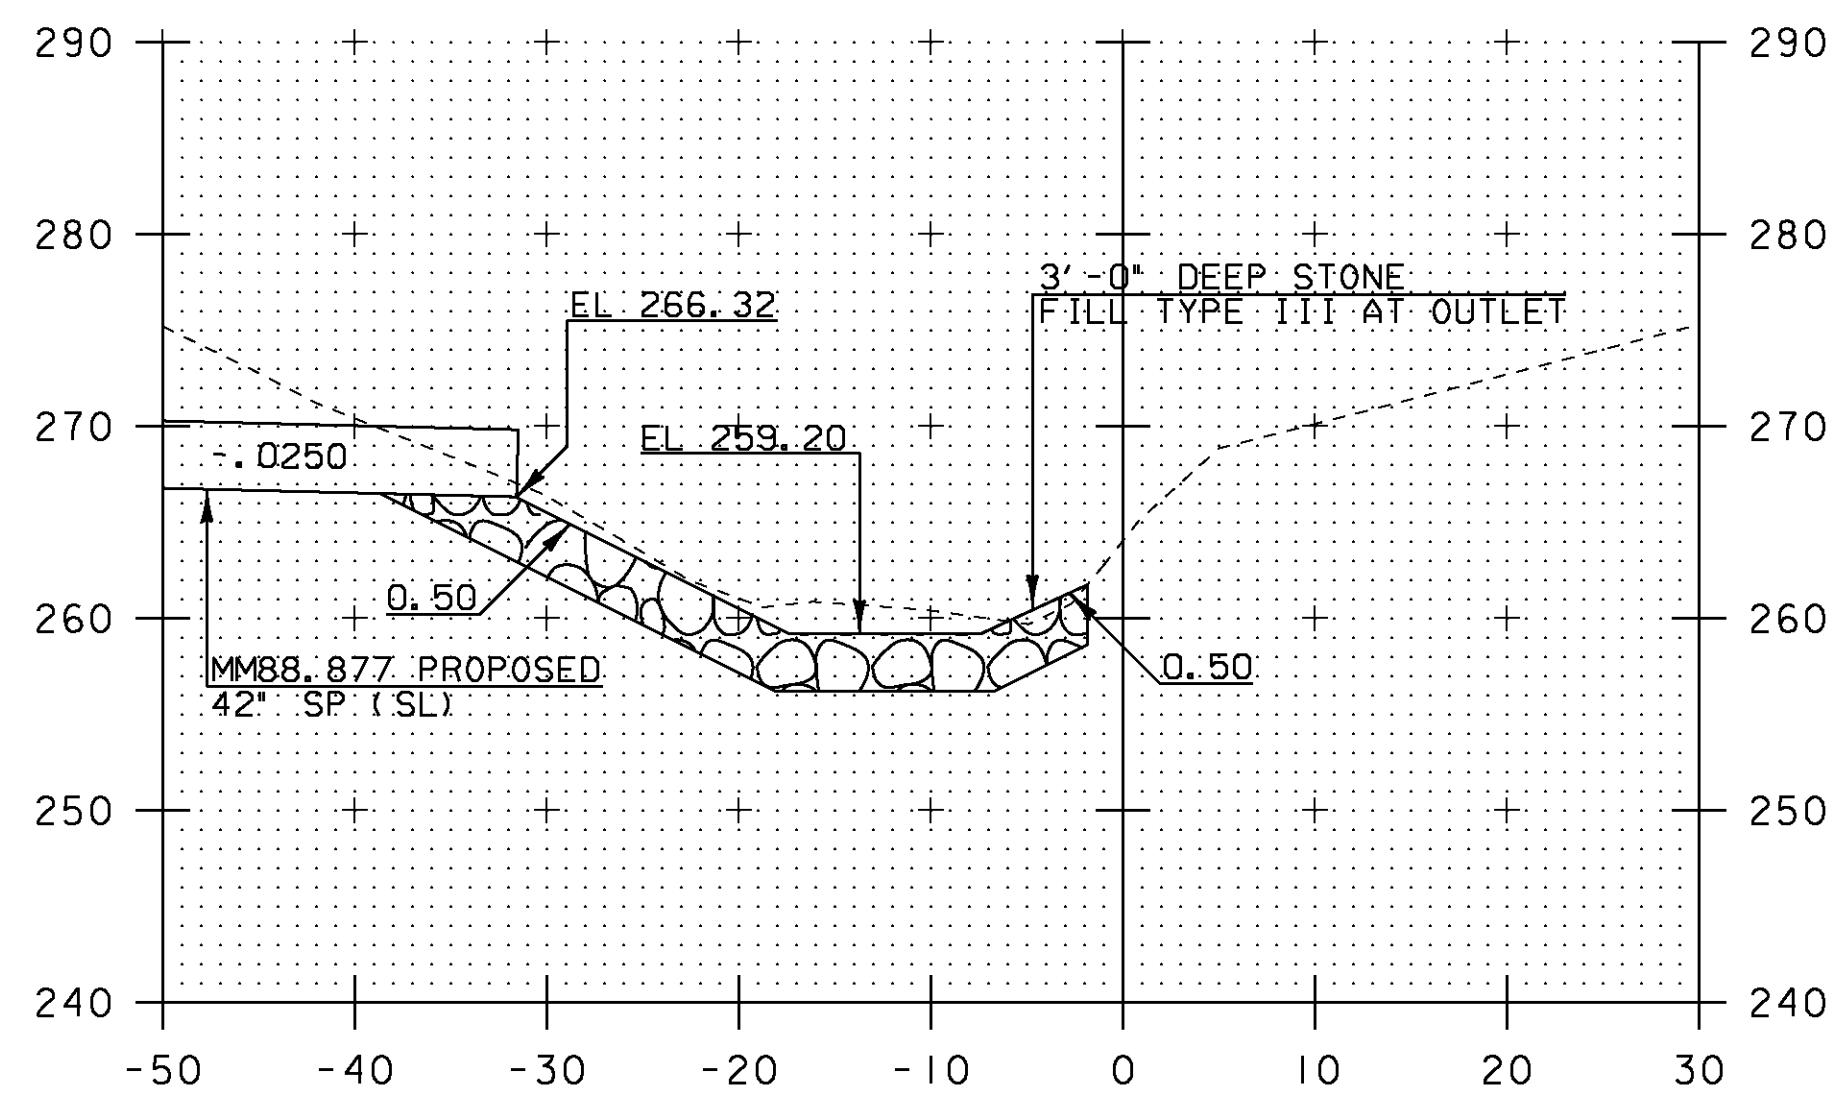


2+74

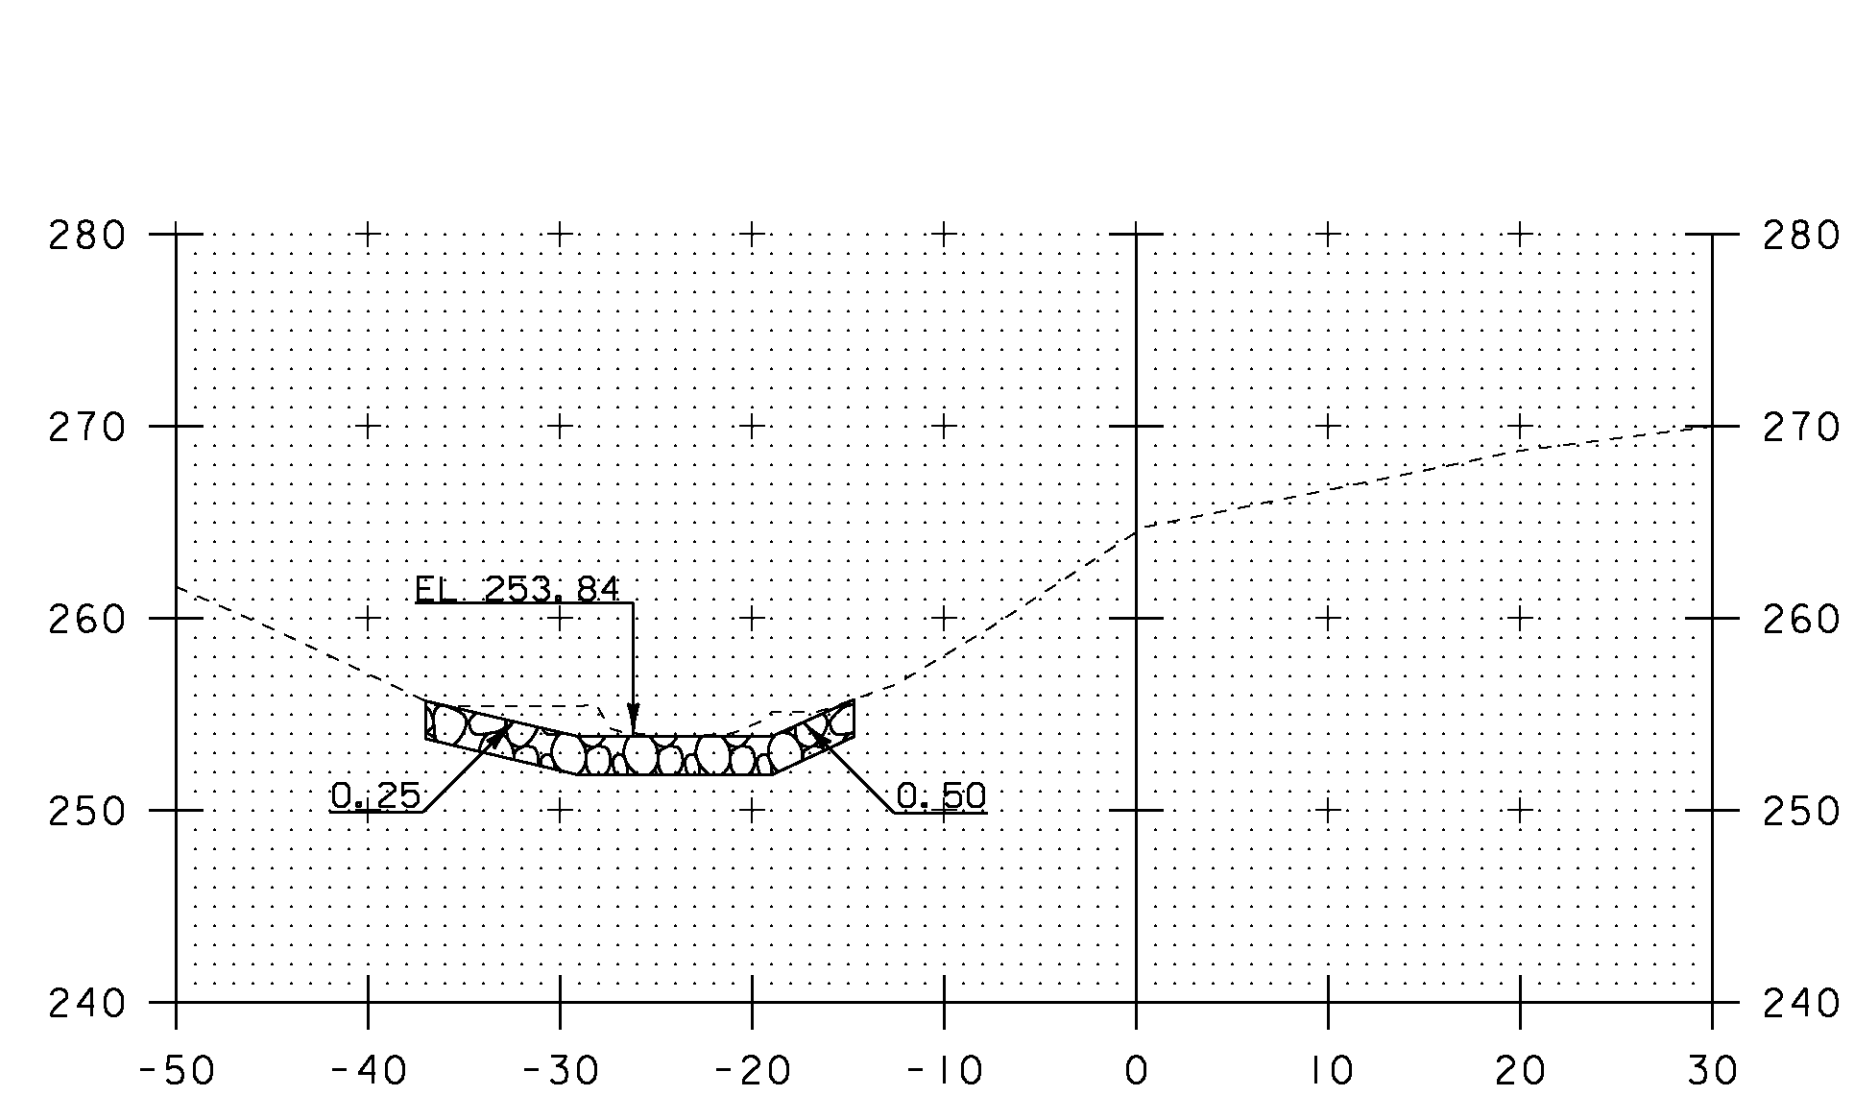

3+50

STA. 2+14 TO STA. 4+00

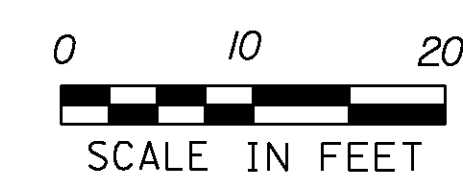

PROJECT NAME: SOUTH BURLINGTON	PLOT DATE: 13-JAN-2010
PROJECT NUMBER: IM SCRP(3)	DRAWN BY: B. McADAMS
FILE NAME: d07a104_nul.dgn	DESIGNED BY: B. KIPP/B. McADAMS
DESIGNED BY: B. KIPP/B. McADAMS	CHECKED BY: B. KIPP
TRIBUTARY CHANNEL CROSS SECTIONS 2	SHEET 23 OF 69