




4+82

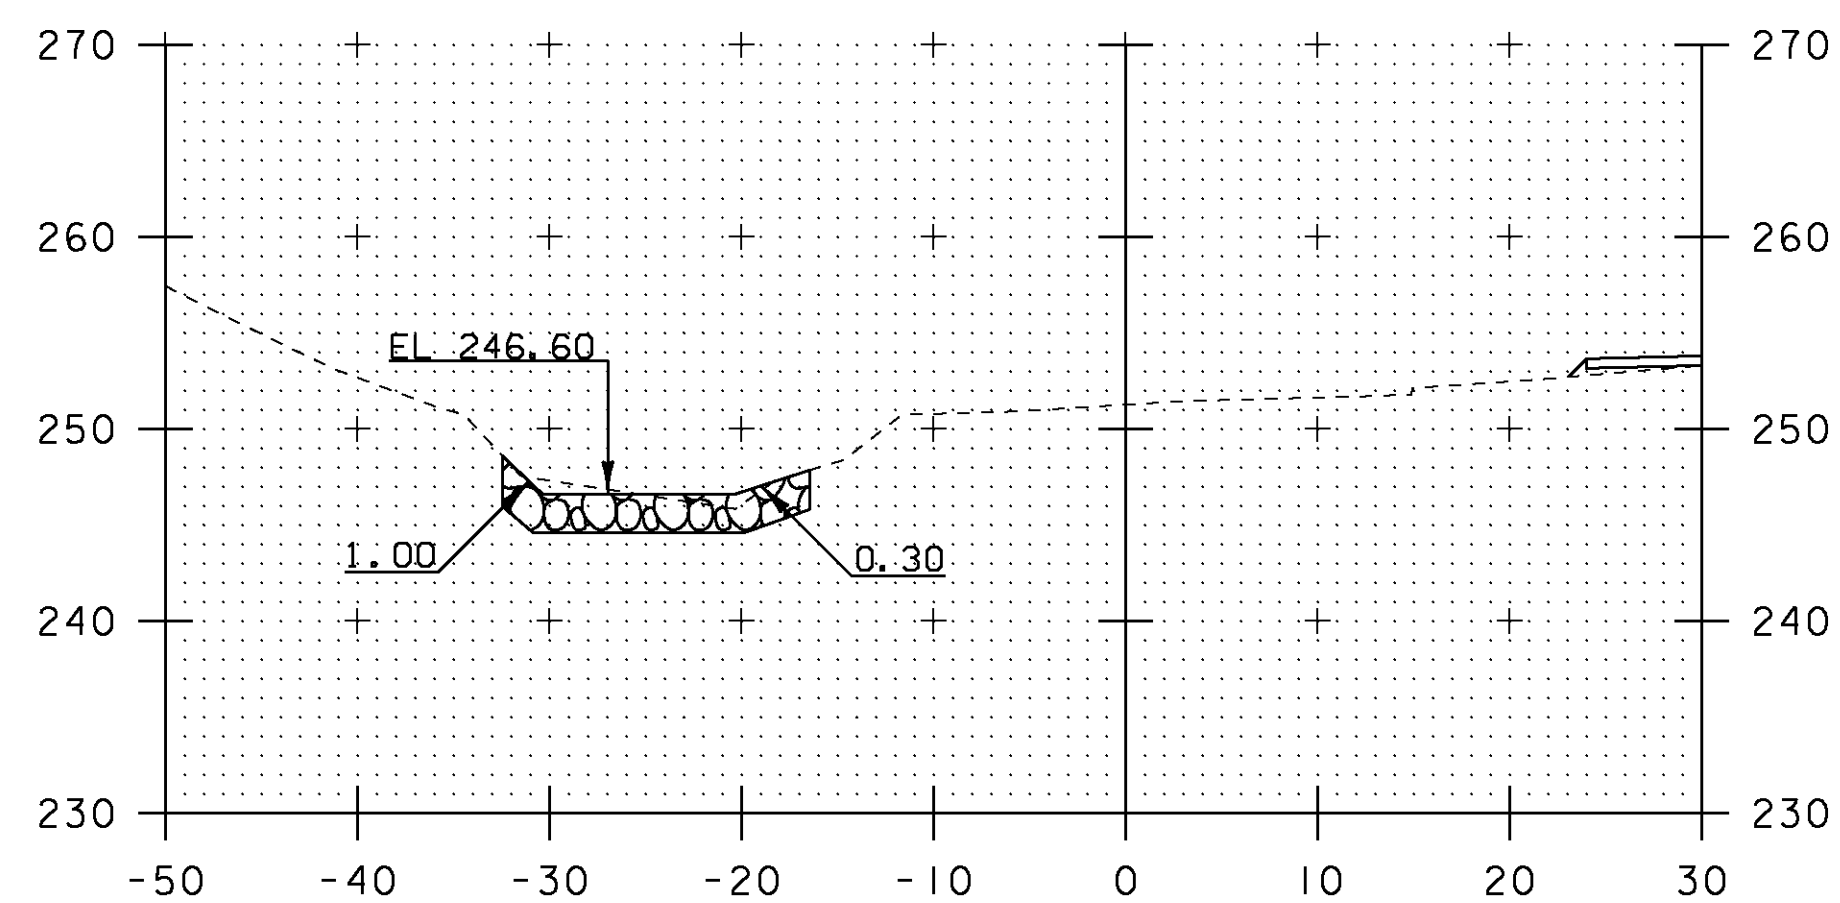


4+50

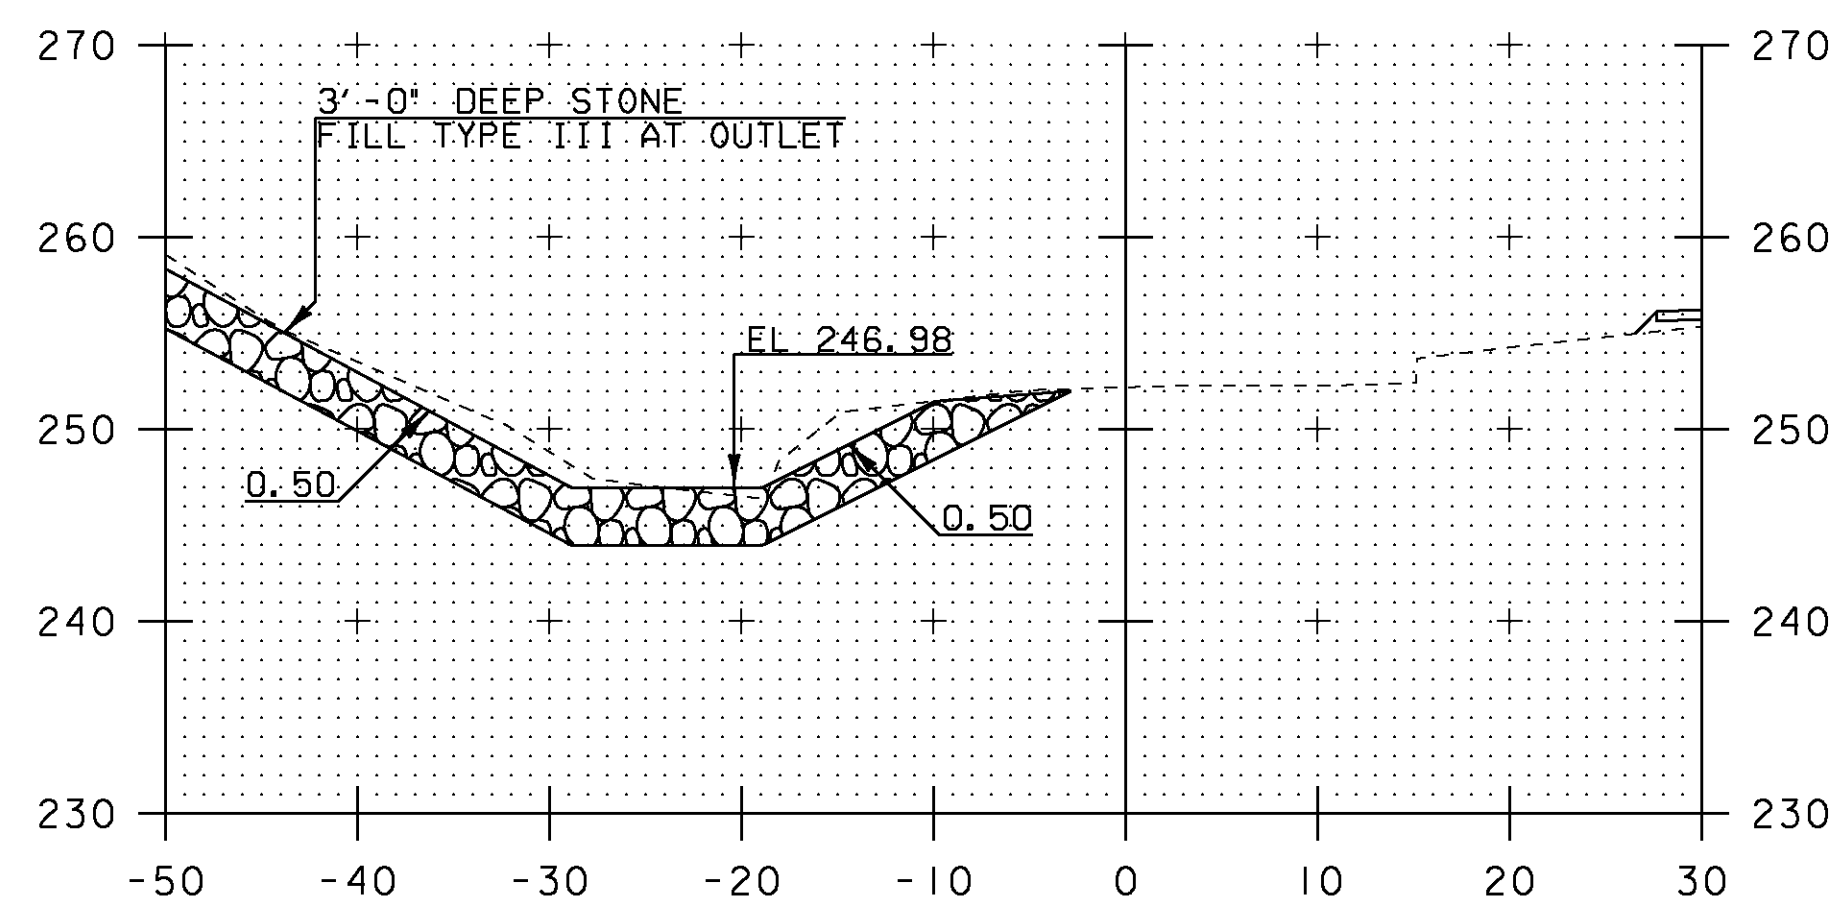


4+32

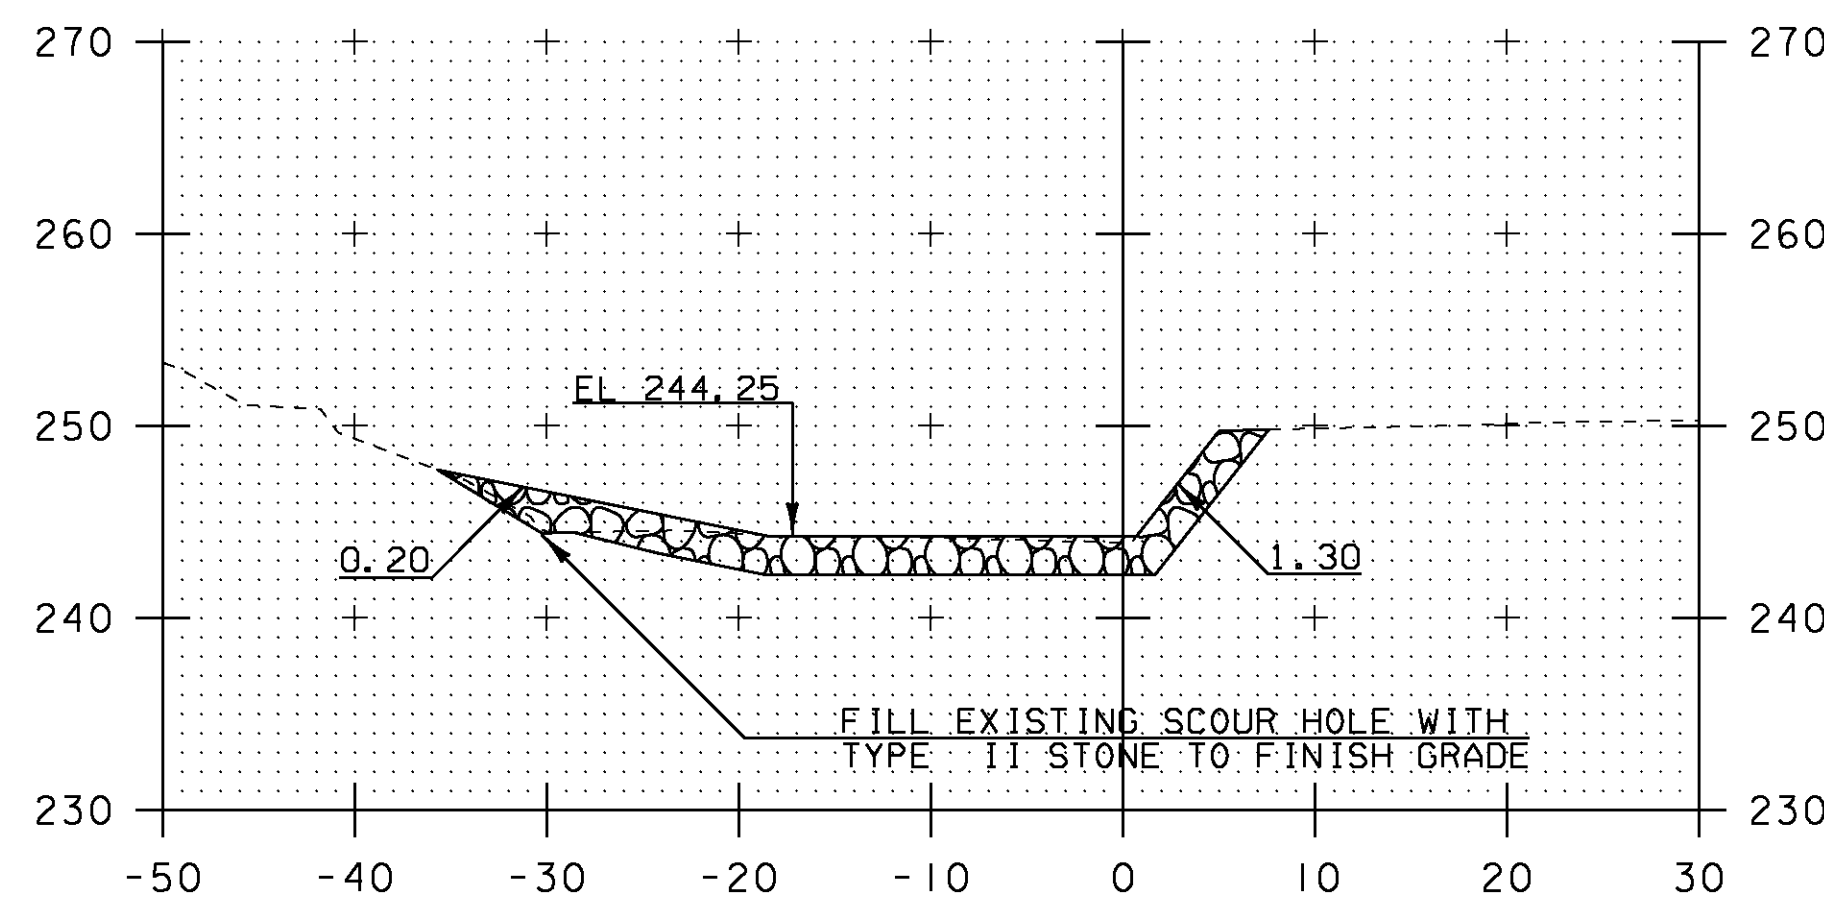


5+25

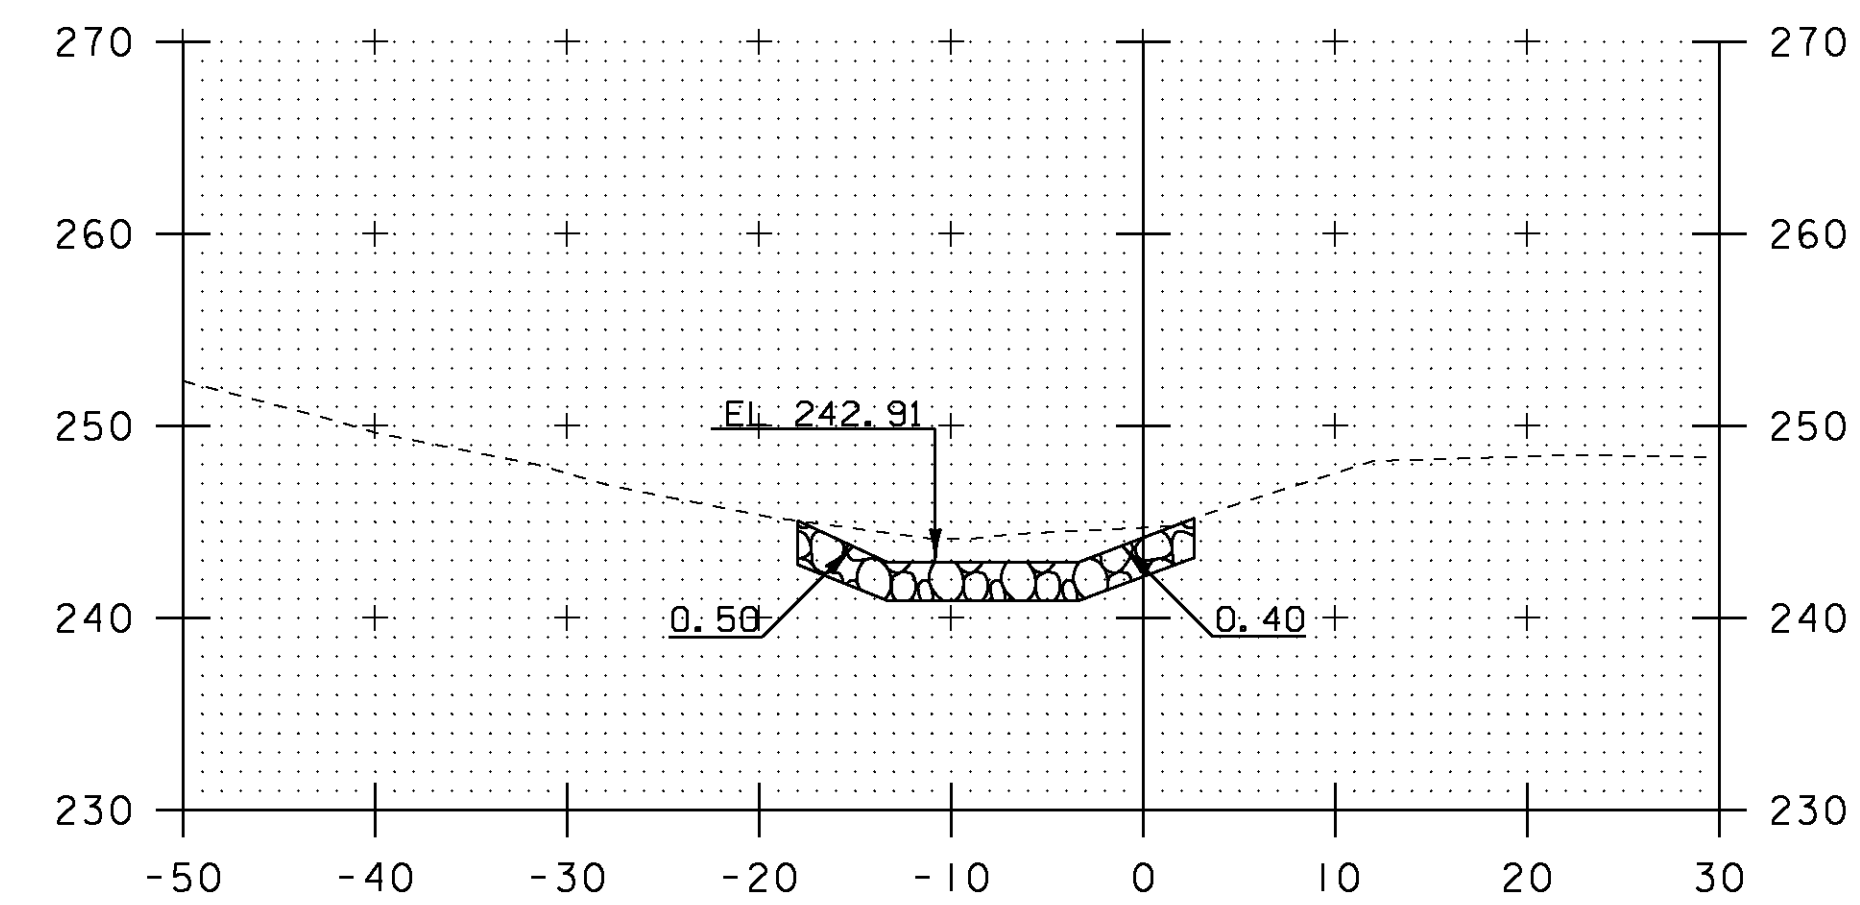

6+00

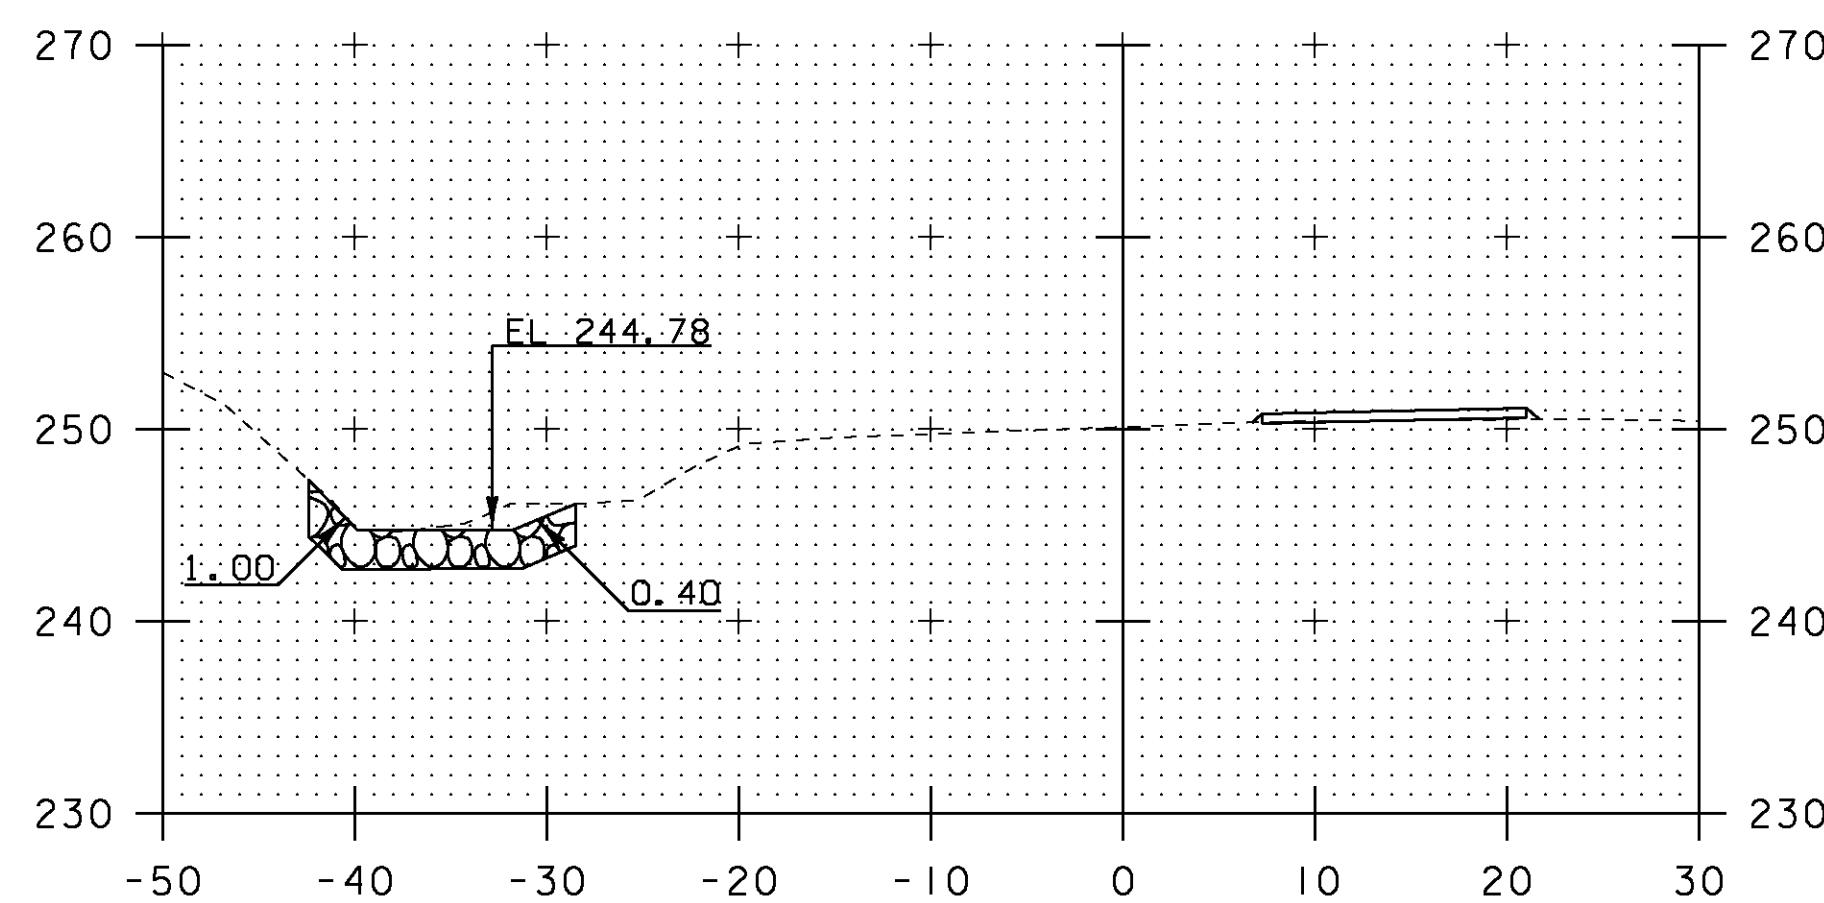


5+00

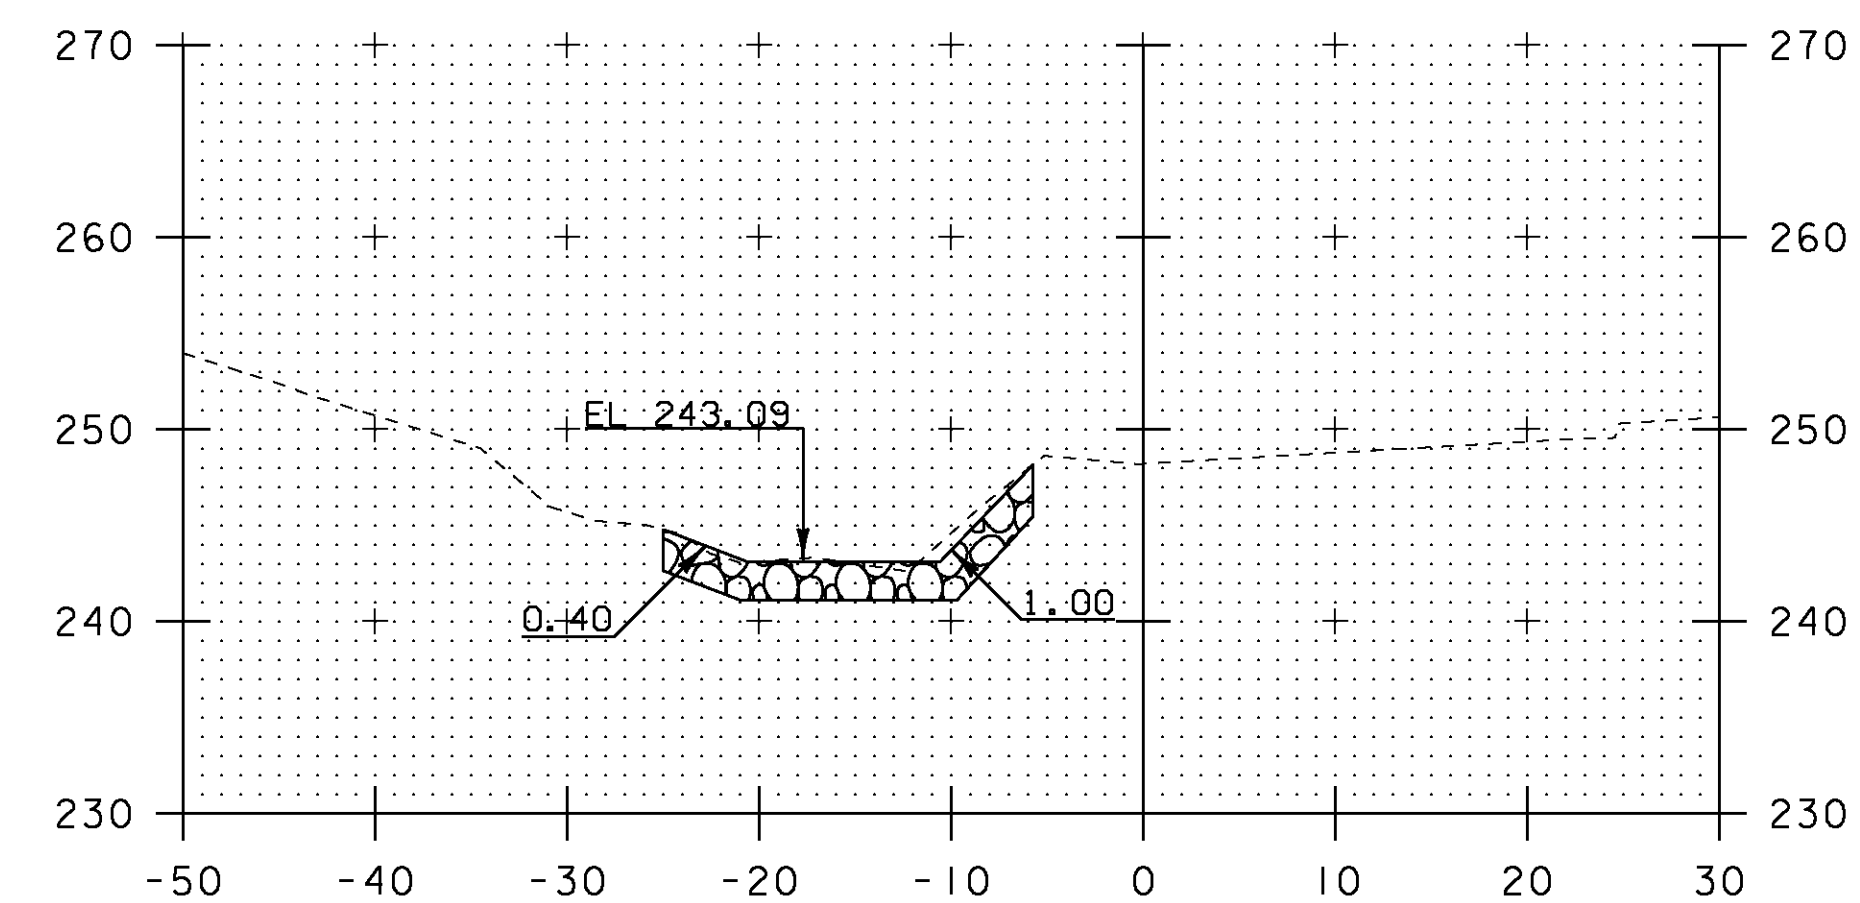

5+50

STA. 4+32 TO STA. 6+00

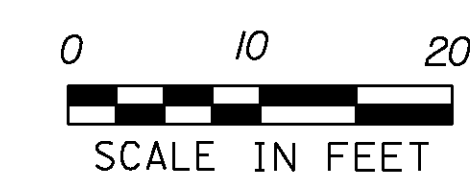

PROJECT NAME: SOUTH BURLINGTON	PLOT DATE: 13-JAN-2010
PROJECT NUMBER: IM SCRP(3)	DRAWN BY: B. McADAMS
FILE NAME: d07a104_nul.dgn	DESIGNED BY: B. KIPP/B. McADAMS
DESIGNED BY: B. KIPP/B. McADAMS	CHECKED BY: B. KIPP
TRIBUTARY CHANNEL CROSS SECTIONS 3	SHEET 24 OF 69