



0+72
INLET

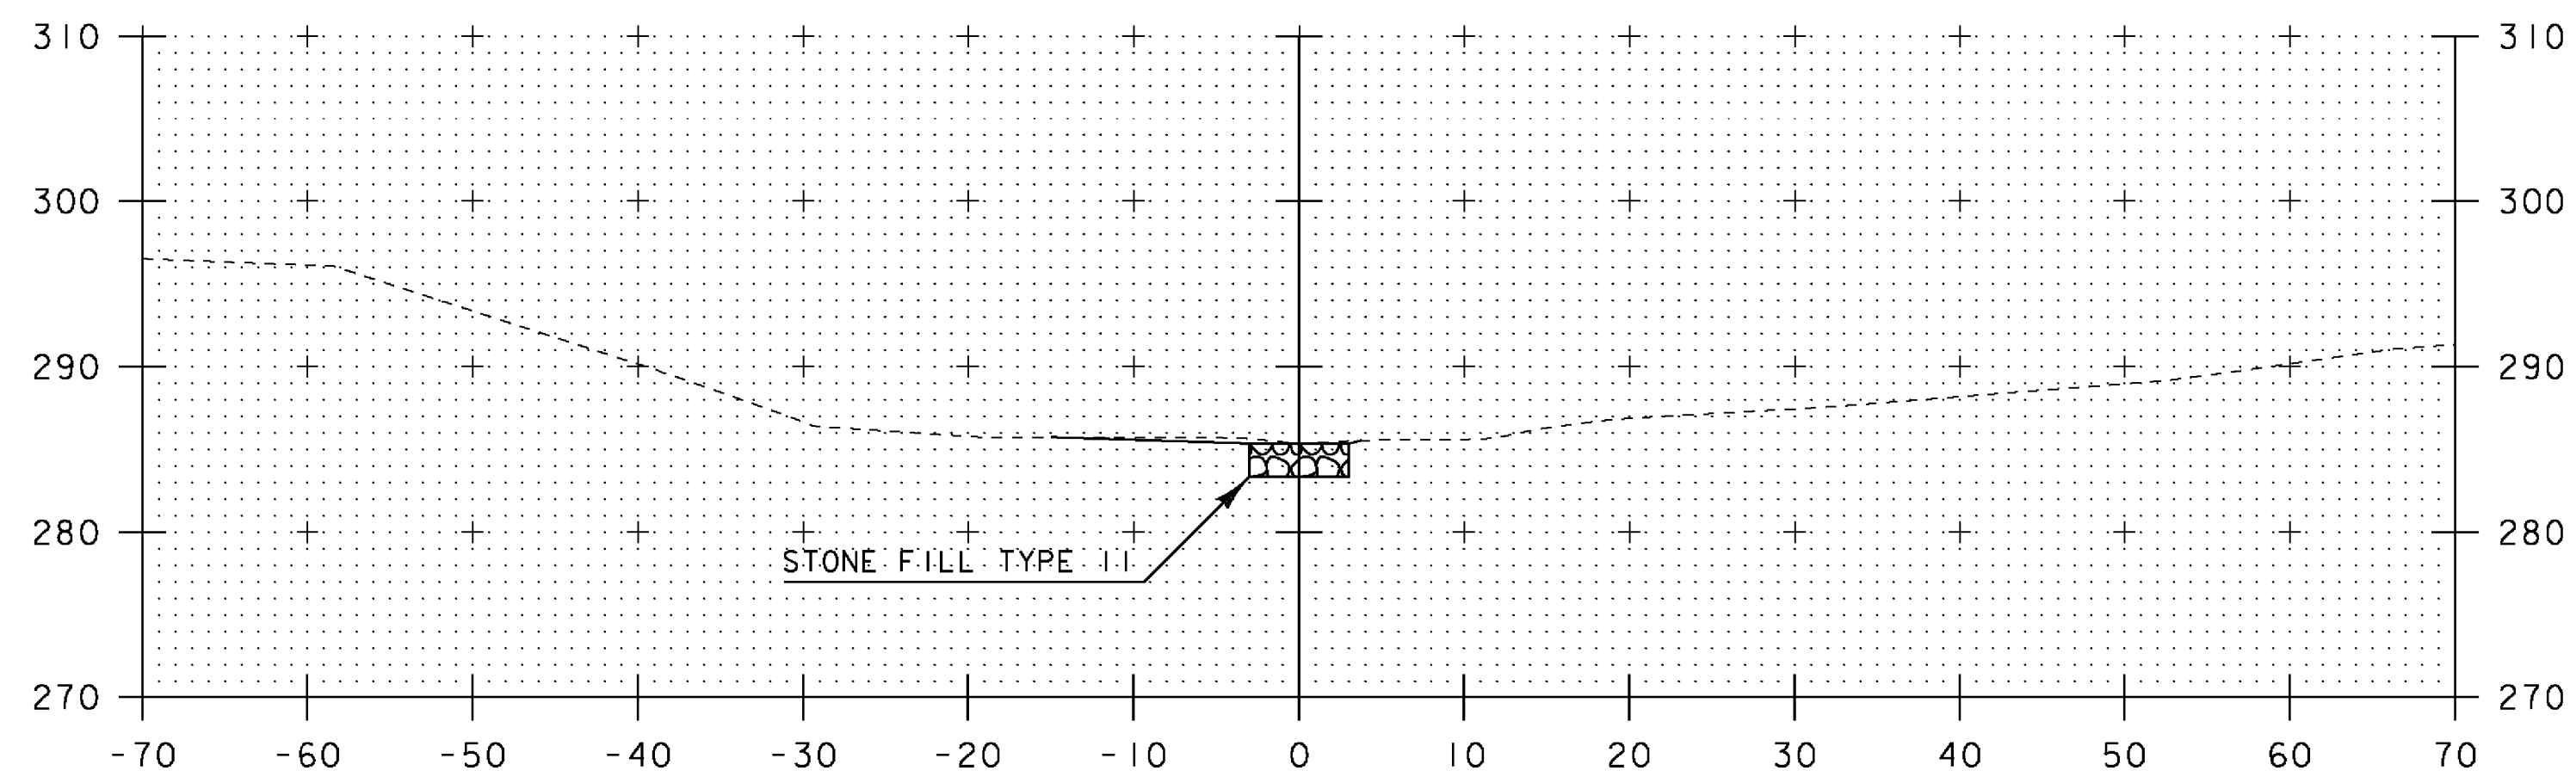

0+48
INLET

INLET - STONE FILL TYPE 11, 2 FT DEPTH AT CHANNEL BOTTOM AND SIDES, 6 FT WIDE

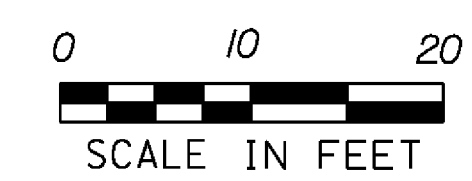

PROJECT NAME: SOUTH BURLINGTON	PLLOT DATE: 13-JAN-2010
PROJECT NUMBER: IM SCRP(3)	DRAWN BY: J. DEVLIN
FILE NAME: d07a104_nul.dgn	CHECKED BY: B. KIPP
PROJECT LEADER: K. UPMAL	SHEET 28 OF 69
DESIGNED BY: B. KIPP/B. McADAMS	
MM 88.787 CHANNEL SECTIONS	