


**MM 88.867 (NB, RAMP H)
CULVERT CENTERLINE
PROFILE**

PROJECT NOTES

- ① EXISTING DI AND 18" ACCGMP SHALL BE ABANDONED AND FILLED WITH FLOWABLE FILL.
- ② 10 FT OF SLOPE EDGING MUST BE REMOVED TO ALLOW SHEET RUNOFF. REMOVAL OF SLOPE EDGING AND ANY WORK ASSOCIATED WITH RESTORING THE EXISTING GROUND SHALL BE INCIDENTAL TO OTHER CONTRACT PAY ITEMS. LOW POINTS OF THE RAMP MUST BE VERIFIED IN THE FIELD BY THE RESIDENT ENGINEER.
- ③ ADJUSTMENT OR TEMPORARY REMOVAL OF GUARDRAIL SHALL BE PAID UNDER 621.75 REMOVE AND RESET GUARDRAIL.

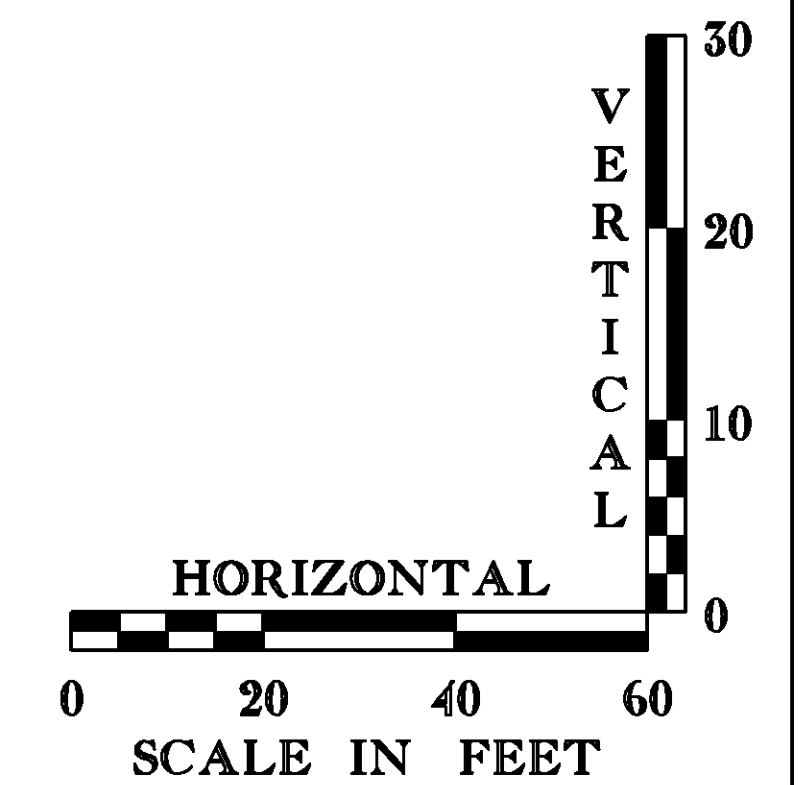

PROJECT NAME:	SOUTH BURLINGTON
PROJECT NUMBER:	IM SCRP(3)
FILE NAME:	d07a104_nul.dgn
PROJECT LEADER:	K. UPMAL
DESIGNED BY:	B. KIPP/B. McADAMS
MM 88.867 PROFILE (NB, RAMP H)	
PLOT DATE:	13-JAN-2010
DRAWN BY:	J. DEVLIN
CHECKED BY:	B. KIPP
SHEET	31 OF 69