


(FIXED)
**SPEED
LIMIT
55**

R2-155
MM 88.43 SOUTHBOUND

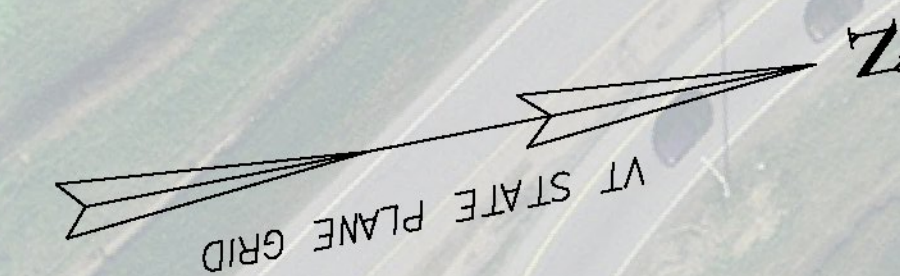

EXIT 14 RAMP A
TO WILLISTON

I-89 SOUTH

I-89 NORTH

EXIT 14 RAMP F
TO BURLINGTON



PROJECT NAME:	SOUTH BURLINGTON	PLOT DATE:	19-JAN-2010
PROJECT NUMBER:	IM SCR(3)	DRAWN BY:	B. KIPP
FILE NAME:	tcnb_bdr.dgn	DESIGNED BY:	B. KIPP/B. MCADAMS
TRAFFIC CONTROL PLAN I-89 SB (2)		CHECKED BY:	B. KIPP
		SHEET	55 OF 69