


SEE SHEET 52 FOR APPROACH SIGNS

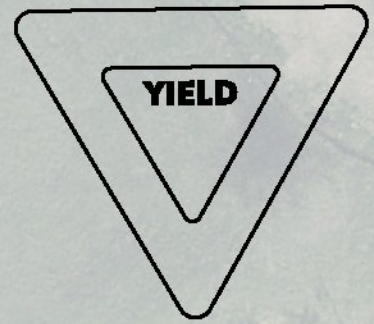

R1-2
MM 88.68 NORTHBOUND


W3-2A
MM 88.65 NB ON-RAMP



(FIXED)
W20-1A
MM 88.70 NB ON-RAMP



(FIXED)
W20-1A
MM 88.70 NB ON-RAMP

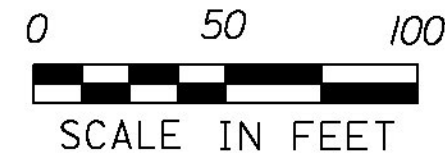

PROJECT NAME:	SOUTH BURLINGTON
PROJECT NUMBER:	IM SCRP(3)
FILE NAME:	88.736BDR.dgn
PROJECT LEADER:	K. UPMAL
DESIGNED BY:	B. KIPP/B. MCADAMS
MM 88.736 TRAFFIC CONTROL PLAN	
PLOT DATE:	19-JAN-2010
DRAWN BY:	B. KIPP
CHECKED BY:	B. KIPP
SHEET	56 OF 69