


CONTINUES ON NEXT SHEET

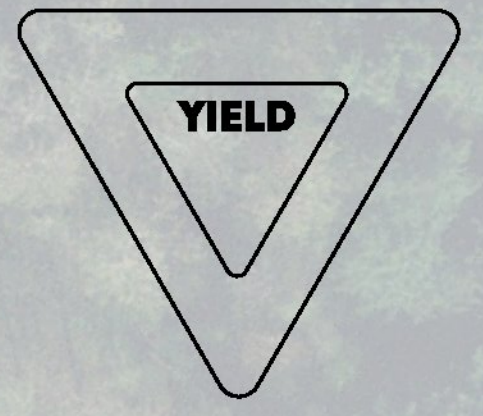

R1-2
(SPACED EVENLY ON RAMP)




(FIXED)
W20-1A
MM 88.70 NB ON-RAMP



E5-1A
MM 88.72 NORTHBOUND



W3-2A
(SPACED EVENLY ON RAMP)

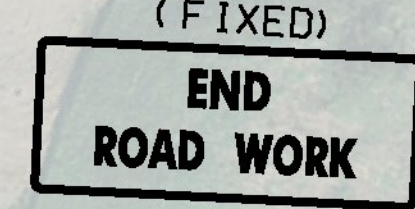

(FIXED)
G20-2A
MM 88.79 NB OFF-RAMP



(FIXED)
W20-1A
MM 88.70 NB ON-RAMP



(FIXED)
G20-2A
MM 88.79 NB OFF-RAMP



PROJECT NAME:	SOUTH BURLINGTON	PLOT DATE:	19-JAN-2010
PROJECT NUMBER:	IM SCR(3)	DRAWN BY:	B. KIPP
FILE NAME:	88.838BDR.dgn	DESIGNED BY:	B. KIPP/B. MCADAMS
		CHECKED BY:	B. KIPP
			SHEET 59 OF 69