


TEMPORARY TRAFFIC BARRIER
(REFLECTIVE TABS REQUIRED
ON OUTSIDE EDGE)



E5-1A
MM 88.94 SOUTHBOUND

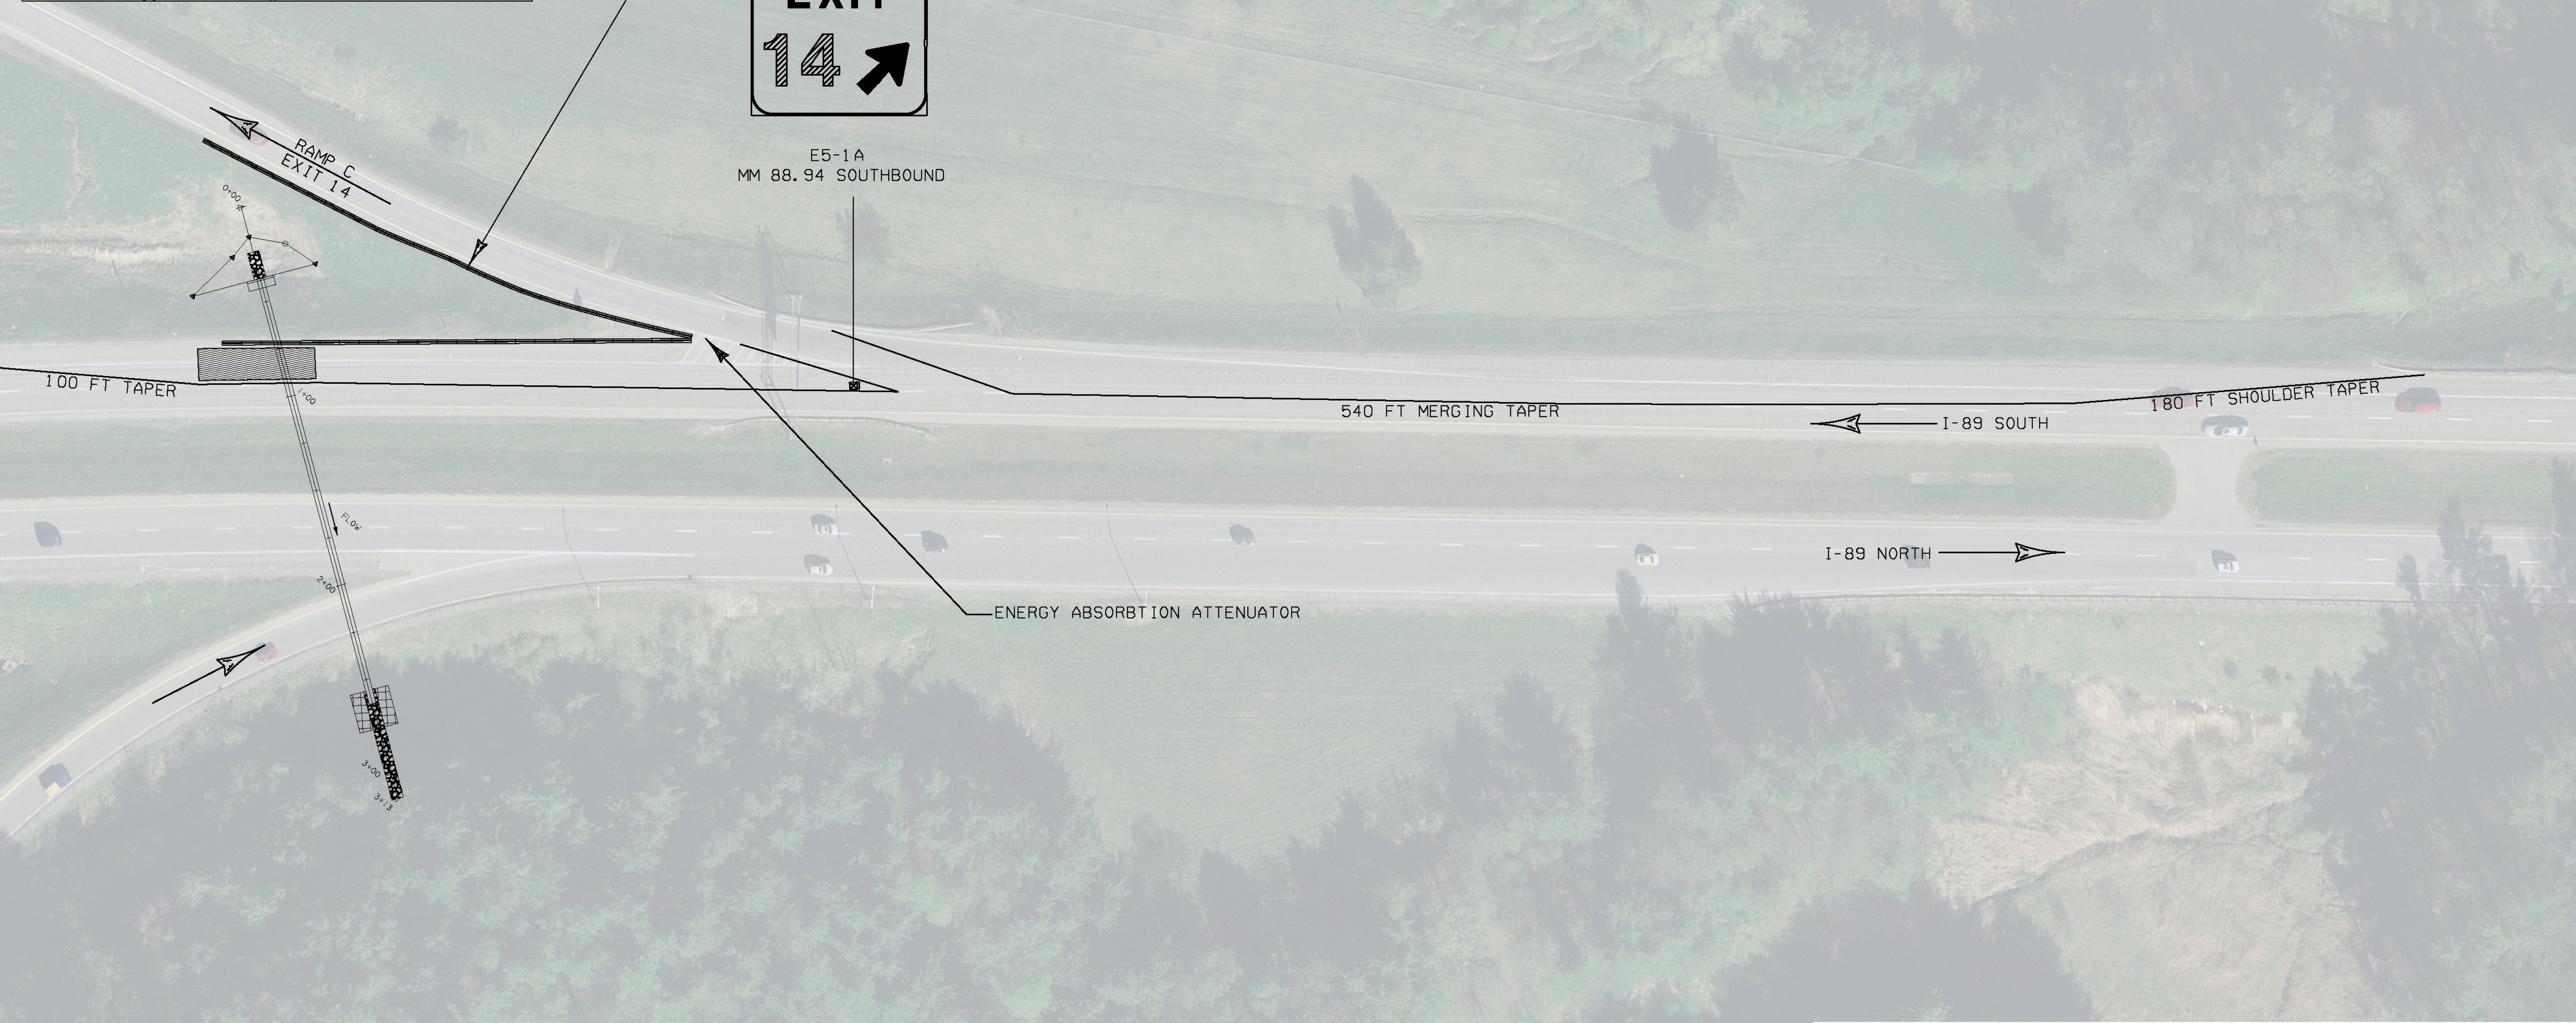

PROJECT NAME:	SOUTH BURLINGTON
PROJECT NUMBER:	IM SCRP(3)
FILE NAME:	88.877BDR.dgn
PROJECT LEADER:	K. UPMAL
DESIGNED BY:	B. KIPP/B. McADAMS
MM 88.877 TRAFFIC CONTROL PLAN	
PLOT DATE:	19-JAN-2010
DRAWN BY:	B. KIPP
CHECKED BY:	B. KIPP
SHEET	61 OF 69