

CONTINUED FROM
PREVIOUS SHEET

TEMPORARY TRAFFIC BARRIER

180 FT SHOULDER TAPER

540 FT TAPER

100 FT TAPER


VT STATE PLANE GRID

EXIT 14
RAMP G

EXIT 14
RAMP H




W3-2A

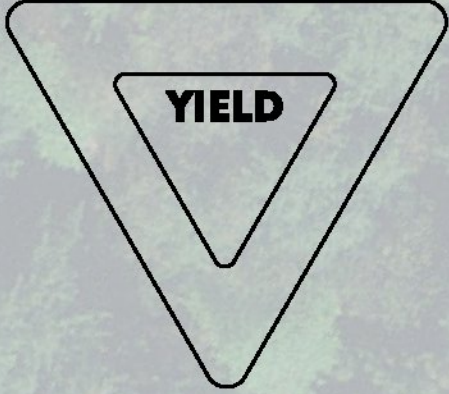

R1-2
MM 88.91 NORTHBOUND

CRASH ATTENUATOR

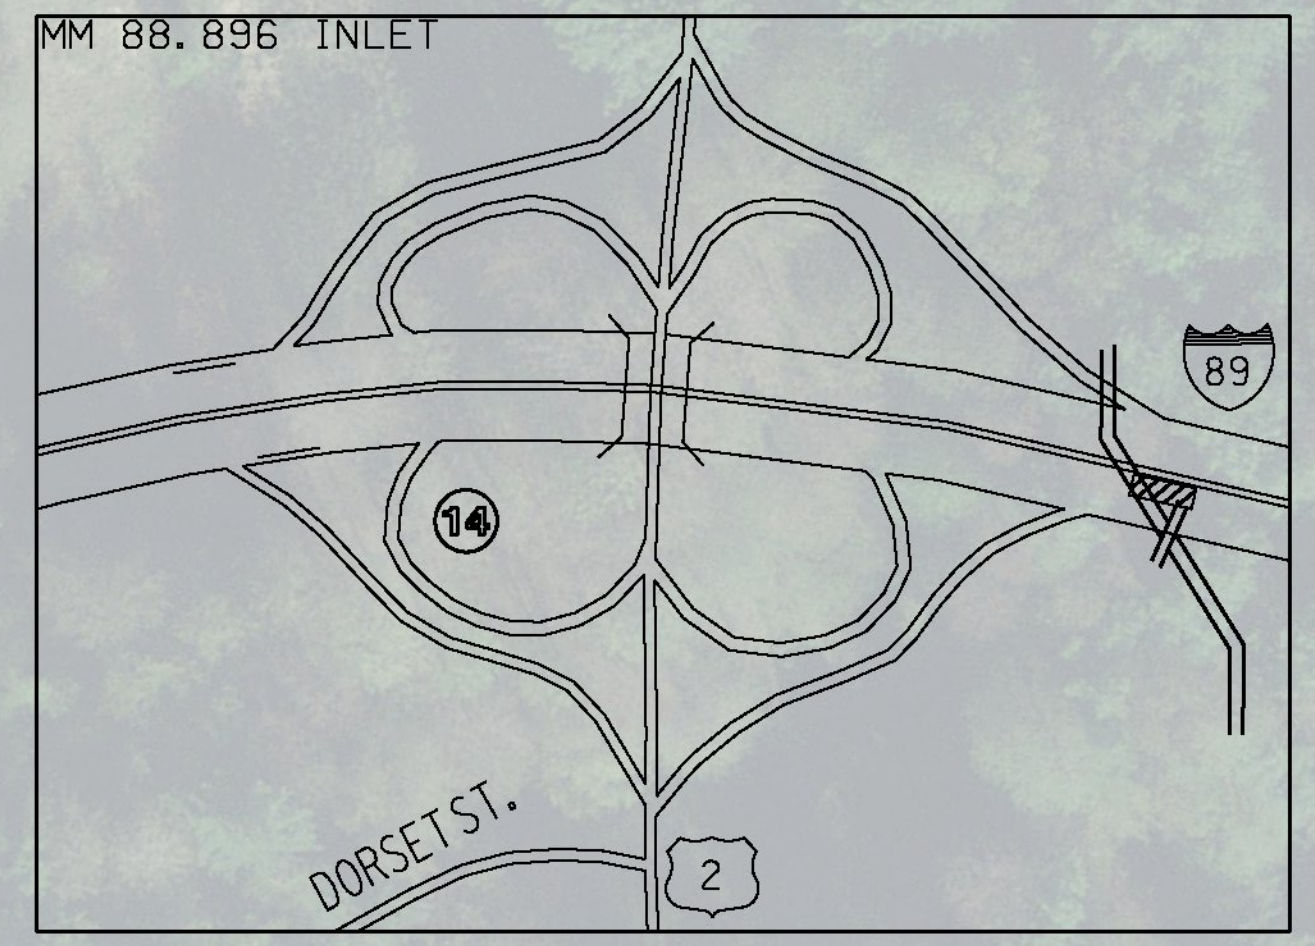

PROJECT NAME:	SOUTH BURLINGTON	PLOT DATE:	19-JAN-2010
PROJECT NUMBER:	IM SCRP(3)	DRAWN BY:	B. KIPP
FILE NAME:	88.896BDR.dgn	CHECKED BY:	B. KIPP
PROJECT LEADER:	K. UPMAL	SHEET	64 OF 69
DESIGNED BY:	B. KIPP		
MM 88.896 TRAFFIC CONTROL PLAN 2			