

INDEX OF SHEETS

1	TITLE SHEET
2	TIE SHEET
3	QUANTITY SHEET
4	LAYOUT PLAN SHEET
5	CULVERT LINING DETAIL
6	CHANNEL SECTIONS
7	HEADWALL DETAIL SHEET
8	FOOTING DETAIL SHEET
9	WINGWALL DETAIL SHEET
10	REINFORCING STEEL SCHEDULE SHEET
11	EPSC NARRATIVE
12	EPSC LAYOUT PLAN SHEET
13	EPSC DETAILS
14-15	TRAFFIC CONTROL PLAN SHEETS
16	TRAFFIC CONTROL GENERAL NOTES
17	TRAFFIC SIGN DETAIL SHEET

STANDARDS


D-30	08/13/2007
E-100	01/02/2004
E-100A	01/02/2004
E-101	05/30/2003
E-102	06/30/2003
E-102A	05/01/2004
E-103	03/01/2004
E-105	05/01/2004
E-107A	08/08/1995
E-121	08/08/1995
E-142	09/20/1995
G-1	01/03/2000

RECORD PLANS	
CONTRACTOR:	FW WHITCOMB CONSTRUCTION CORP. - WALPOLE, NH
RESIDENT ENGINEER:	AL JONES
CONSTRUCTION BEGAN:	OCTOBER 23, 2008
CONSTRUCTION COMPLETE:	May 22, 2009
RECORD PLANS BY:	AL JONES
I HEREBY CERTIFY THAT ALL THE CONSTRUCTION REQUIRED BY THIS SET OF DRAWINGS HAS BEEN ACCOMPLISHED AS INDICATED HEREIN.	
BY	<i>Al Jones</i> RESIDENT ENGINEER
DATE	4/15/10
NOTE: Any further information concerning final quantities, amounts or other details relative to this project may be found at Central Files in the electronic archives.	

STATE OF VERMONT AGENCY OF TRANSPORTATION




PROPOSED IMPROVEMENT TOWN OF ROCKINGHAM COUNTY OF WINDHAM INTERSTATE 91

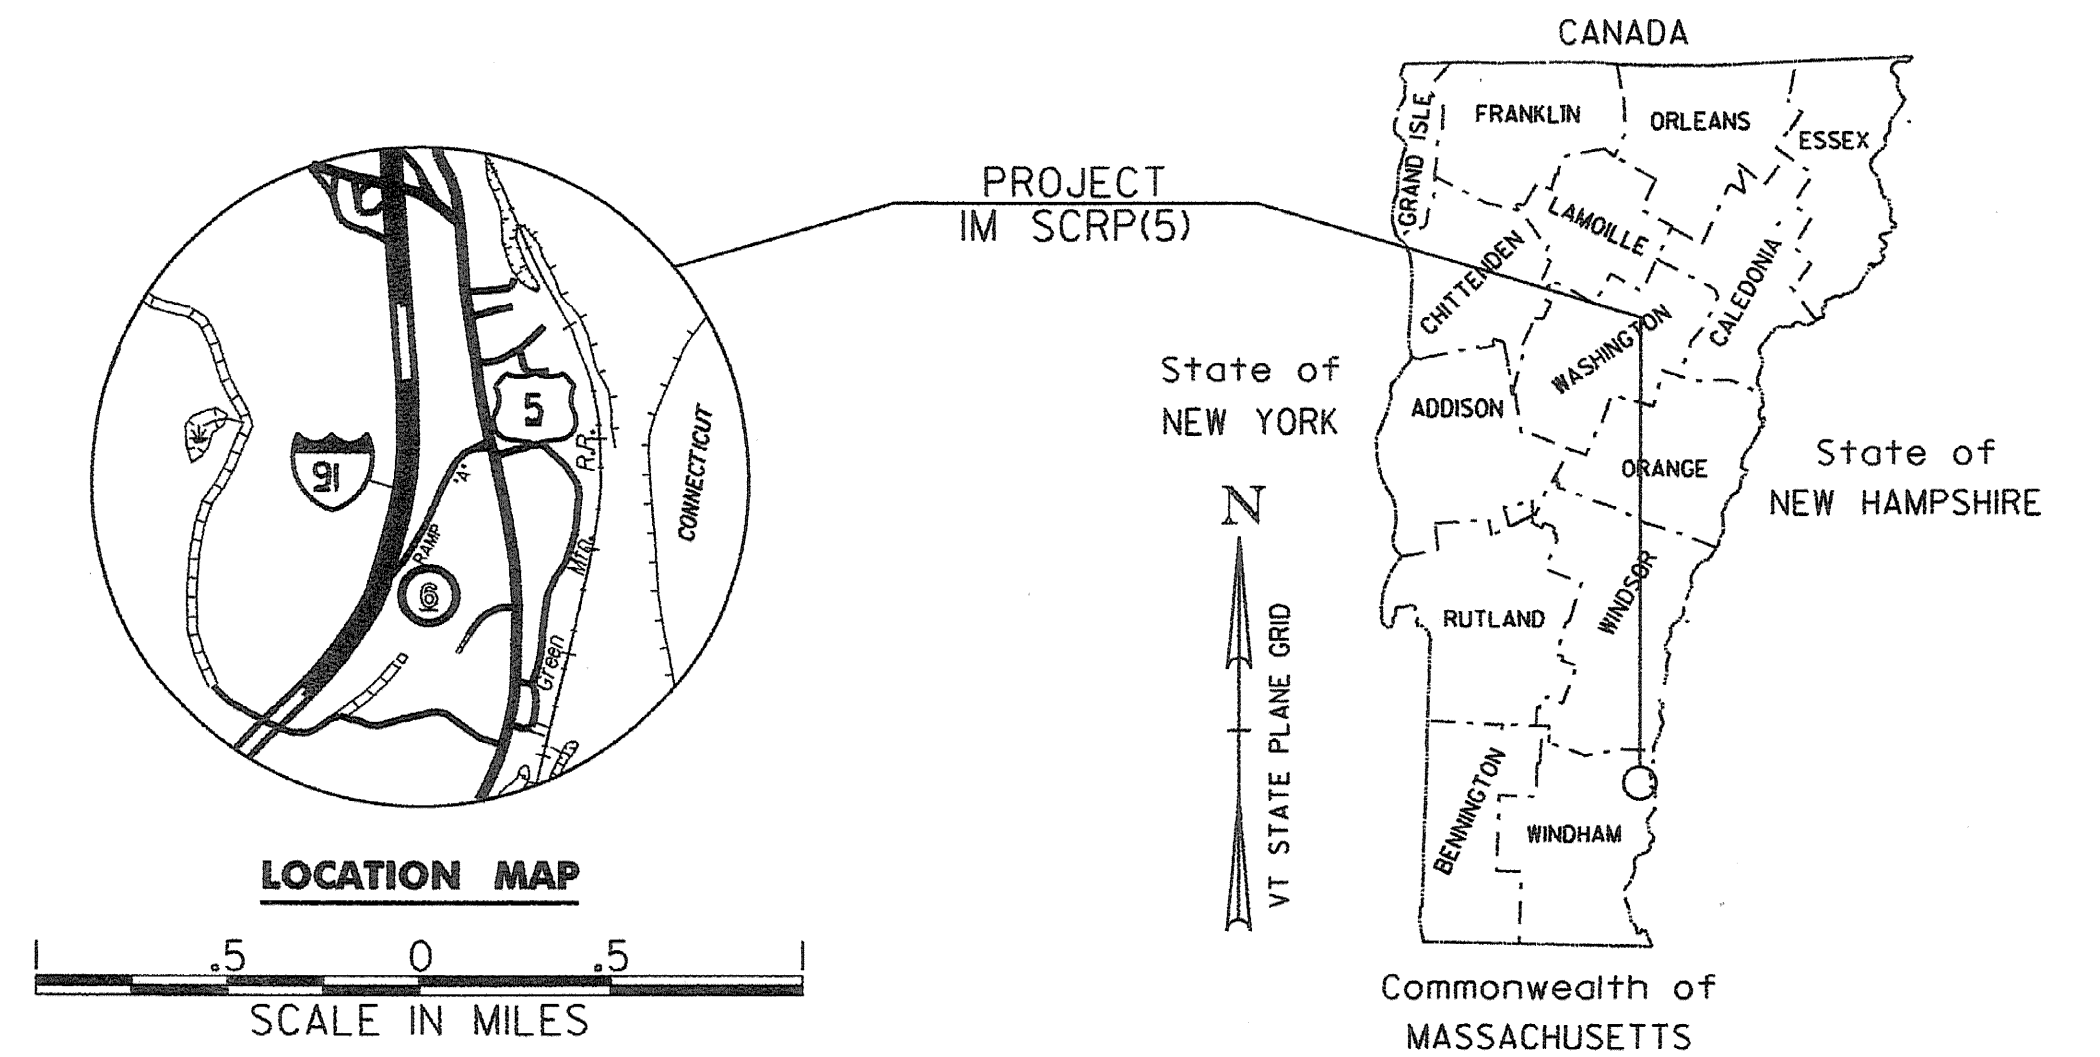

WORK TO BE PERFORMED AT AN ISOLATED LOCATION, MILE MARKER 0.351 ON THE INTERSTATE 91 NORTHBOUND EXIT 6 OFF RAMP (RAMP "A") IN THE TOWN OF ROCKINGHAM.

LENGTH OF PROJECT: 634 FEET = .12 MILES

THE PROJECT SHALL CONSIST OF INSTALLATION OF A CURED-IN-PLACE PIPE LINER, INSTALLATION OF A CONCRETE HEADWALL, WINGWALLS, CHANNEL AND EMBANKMENT STABILIZATION.

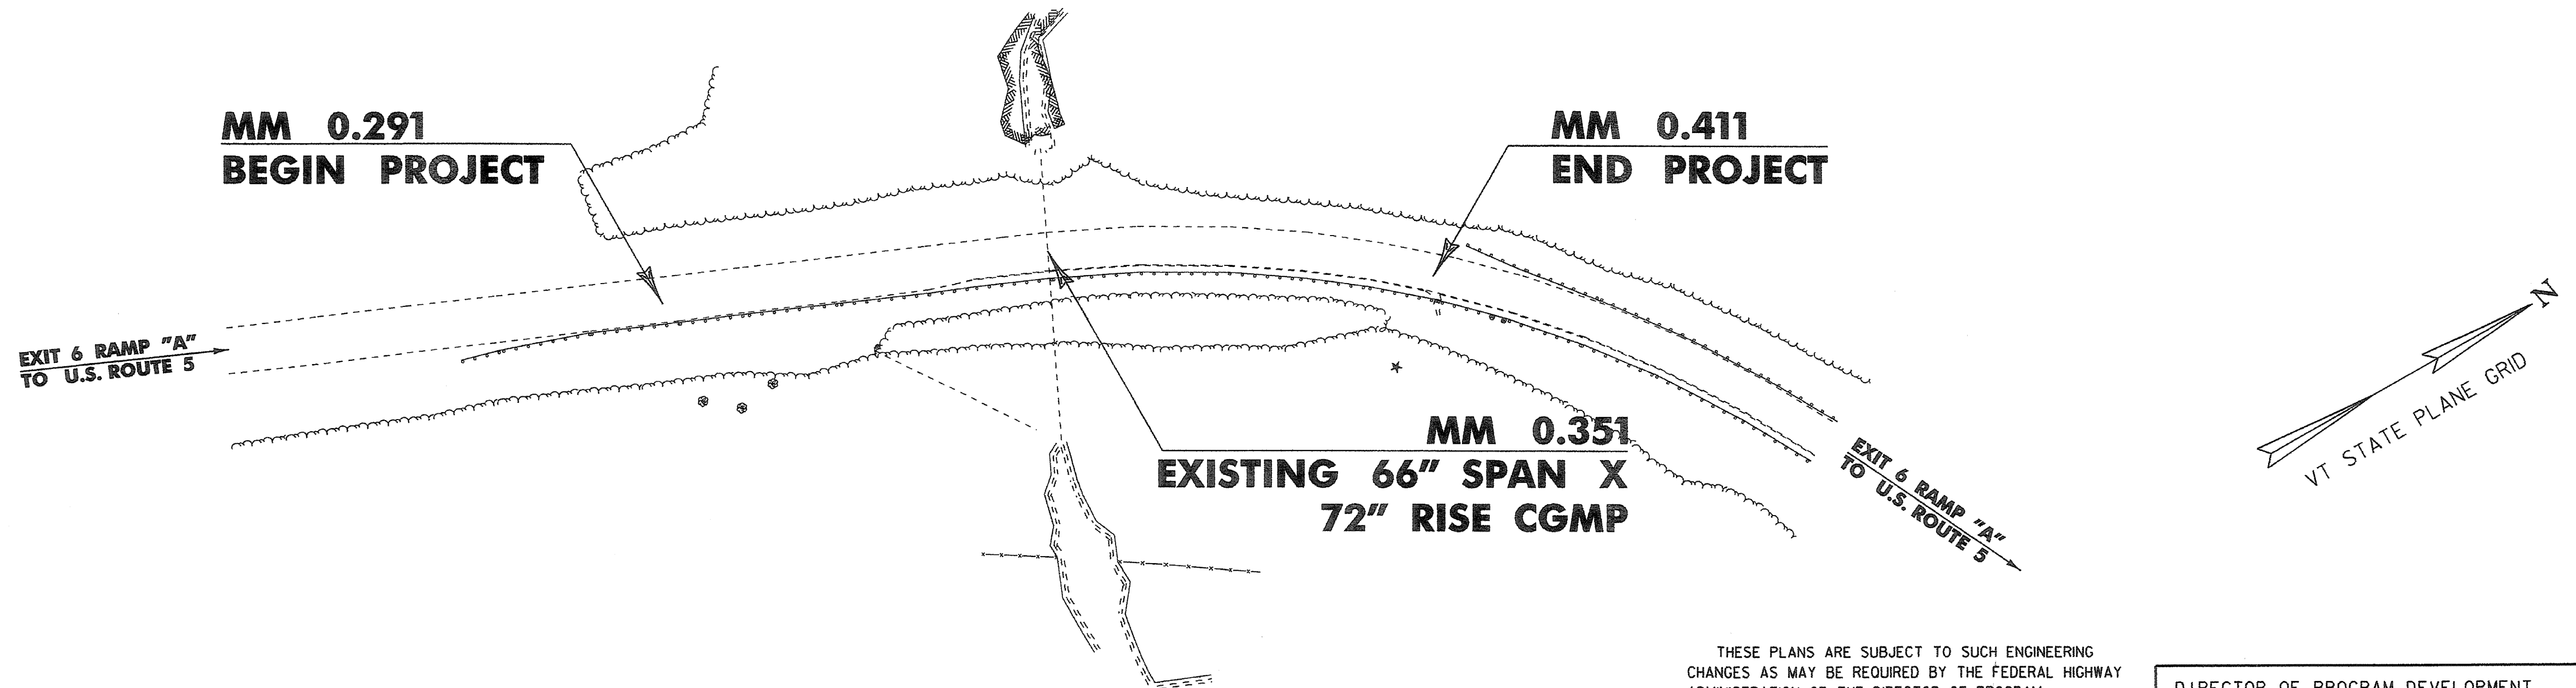

CONVENTIONAL SYMBOLS

COUNTY LINE	— — — — —
TOWN LINE	— — — — —
LIMITS OF ACCESS	— — — — —
POINT OF ACCESS	X
FENCE LINE	X — X — X — X —
STONE WALL	○ — ○ — ○ — ○ —
TRAVELED WAY	— — — — —
GUARD RAIL	○ — ○ — ○ — ○ —
RAILROAD	— — — — —
SURVEY LINE	— — — — —
CULVERT	— — — — —
POWER POLE	⊕
TELEPHONE POLE	⊕
TREES	⊗
CONTROL OF ACCESS	— — — — —
PROPERTY LINE	— — — — —
R.O.W. TAKING LINE	— — — — —
SLOPE RIGHTS	— — — — —
TOP OF CUT	— — — — —
TOE OF SLOPE	— — — — —

SURVEYED BY : R. GILMAN
SURVEYED DATE : 12/18/07

DATUM
VERTICAL NAVD88
HORIZONTAL NAD83 (96)



THESE PLANS ARE SUBJECT TO SUCH ENGINEERING CHANGES AS MAY BE REQUIRED BY THE FEDERAL HIGHWAY ADMINISTRATION OR THE DIRECTOR OF PROGRAM DEVELOPMENT.
CONSTRUCTION IS TO BE CARRIED ON IN ACCORDANCE WITH THESE PLANS AND THE STANDARD SPECIFICATIONS FOR CONSTRUCTION DATED 2006, AS APPROVED BY THE FEDERAL HIGHWAY ADMINISTRATION ON JUNE 15, 2006 FOR USE ON THIS PROJECT, INCLUDING ALL SUBSEQUENT REVISIONS AND SUCH REVISED SPECIFICATIONS AND SPECIAL PROVISIONS AS ARE INCORPORATED IN THESE PLANS.

DIRECTOR OF PROGRAM DEVELOPMENT	
APPROVED <i>Robert Johnson</i>	DATE 7-29-08
PROJECT MANAGER : K. UPMAL	
PROJECT NAME : ROCKINGHAM	
PROJECT NUMBER : IM SCRP (5)	
SHEET 1 OF 17 SHEETS	