


0+47.33
INLET



0+27.82
INLET

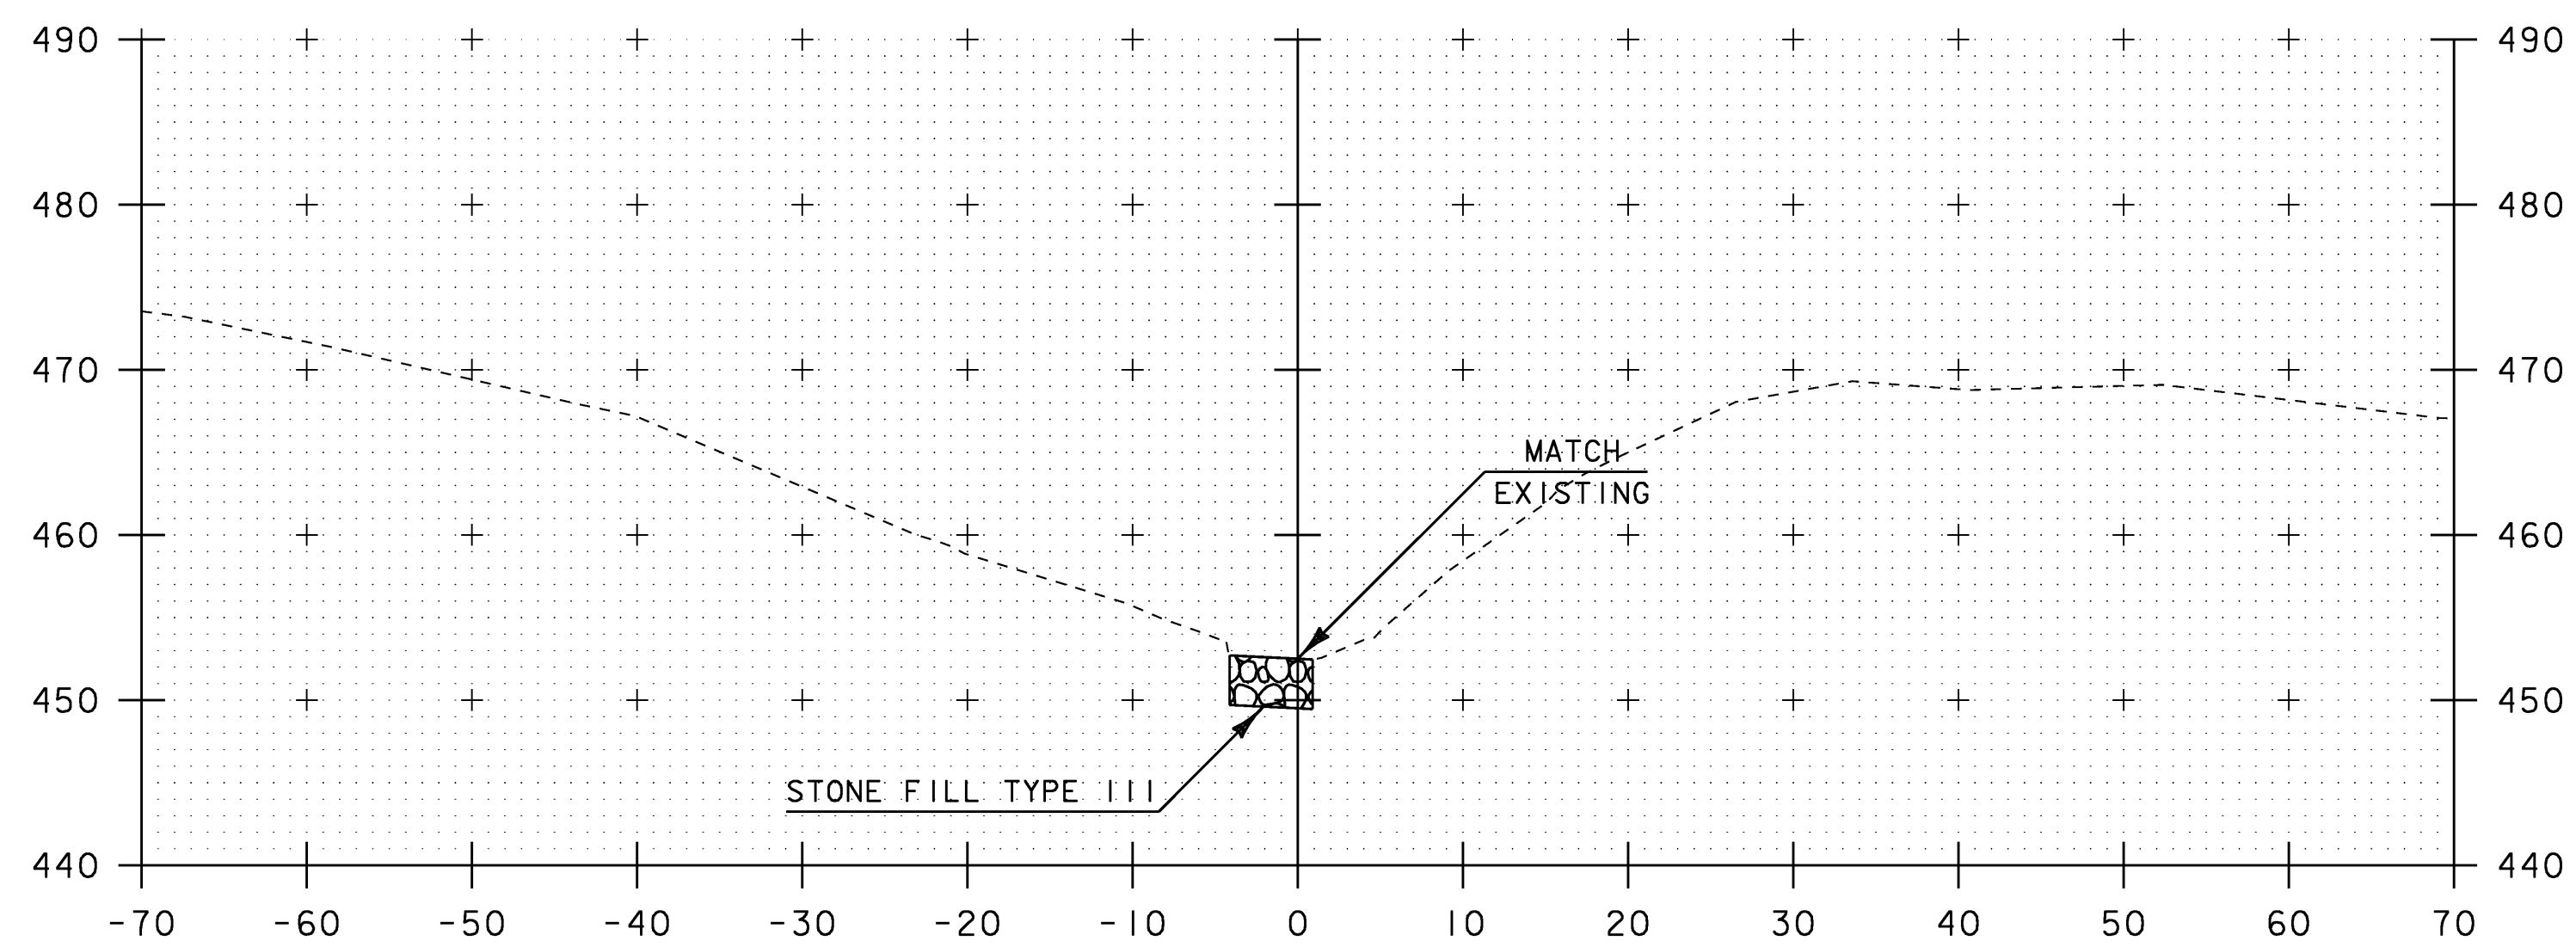

PROJECT NAME: ROCKINGHAM	PLOT DATE: 30-JUL-2008
PROJECT NUMBER: IM SCR(5)	DRAWN BY: T. GUAZZONI
FILE NAME: d07a108bdr.dgn	CHECKED BY: B. KIPP
PROJECT LEADER: K. UPMAL	SHEET 6 OF 17
DESIGNED BY: T. GUAZZONI	
CHANNEL SECTIONS	