



HEADWALL ELEVATION VIEW

SCALE 1/2" = 1'-0"
 0 1 2

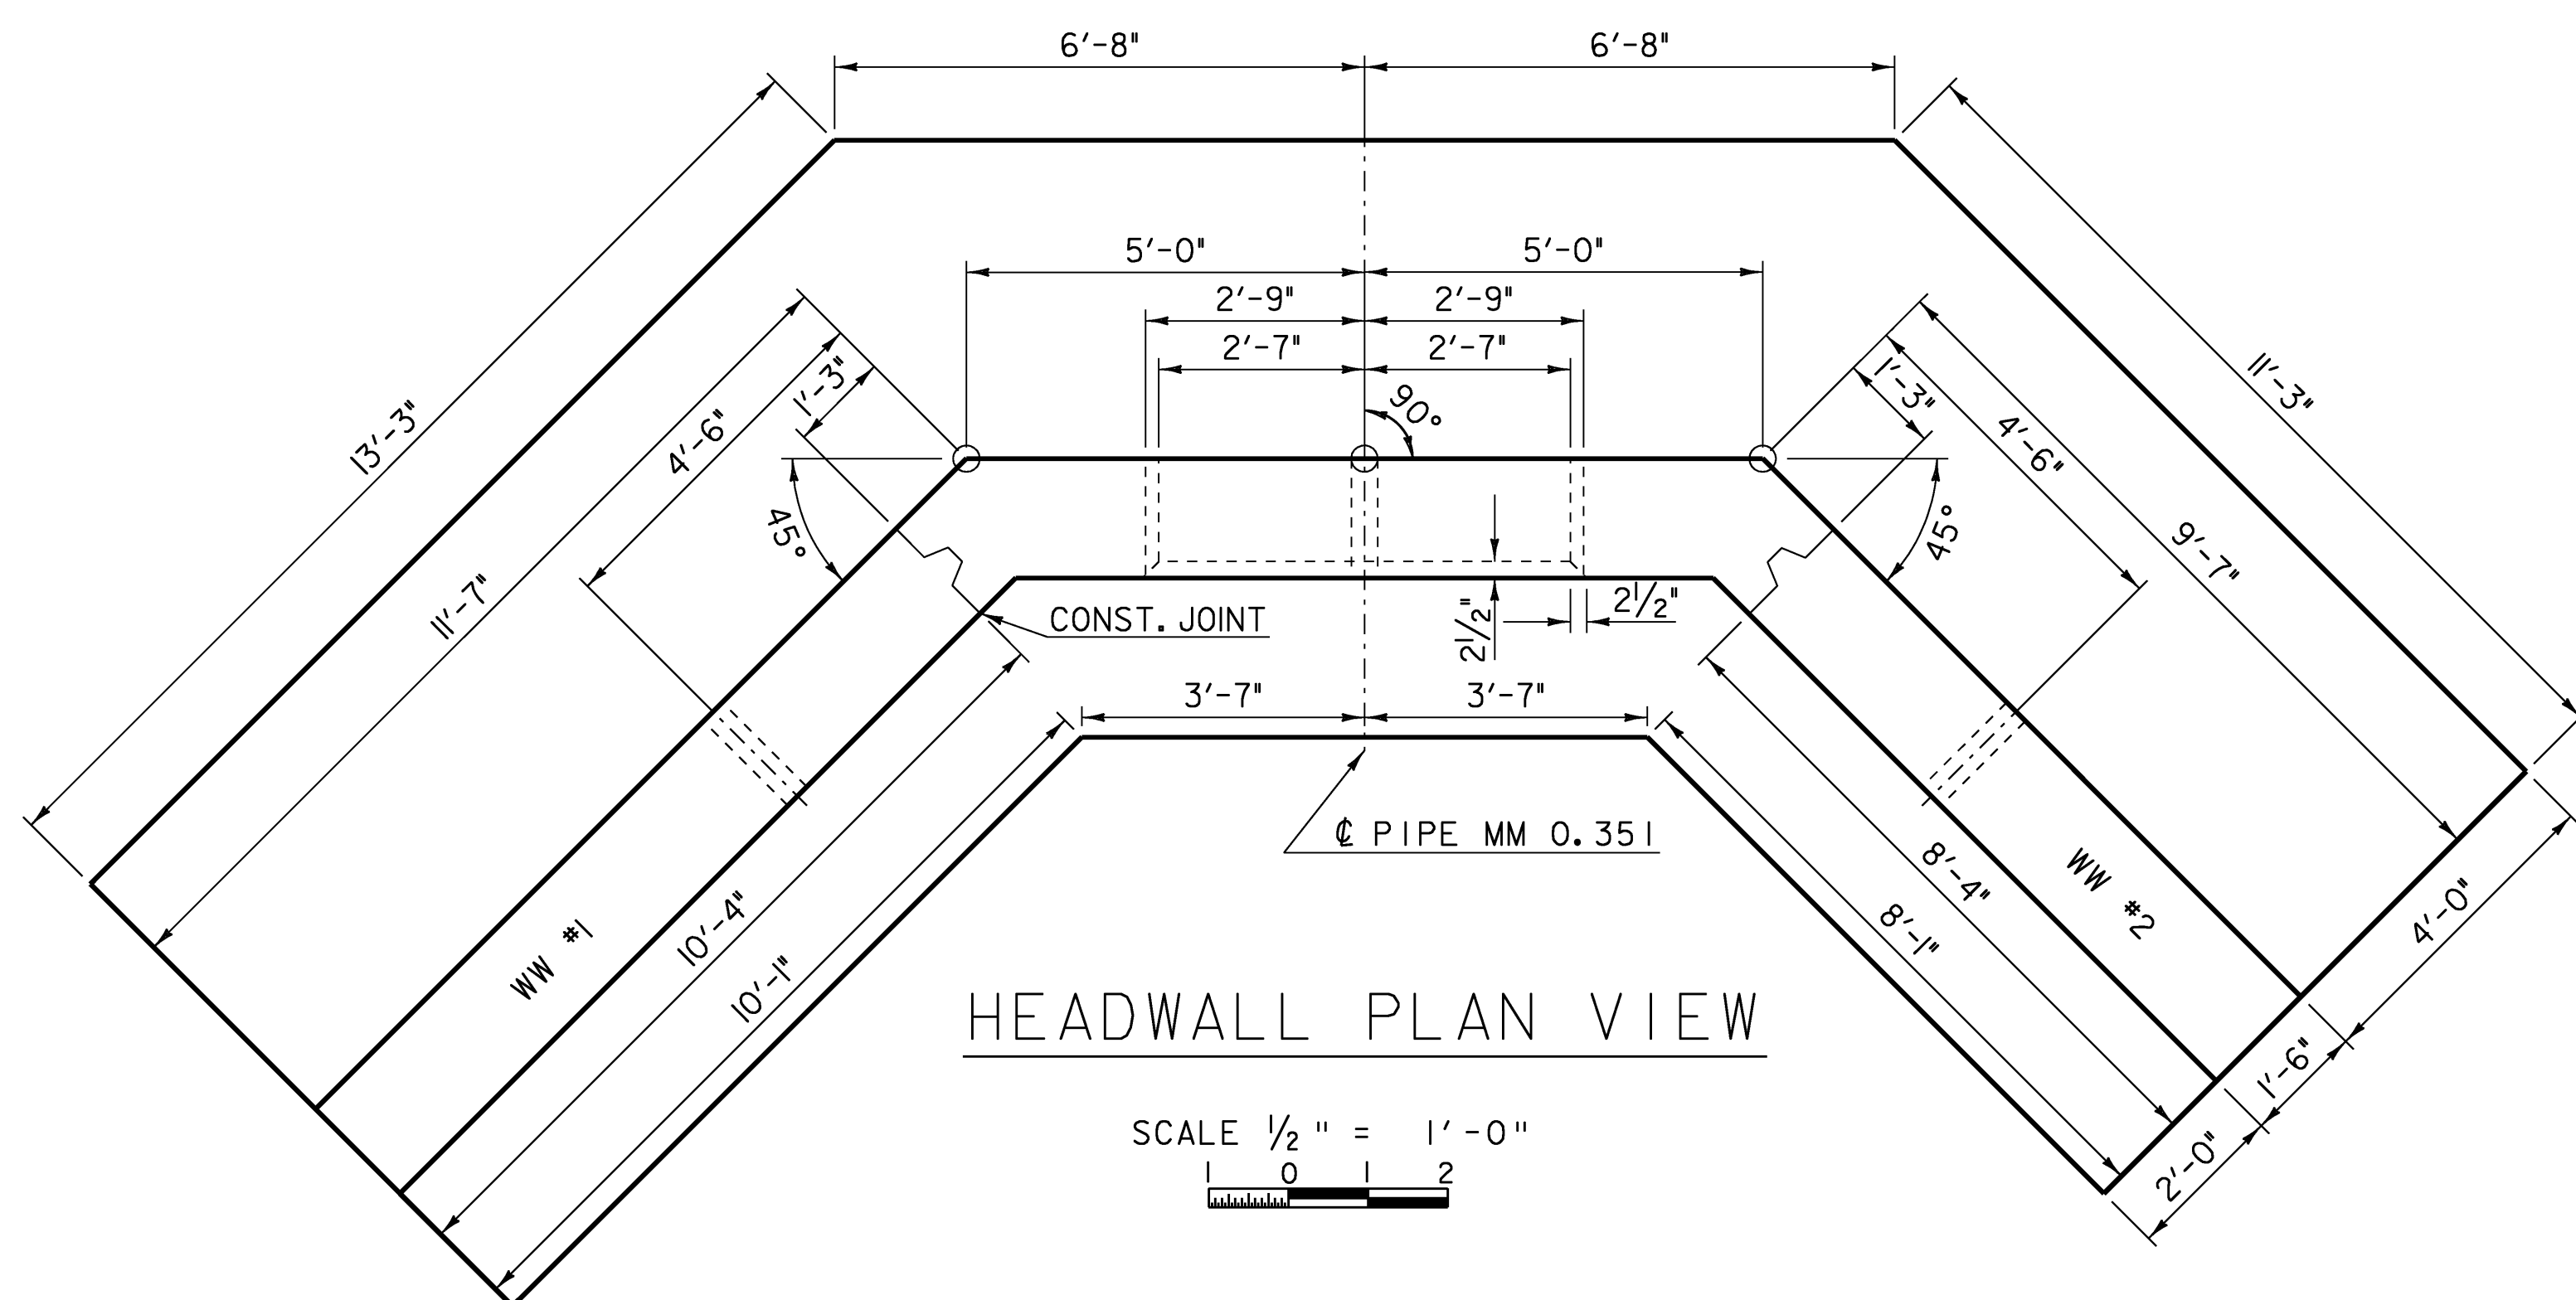

HEADWALL PLAN VIEW

SCALE 1/2" = 1'-0"
 0 1 2

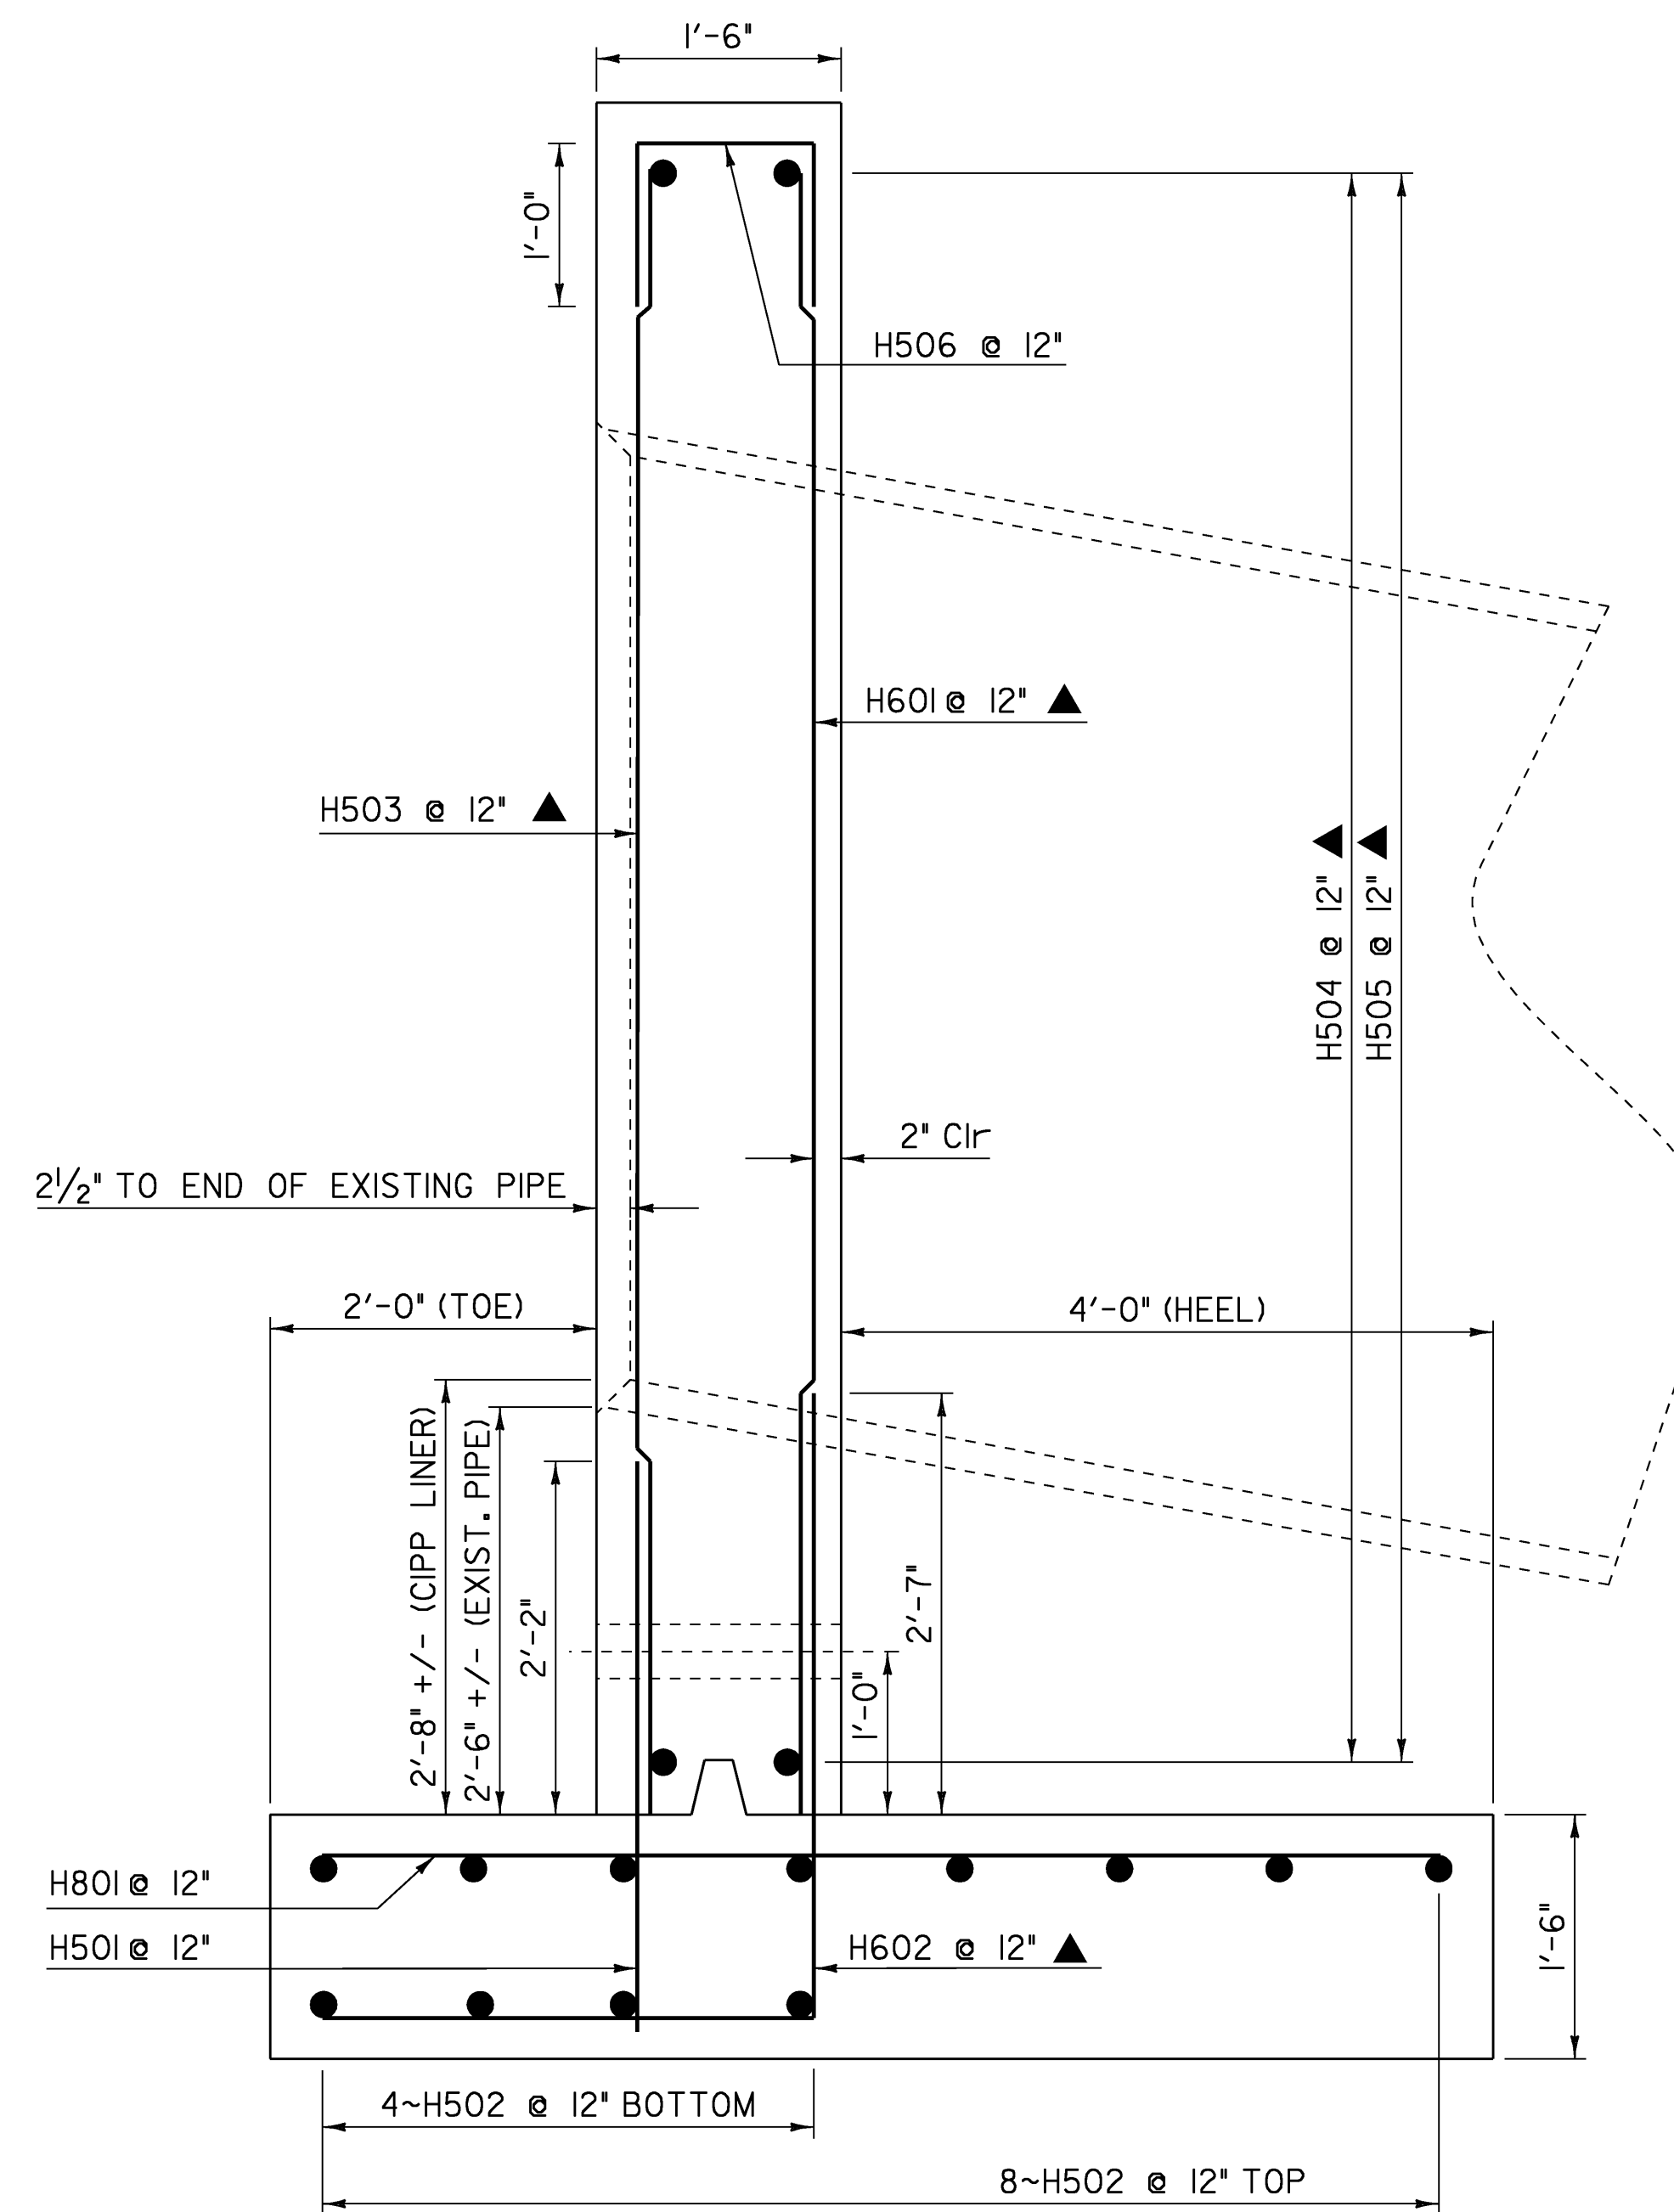

HEADWALL SECTION FOR MM 0.351

SCALE 1" = 1'-0"
 1 9 6 3 0 1 2

NOTE:

- NF = NEAR FACE
- FF = FAR FACE
- EF = EACH FACE
- ▲ = CUT TO FIT IN FIELD
- 3" CLR. UNLESS OTHERWISE SPECIFIED ON THE PLANS.

PROJECT NAME: ROCKINGHAM	PLOT DATE: 30-JUL-2008
PROJECT NUMBER: IM SCRP(5)	DRAWN BY: R. FOSTER
FILE NAME: d07al08Headwall.dgn	CHECKED BY: W. SYMONDS
PROJECT LEADER: K. UPMAL	SHEET 7 OF 17
DESIGNED BY: R. FOSTER	
HEADWALL DETAIL SHEET	