

CONSERVATION SEED MIX

RURAL AREA - SEED MIXTURE

% WT.	LBS./A.	NAME	PUR %	GERM %
37.5	22.5	CREeping RED FESCUE	98	85
37.5	22.5	TALL FESCUE	95	90
5.0	3.0	RED TOP	95	90
15.0	9.0	BIRDSFOOT TREFOIL	98	85
5.0	3.0	ANNUAL RYEGRASS	95	85
100.00	60.0			

SEED MIXTURE:
SHALL NOT HAVE A WEED CONTENT EXCEEDING 0.40% BY WEIGHT AND SHALL BE FREE OF ALL NOXIOUS WEED SEED.

SEED:
TO BE APPLIED PER SEEDING FORMULA OR AS DIRECTED BY THE RESIDENT ENGINEER

FERTILIZER:
FORMULA 10-20-10 TO BE USED WITH SEED, APPLIED AT THE RATE OF 500 LBS/ACRE (HYDROSEEDERS MAY USE 19-19-19 FORMULA)

AGRICULTURAL LIMESTONE:
TO BE APPLIED AT THE RATE OF 2 TONS/ACRE OR AS DIRECTED BY THE RESIDENT ENGINEER

HAY MULCH:
TO BE APPLIED ON EARTH SLOPES AT THE RATE OF 2 TONS/ACRE OR AS DIRECTED BY THE RESIDENT ENGINEER

TOPSOIL:
TO BE USED WITH SEED AS INDICATED ON THE PLANS OR AS DIRECTED BY THE RESIDENT ENGINEER



NOTE:
IF A HYDROSEEDER IS USED THE APPLICATION RATES SHALL BE DOUBLED

GENERAL NOTES:

- SHOULD CHANGES PRIOR TO OR DURING CONSTRUCTION RESULT IN ONE OR MORE ACRES OF EARTH DISTURBANCE OR SHOULD THE PROJECT BECOME PART OF A LARGER PLAN OF DEVELOPMENT THEN THE SELECTED CONTRACTOR WILL BE RESPONSIBLE FOR ADDITIONAL PERMITTING WITH VANR VIA FILING OF THE APPROPRIATE NOTICE OF INTENT UNDER THE CONSTRUCTION GENERAL PERMIT PROCESS.
- BRUSH REMOVAL SHALL BE MINIMIZED TO THAT WHICH IS NECESSARY TO INSTALL THE LINER.
- GRUBBING OF STUMPS IS NOT PERMITTED.
- INSTALL, MONITOR, AND REPLACE OR REPAIR EROSION AND SEDIMENT CONTROL MEASURES DURING CONSTRUCTION.

LEGEND

	PERMANENT SLOPE LIMITS
	PROJECT DEMARCATION FENCE
	GEOTEXTILE FOR SILT FENCE

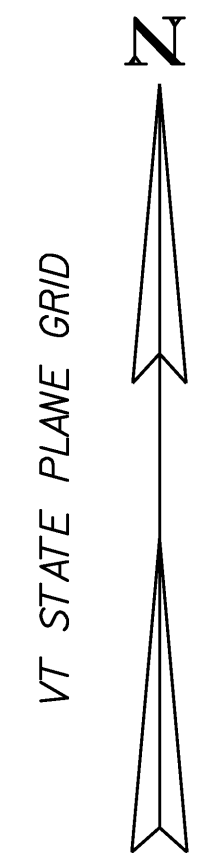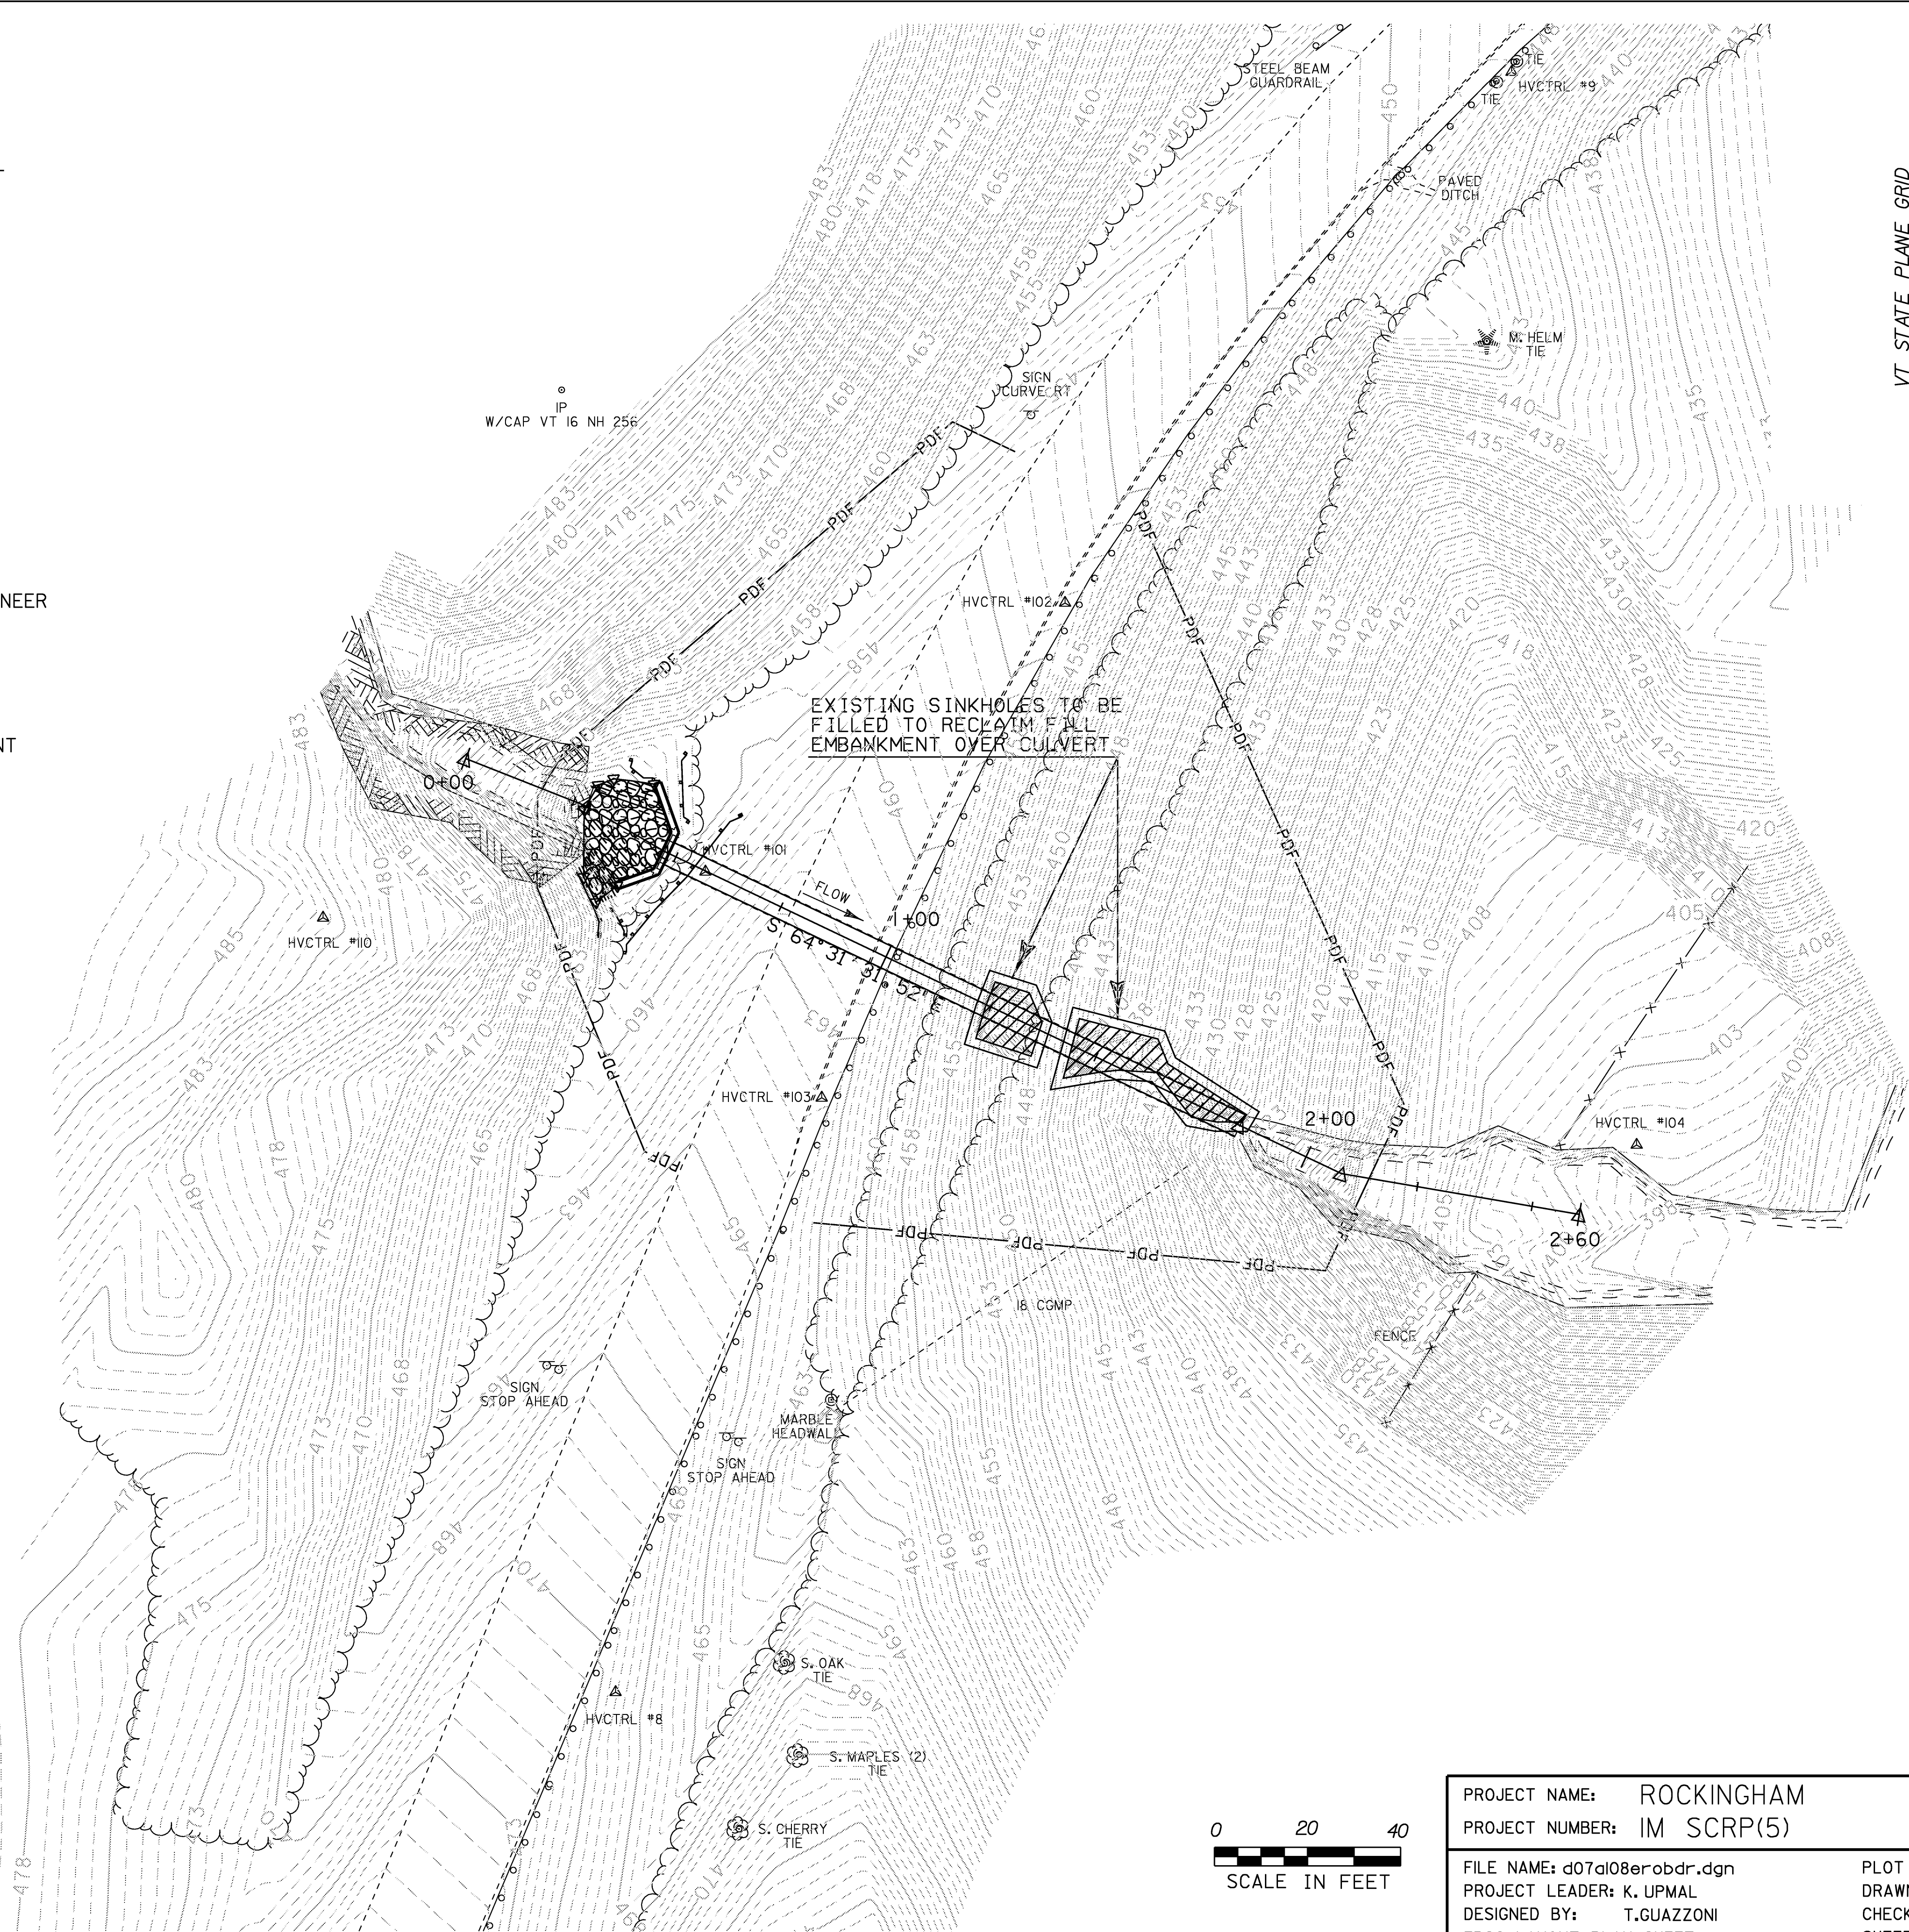

PROJECT NAME: ROCKINGHAM	PLOT DATE: 30-JUL-2008
PROJECT NUMBER: IM SCR(5)	DRAWN BY: T.GUAZZONI
FILE NAME: d07a108erobdr.dgn	DESIGNED BY: T.GUAZZONI
EPSC LAYOUT PLAN SHEET	CHECKED BY: B. KIPP
	SHEET 12 OF 17