


TRAFFIC DIRECTED TO RIGHT SIDE OF RAMP

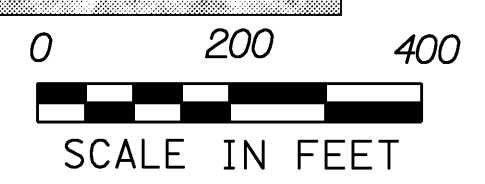

| | | | |
|-----------------|---------------|------------------------------|----------------|
| PROJECT NAME: | ROCKINGHAM | PLOT DATE: | 21-AUG-2008 |
| PROJECT NUMBER: | IM SCR(5) | DRAWN BY: | T. GUAZZONI |
| FILE NAME: | d07a108Tc.dgn | CHECKED BY: | B. KIPP |
| PROJECT LEADER: | K. UPMAL | TRAFFIC CONTROL PLAN SHEET 1 | SHEET 14 OF 17 |
| DESIGNED BY: | T. GUAZZONI | | |