


(24 X 48)  
**END ROAD WORK**  
 G20-2A  
 MM O. 47 NORTHBOUND  
 EXIT 6 RAMP 'A'

(48 X 48)  
**RAMP NARROWS**  
 (PORTABLE)  
 W5-4  
 MM O. 11 NORTHBOUND  
 EXIT 6 RAMP 'A'

(48 X 48)  
**RAMP WORK 1/2 MILE**  
 CUSTOM (SEE SHEET 17)  
 NORTHBOUND  
 I-91

(48 X 48)  
**RAMP WORK AHEAD**  
 CUSTOM (SEE SHEET 17)  
 NORTHBOUND  
 I-91

TRAFFIC DIRECTED TO LEFT SIDE OF RAMP

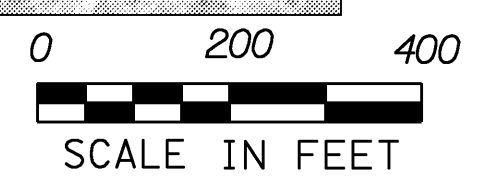

PROJECT NAME: ROCKINGHAM	PLOT DATE: 21-AUG-2008
PROJECT NUMBER: IM SCR(5)	DRAWN BY: T. GUAZZONI
FILE NAME: d07a108Tc.dgn	CHECKED BY: B. KIPP
PROJECT LEADER: K. UPMAL	SHEET 15 OF 17
DESIGNED BY: T. GUAZZONI	
TRAFFIC CONTROL PLAN SHEET 2	