

646.426 DURABLE 6 INCH WHITE LINE, RECESSED POLYUREA

RAMP B:
STA B0+00.0 - STA B13+71.0 EDGE LINE RT
STA B0+00.0 - STA B3+40.0 DOTTED LANE LINE CL
STA B3+40.0 - STA B5+00.0 DASHED LANE LINE CL

646.622 TEMPORARY 6 INCH WHITE LINE, PAINT

RAMP B:
STA B0+00.0 - STA B13+71.0 EDGE LINE RT
STA B0+00.0 - STA B3+40.0 DOTTED LANE LINE CL
STA B3+40.0 - STA B5+00.0 DASHED LANE LINE CL

646.436 DURABLE 6 INCH YELLOW LINE, RECESSED POLYUREA

RAMP B:
STA B7+00.0 - STA B13+71.0 EDGE LINE CL

646.632 TEMPORARY 6 INCH YELLOW LINE, PAINT

RAMP B:
STA B7+00.0 - STA B13+71.0 EDGE LINE CL

646.466 DURABLE 12 INCH WHITE LINE, RECESSED POLYUREA

RAMP B:
STA B5+00.0 - STA B7+00.0 SOLID GORE LINES CL & LT
STA B5+00.0 - STA B7+00.0 GORE HATCHING LT

646.662 TEMPORARY 12 INCH WHITE LINE, PAINT

RAMP B:
STA B5+00.0 - STA B7+00.0 SOLID GORE LINES CL & LT

646.482 DURABLE 24 INCH STOP BAR, THERMOPLASTIC

RAMP B:
STA B13+58.0 LT/RT

646.682 TEMPORARY 24 INCH STOP BAR, PAINT

RAMP B:
STA B13+58.0 LT/RT

646.492 DURABLE LETTER OR SYMBOL, THERMOPLASTIC

RAMP B:
STA B7+67.6 RT "S,T,O,P" (4 EA)
STA B8+08.0 RT "A,H,E,A,D" (5 EA)
STA B12+47.0 RT WRONG WAY ARROW (1EA)
STA B13+49.0 RT "S,T,O,P" (4 EA)


646.692 TEMPORARY LETTER OR SYMBOL, PAINT

RAMP B:
STA B7+67.6 RT "S,T,O,P" (8 EA)
STA B8+08.0 RT "A,H,E,A,D" (10 EA)
STA B12+47.0 RT WRONG WAY ARROW (2 EA)
STA B13+49.0 RT "S,T,O,P" (8 EA)

616.47 BITUMINOUS CONCRETE GUTTERS AND TRAFFIC ISLANDS

RAMP B:
STA B11+11.0 - STA B11+63.0 LT (1.4 TONS)





676.10 DELINEATOR WITH STEEL POST
SEE ITEM DETAIL SUMMARY SHEETS

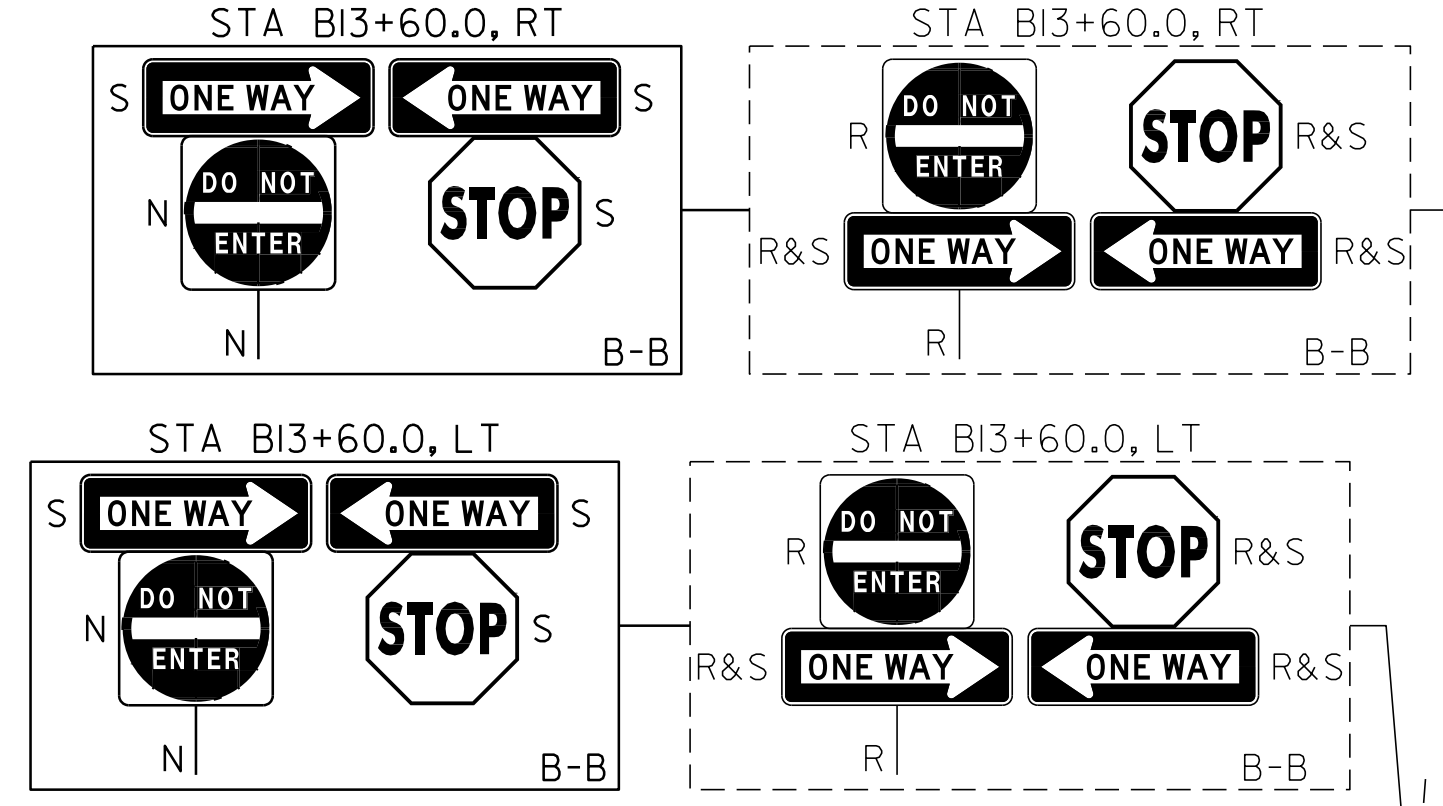

621.20 STEEL BEAM GUARDRAIL, GALVANIZED
RAMP B:
STA B0+37.5 - STA B9+00.0 RT
621.50 MANUFACTURED TERMINAL SECTION, FLARED
RAMP B:
STA B0+00.0 - STA B0+37.5 RT
621.60 ANCHOR FOR STEEL BEAM RAIL
RAMP B:
STA B9+00.0 RT



U.S. ROUTE 5 & VERMONT ROUTE 12

STA B13+71.00 - B16+01.00
END RAMP B
LIMIT OF COLD PLANING
AND PAVING

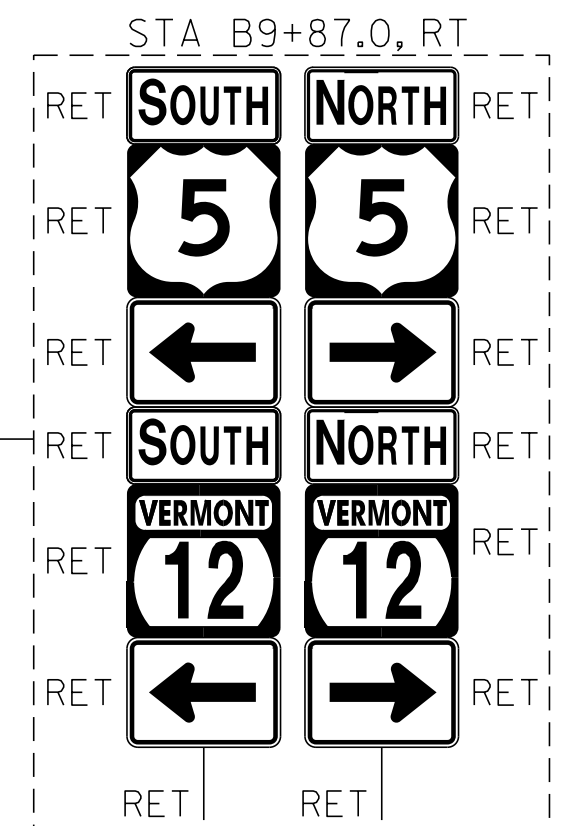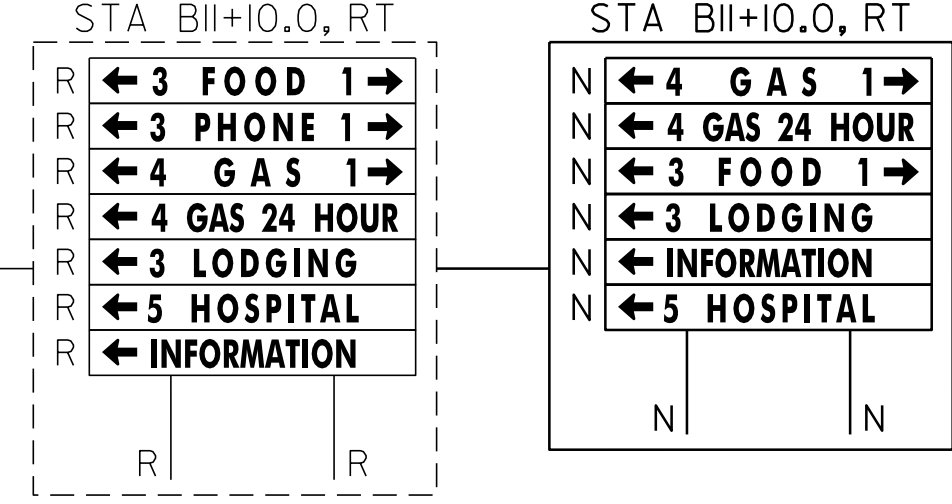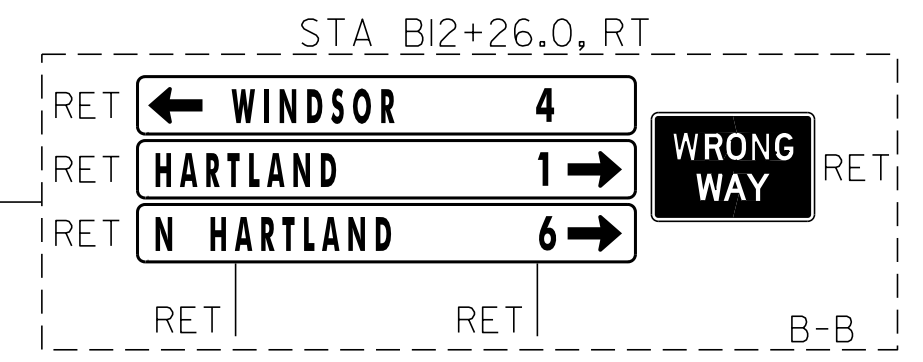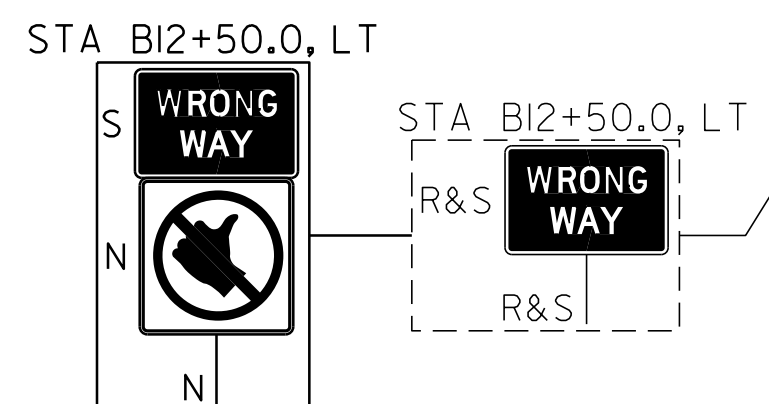

STA B4+94.0, RT B7+12.8, RT
SEE CALCULATION BELOW

S.B. MM 60.743
RAMP B STA B0+00.00
BEGIN RAMP B
STA B0+00.0, RT

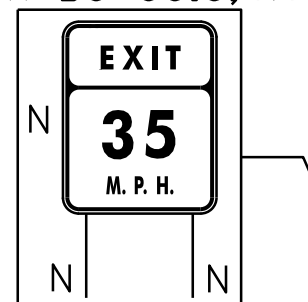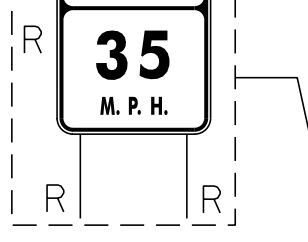


MM 60.743-MM 60.608=0.135 MI
0.135 MI X 5280' = 712.8 LF

NOTE: THE DECELERATION LANE EXTENSION @ RAMP B WAS ESTABLISHED USING MAIN-LINE MILE-MARKER PLAN FEATURES AS FOLLOWS:
SHEET #47 - BR NO 36S APPROACH PIER MM 60.445 LT
SHEET #4 - U-TURN PAVING DETAIL SB MM 60.720
BUST OF 230 LF +/- IN RAMP B STATIONING

LEGEND
AREA TO BE RECONSTRUCTED

NOTES:
1. SEE SHEET 17 FOR RAMP C DETAILS.
2. SEE SHEET 5 FOR DECELERATION LANE EXTENSION DETAILS.

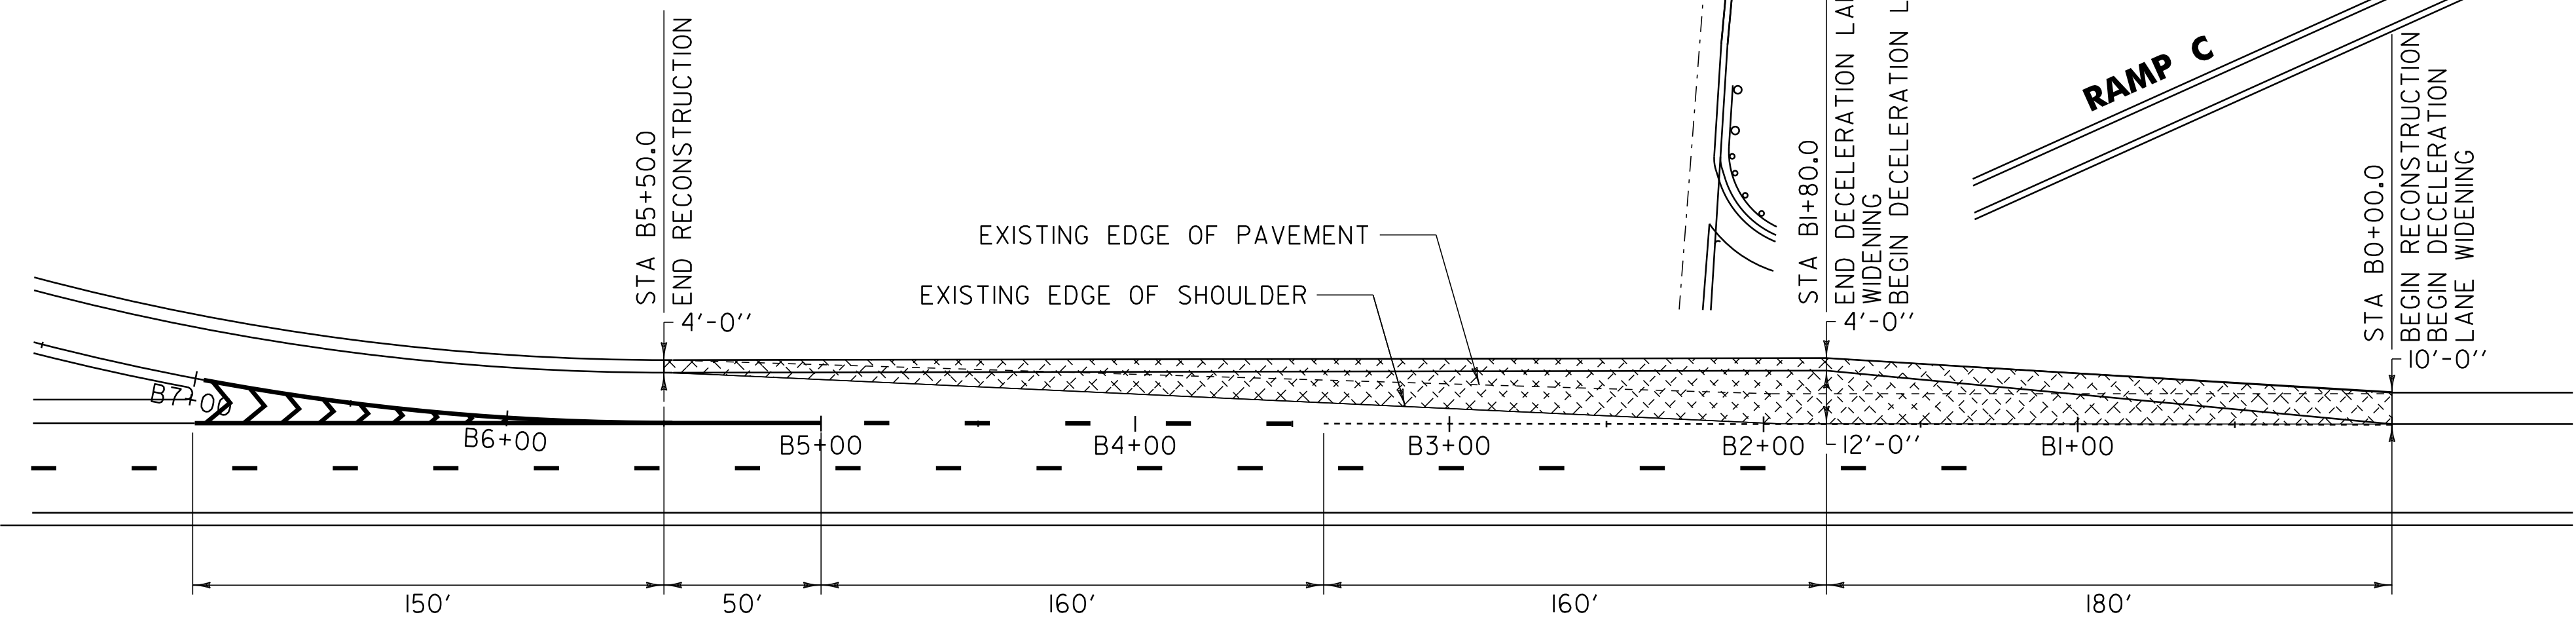

**INTERSTATE 91 SOUTHBOUND
SOUTHBOUND PARALLEL DECELERATION
LANE DETAIL**

SIGN LEGEND
R = REMOVE
S = SALVAGE
N = NEW
RET = RETAIN
B-B = BACK TO BACK
EXISTING = - - - - -
NEW = _____

NOT TO SCALE

**INTERCHANGE
#9
RAMP B
DETAIL
SHEET**

PROJECT NAME: WINDSOR - HARTLAND	PLOT DATE: 16-AUG-2011 13:41
PROJECT NUMBER: IM 091-(161)	DRAWN BY: C.A.K.
FILE NAME: p07al42.dgn	CHECKED BY: R.A.B.
PROJECT LEADER: D.E.G.	SHEET 16 OF 56
DESIGNED BY: M.J.L.	
IPARM FILE: p07al42int2.i	