


SEE REVISIONS SHEETS #29/56 AND #30/56




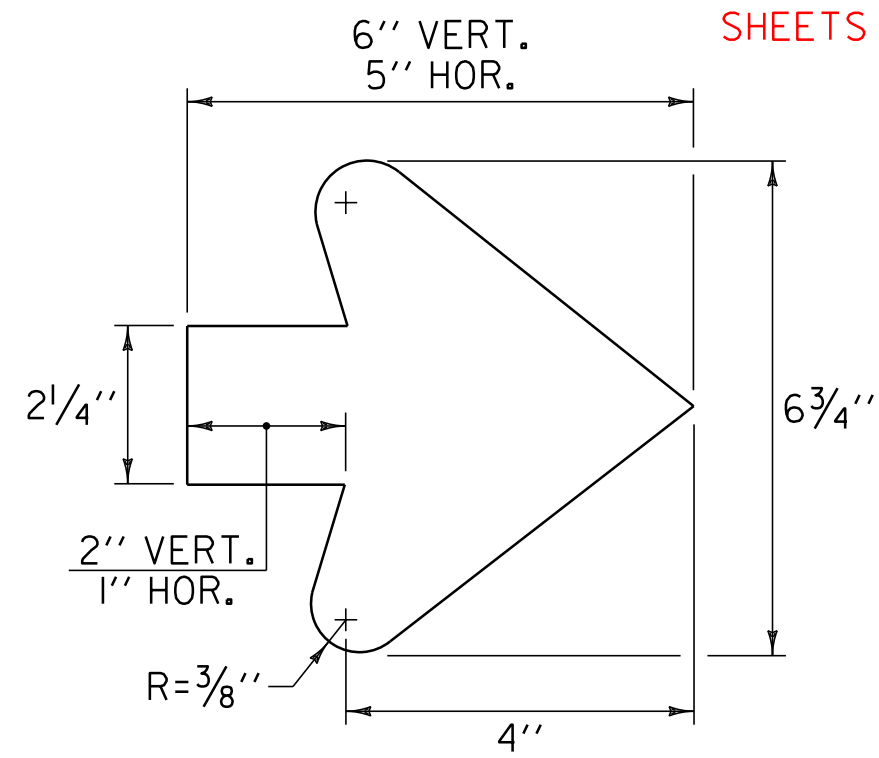


ARROW DIMENSIONS


COLOR: WHITE BORDER, TEXT & SYMBOL (REFLECTORIZED)
BLUE BACKGROUND (REFLECTORIZED)

MATERIAL: PER VAOT STANDARD E-133
SIGN - INTERSTATE 91

RAMP B BII+10.0 RT
RAMP D DI2+56.0 RT

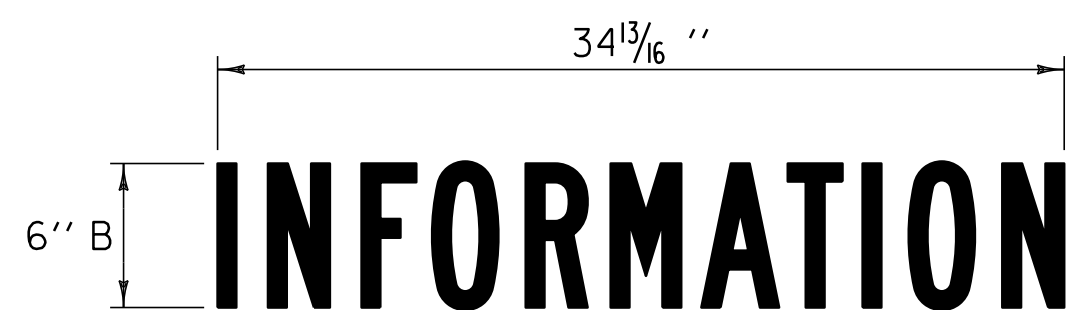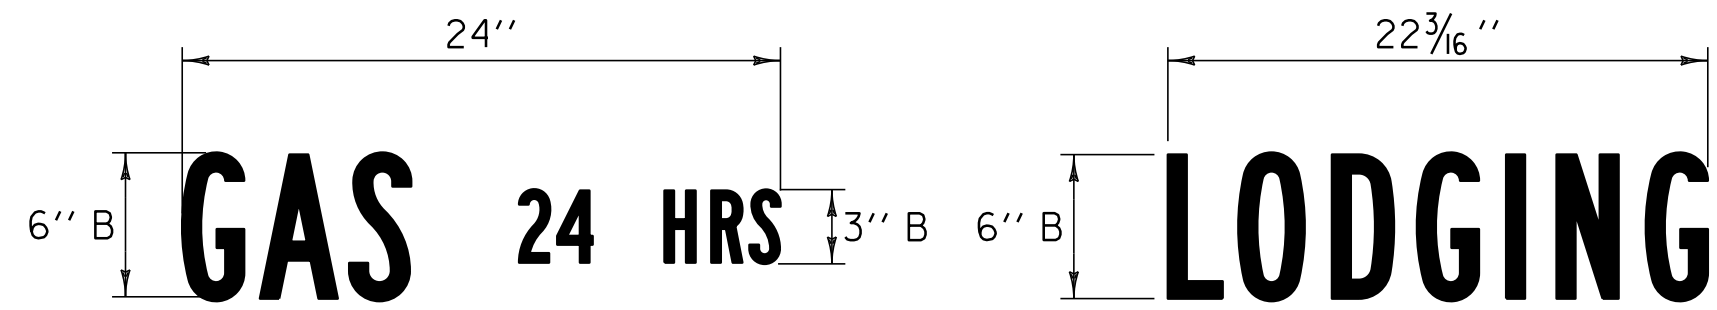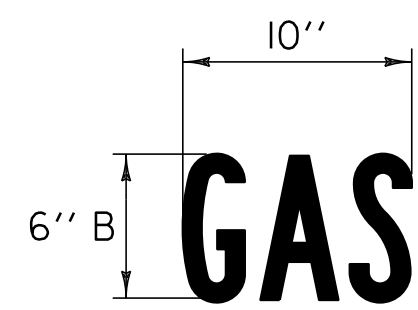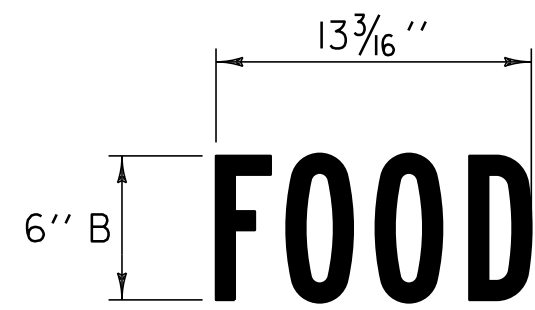

NOTE:
TEXT LAYOUT DIMENSIONS ARE BASED ON THE "LETTER & NUMERAL WIDTHS & SPACE" TABLES FOUND IN THE "STANDARD HIGHWAY SIGNS" BOOKLET. MINOR VARIATIONS IN TEXT DIMENSIONS ARE ACCEPTABLE BASED ON INDIVIDUAL MANUFACTURER'S LETTER FABRICATION. SIGNIFICANT CHANGES THAT AFFECT SIGN APPEARANCE SHALL BE BROUGHT TO THE ATTENTION OF VTRANS' TRAFFIC DESIGN UNIT BEFORE FABRICATION. INTERSTATE GUIDE SIGNS SHALL BE FABRICATED USING A MINIMUM ASTM TYPE IX SHEETING FOR LETTERS, BORDERS AND SYMBOLS AND THE BACKGROUND MATERIAL SHALL BE A MINIMUM ASTM TYPE III RETROREFLECTIVE SHEETING. ALL OTHER PERMANENT SIGNS SHALL BE FABRICATED USING MINIMUM ASTM TYPE III RETROREFLECTIVE SHEETING.

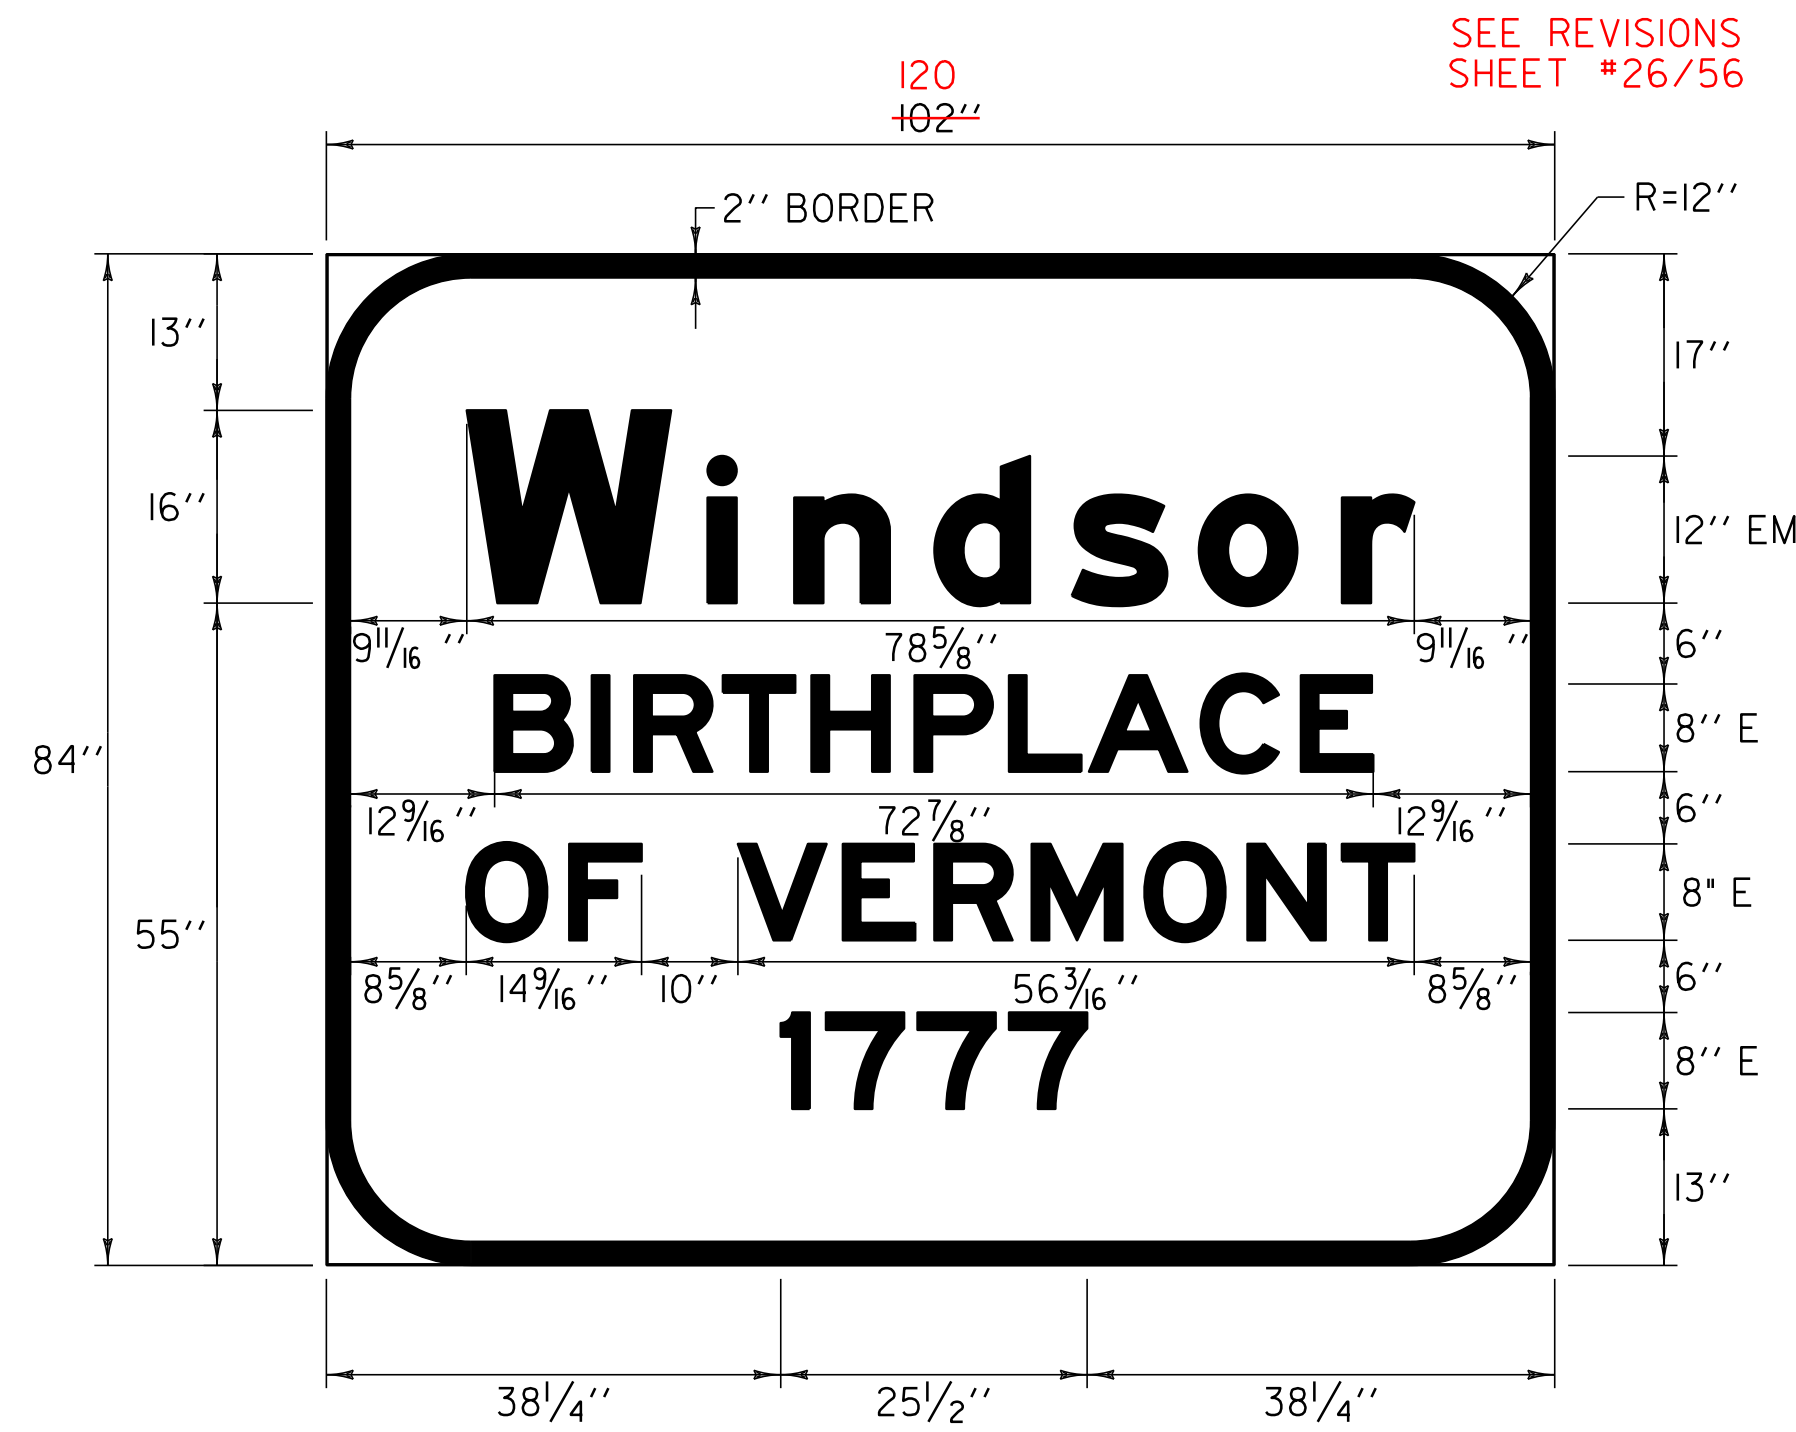

SEE REVISIONS SHEET #26/56

COLOR: WHITE BORDER & SYMBOL (REFLECTORIZED)
GREEN BACKGROUND (REFLECTORIZED)

MATERIAL: PER VAOT STANDARD E-131
SIGN - INTERSTATE 91


SOUTHBOUND: SEE REVISIONS SHEETS #26/56 AND #40/56
MM 61.270 LT



COLOR: WHITE BORDER, TEXT & SYMBOL (REFLECTORIZED)
BLUE BACKGROUND (REFLECTORIZED)

MATERIAL: PER VAOT STANDARD E-132
SIGN - INTERSTATE 91

NORTHBOUND:
MM 65.295 RT

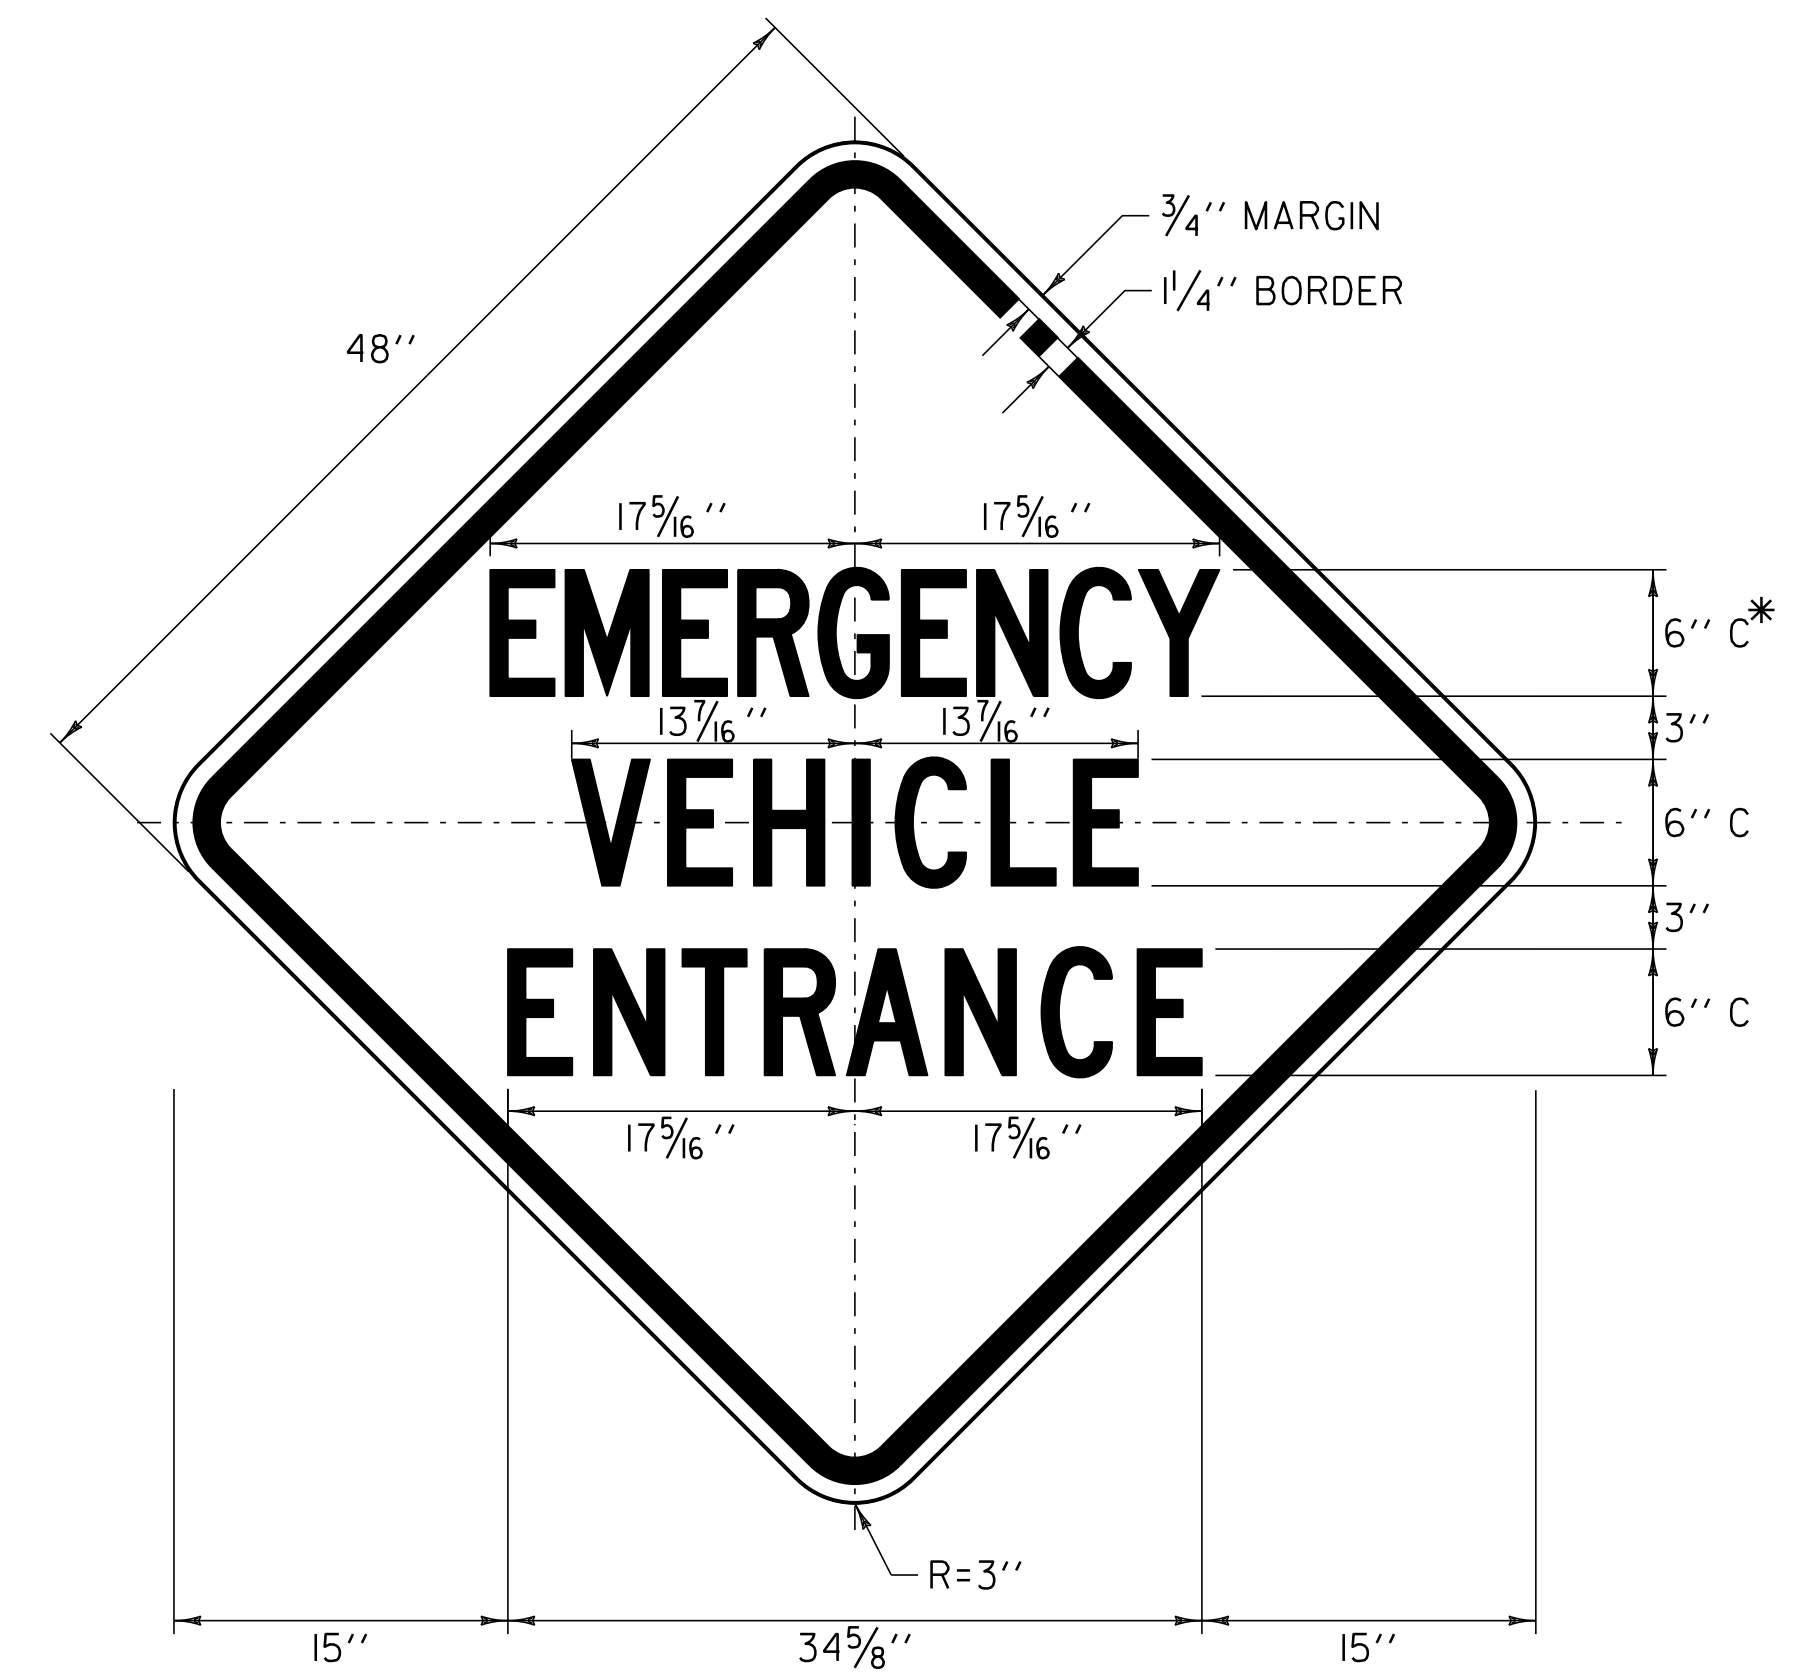


COLOR: BLACK BORDER & TEXT
YELLOW BACKGROUND (REFLECTORIZED)

MATERIAL: PER VAOT STANDARD E-153
SIGN - INTERSTATE 91

SOUTHBOUND:
MM 66.114 LT

* LETTERING USED WITH 50% REDUCED SPACING

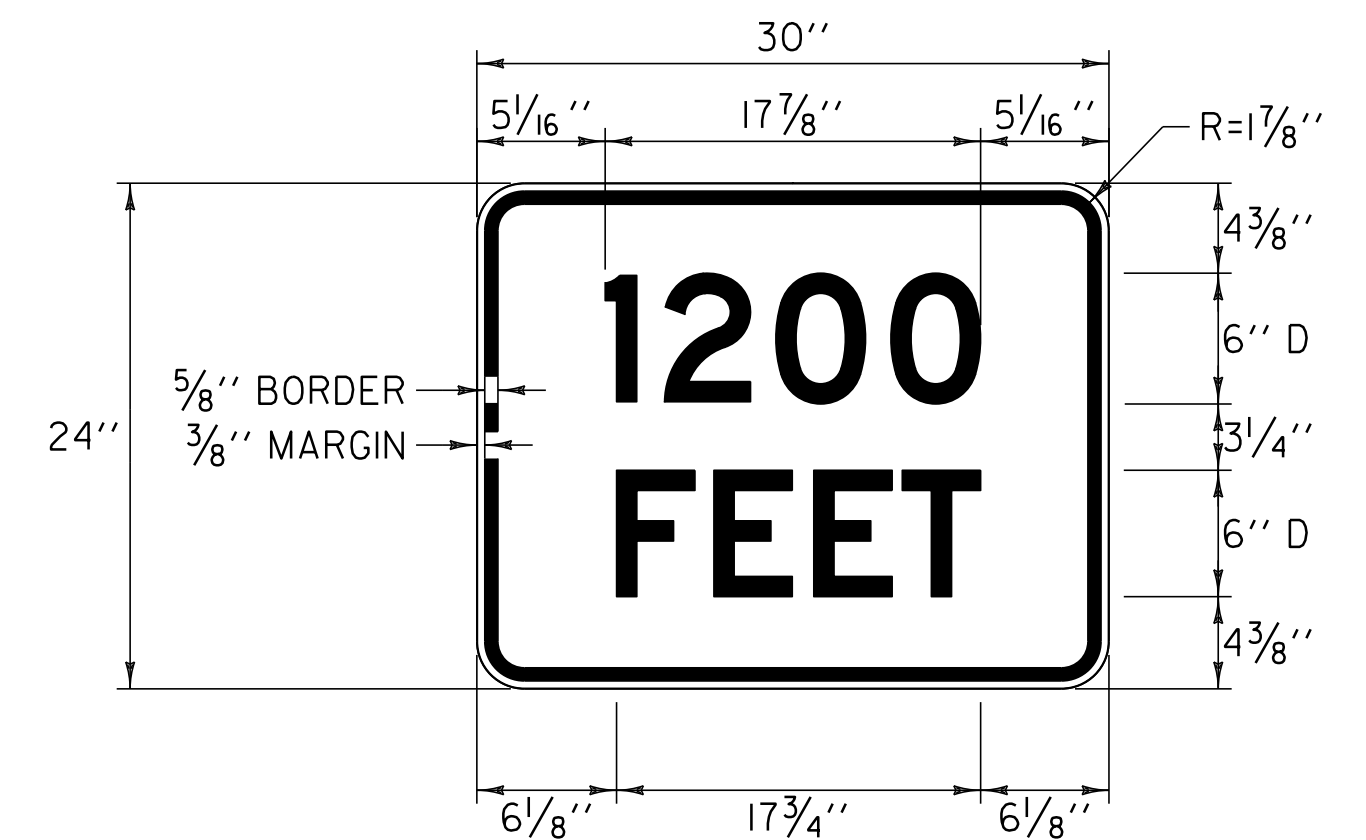

COLOR: BLACK BORDER & TEXT
YELLOW BACKGROUND (REFLECTORIZED)

MATERIAL: PER VAOT STANDARD E-153
SIGN - INTERSTATE 91

SOUTHBOUND:
MM 66.114 LT

NOT TO SCALE

TRAFFIC SIGN DETAIL SHEET #3	PROJECT NAME: WINDSOR - HARTLAND	
	PROJECT NUMBER: IM 091-(161)	
	FILE NAME: p07al42.dgn	PLOT DATE: 16-AUG-2011 13:43
	PROJECT LEADER: D.E.G.	DRAWN BY: C.A.K.
DESIGNED BY: M.J.L.	CHECKED BY: R.A.B.	
IPARM FILE: p07al42+sd3.i	SHEET 37 OF 56	