


RAMP TYPICAL SECTION

"BUILT AS DESIGNED"

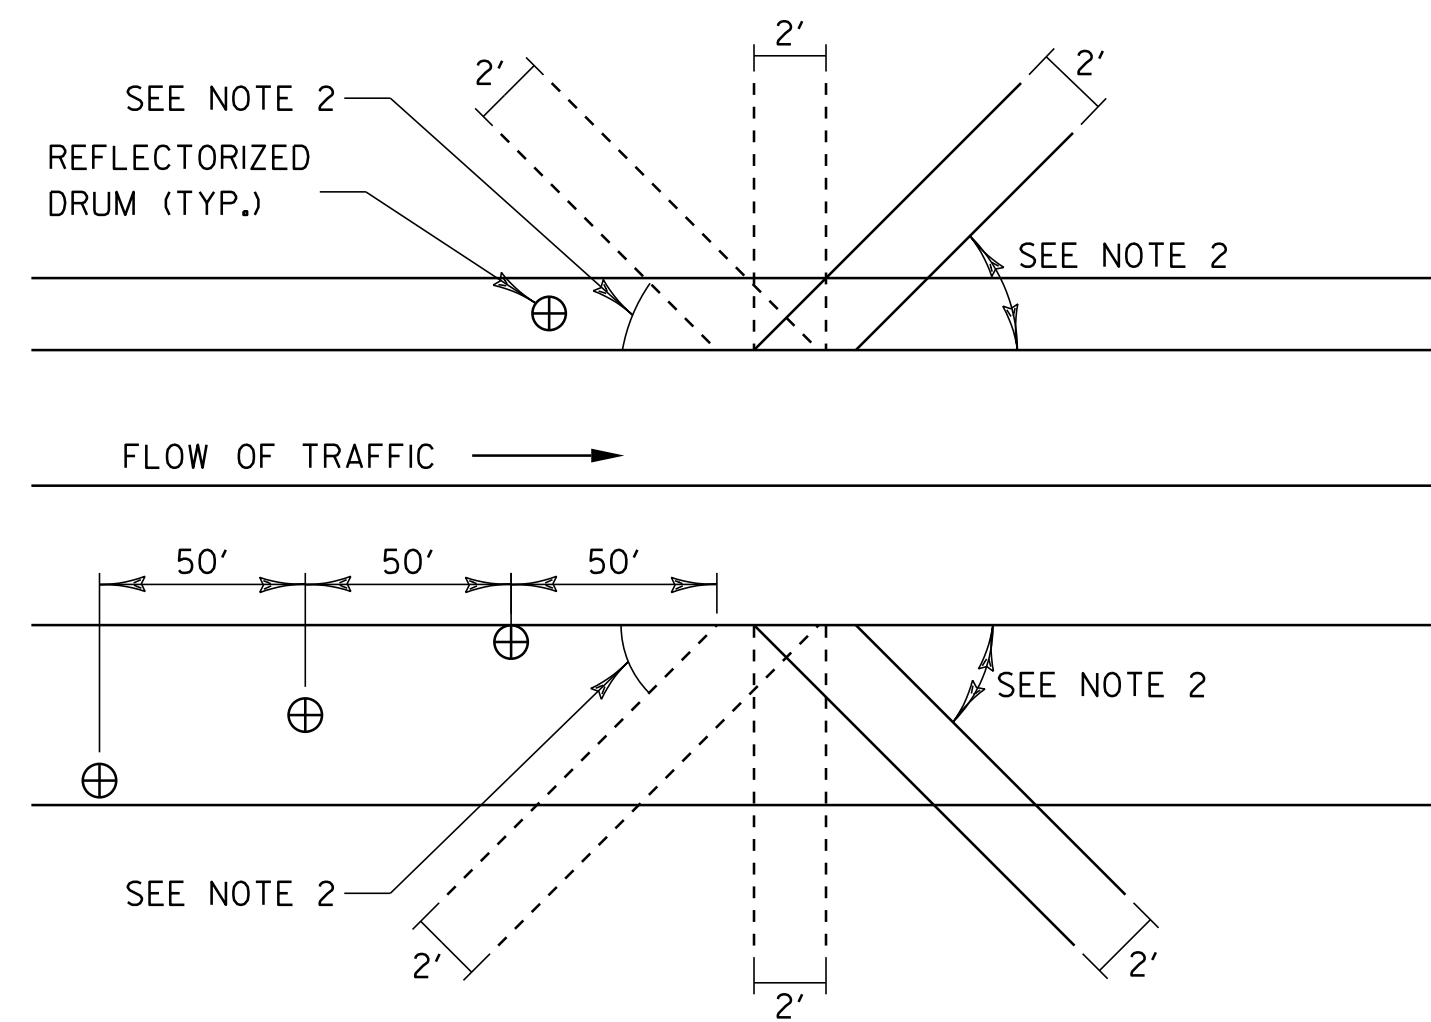

BLEEDER DETAIL

BLEEDER DETAIL NOTES:

1. BLEEDERS ARE TO BE CUT WHILE COLD PLANING, AT LOCATIONS SPECIFIED BY THE RESIDENT ENGINEER.
2. ANGLE BLEEDERS TO BEST ACCEPT WATER FLOW.
3. CUT ALL BLEEDERS TO THE DEPTH OF COLD PLANING AND GRADE TO DRAIN. PAYMENT INCIDENTAL TO ITEM 210.10.
4. BLEEDERS ARE TO BE FILLED DURING PAVING WITH ITEM 490.30 OR AS DESIGNATED BY THE RESIDENT ENGINEER.
5. REFLECTORIZED DRUMS MUST BE PLACED AS SHOWN TO WARN MOTORISTS OF THE GAP IN THE SHOULDER.
6. BLEEDERS ARE NOT REQUIRED IF THE COLD PLANED AREAS ARE PAVED BACK THE SAME DAY.

NOT TO SCALE

PROJECT TYPICAL SHEET 2

PROJECT NAME: NEWBURY
 PROJECT NUMBER: IM 091-2 (77)

FILE NAME: p07a146.dgn	PLOT DATE: 25-OCT-2011 4:21
PROJECT LEADER: PVMT. MGMT.	DRAWN BY: MRS
DESIGNED BY: JLR/LSW	CHECKED BY: PVMT. MGMT.
IPARM FILE NAME: p07a146ty2.i	SHEET 4 OF 20