

TEMPORARY 6" WHITE LINE, PAINT  
 DURABLE 6" WHITE LINE, RECESSED POLYUREA

MM 104.955 TO MM 110.600 SOLID LT  
 MM 104.955 TO MM 110.600 DASHED CL

TEMPORARY 6" YELLOW LINE, PAINT  
 DURABLE 6" YELLOW LINE, RECESSED POLYUREA

MM 104.955 TO MM 110.600 SOLID RT

REHAB. DI, CB, MH

~~MM 110.021 LT~~  
 MM 105.825 LT  
 MM 105.862 LT  
 MM 110.021 LT

CHANGING ELEV. DI, CB, MH


~~MM 105.812 LT~~  
~~MM 105.850 LT~~  
~~MM 105.888 LT~~  
~~MM 105.947 LT~~  
~~MM 106.530 LT~~  
~~MM 106.581 LT~~  
~~MM 106.870 LT~~  
~~MM 106.907 RT~~  
~~MM 106.907 LT~~  
~~MM 106.973 LT~~  
~~MM 109.217 LT~~  
~~MM 109.260 RT~~  
~~MM 109.830 LT~~  
~~MM 109.974 LT~~  
~~MM 110.594 LT~~  
~~MM 110.674 LT~~  
~~MM 110.697 LT~~

~~STONE FILL, TYPE 1~~

~~MM 109.283 RT (4' SHLRD.)~~  
~~MM 109.846 LT (10' SHLRD.)~~

**INTERSTATE ROUTE 91 SB**  
**MM 104.955**  
**BEGIN PROJECT**  
**IM 091-2(77)**

**INTERSTATE ROUTE I-91 SB**  
**MM 110.600**  
**END PROJECT**  
**IM 091-2(77)**

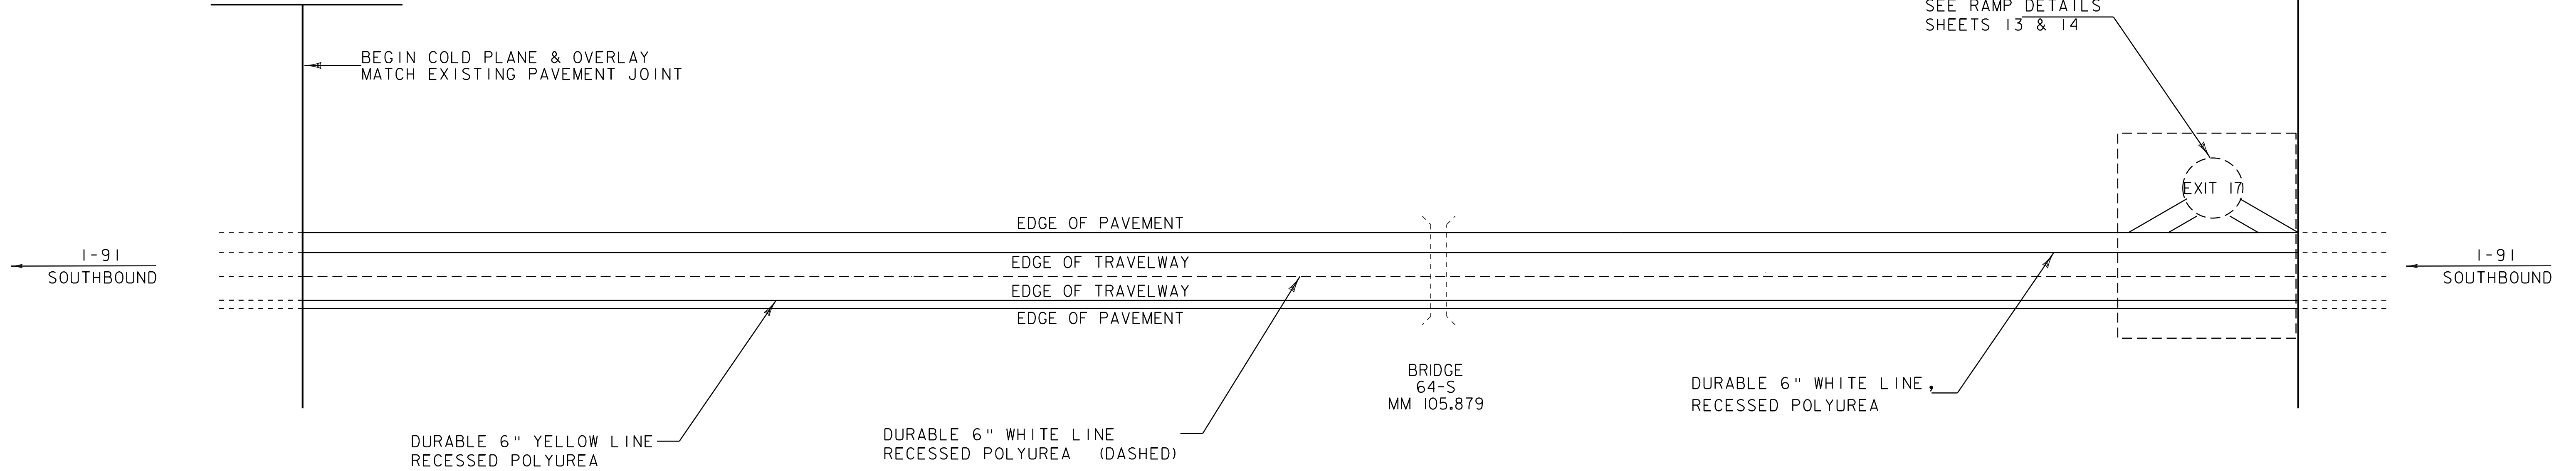

SEE PROJECT PAVING LIMITS TABLE ON SHEET 3 FOR ROADWAY DIMENSIONS.

PAVING LAYOUT 2

PROJECT NAME: NEWBURY	
PROJECT NUMBER: IM 091-2 (77)	
FILE NAME: p07a146.dgn	PLOT DATE: 25-OCT-2011 4:21
PROJECT LEADER: T. DOMEY	DRAWN BY:
DESIGNED BY: JLR/LSW	CHECKED BY:
IPARM FILE NAME: p07a146pl2.i	SHEET 10 OF 20

NOT TO SCALE