


MATCH LINE - SEE LAYOUT SHEET #4

DURABLE 6 INCH YELLOW LINE, RECESSED POLYUREA
DURABLE 6 INCH WHITE LINE, RECESSED POLYUREA

I-91 NORTHBOUND

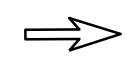

4' - 0"

12' - 0"

12' - 0"

10' - 0"

TO
DERBY

686' - 0"
TO END OF ON-RAMP TAPER

NOTES: 1. FOR STRIPING DETAILS AT GORES, SEE THE MISCELLANEOUS DETAIL SHEET AND THE LATEST EDITION OF THE MUTCD.

2. DIRECTION OF TRAVEL ARROW



NOT TO SCALE

**NORTHBOUND
WEIGH STATION
LAYOUT
SHEET #5**

PROJECT NAME: IRASBURG - DERBY
PROJECT NUMBER: IM 091-3(47)

FILE NAME: p07a148.dgn
PROJECT LEADER: JLL
DESIGNED BY: STANTEC
IPARM FILE: p07a148L05.i

PLOT DATE: 04-DEC-2012 13:4
DRAWN BY: STANTEC
CHECKED BY: STANTEC
SHEET 18 OF 28