
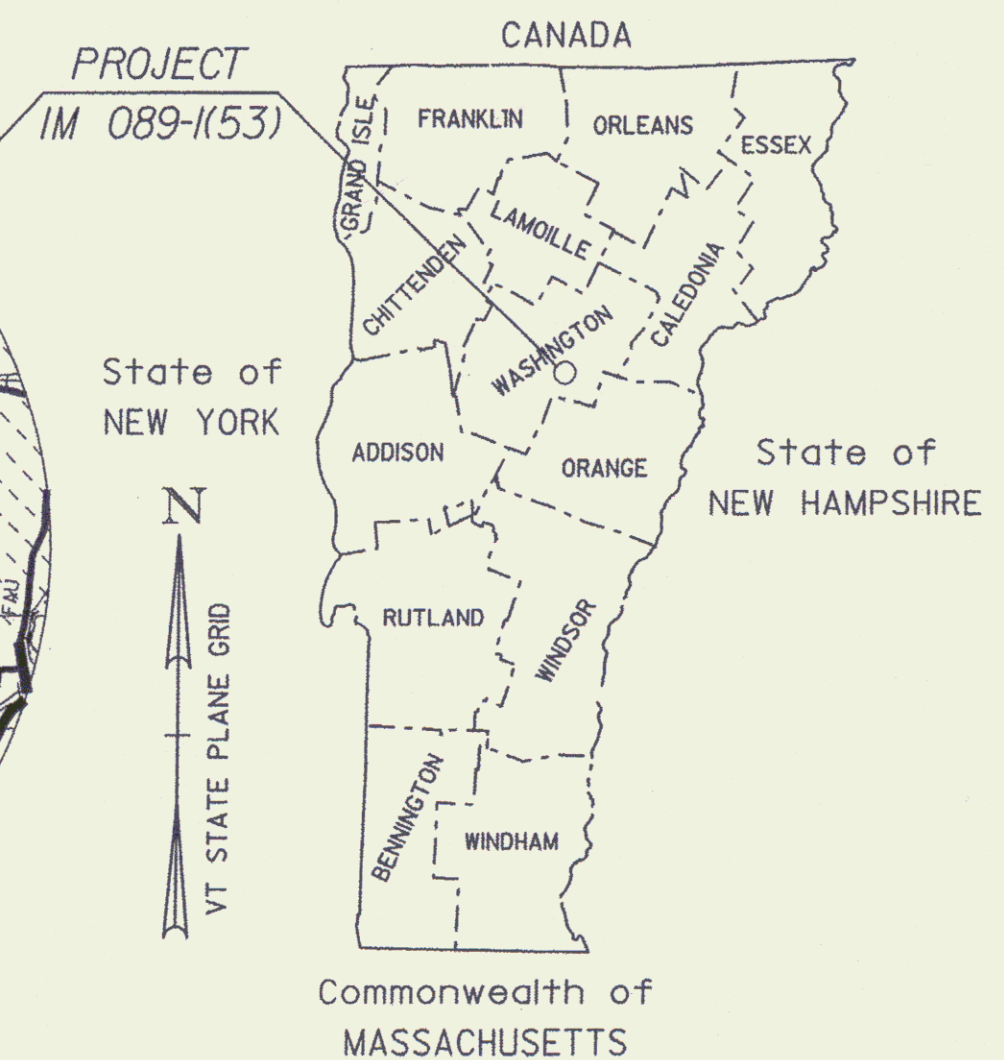
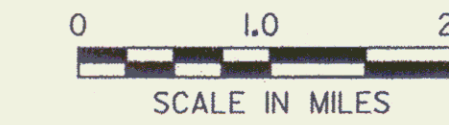


INDEX OF SHEETS  
(SEE SHEET 2)

# STATE OF VERMONT AGENCY OF TRANSPORTATION

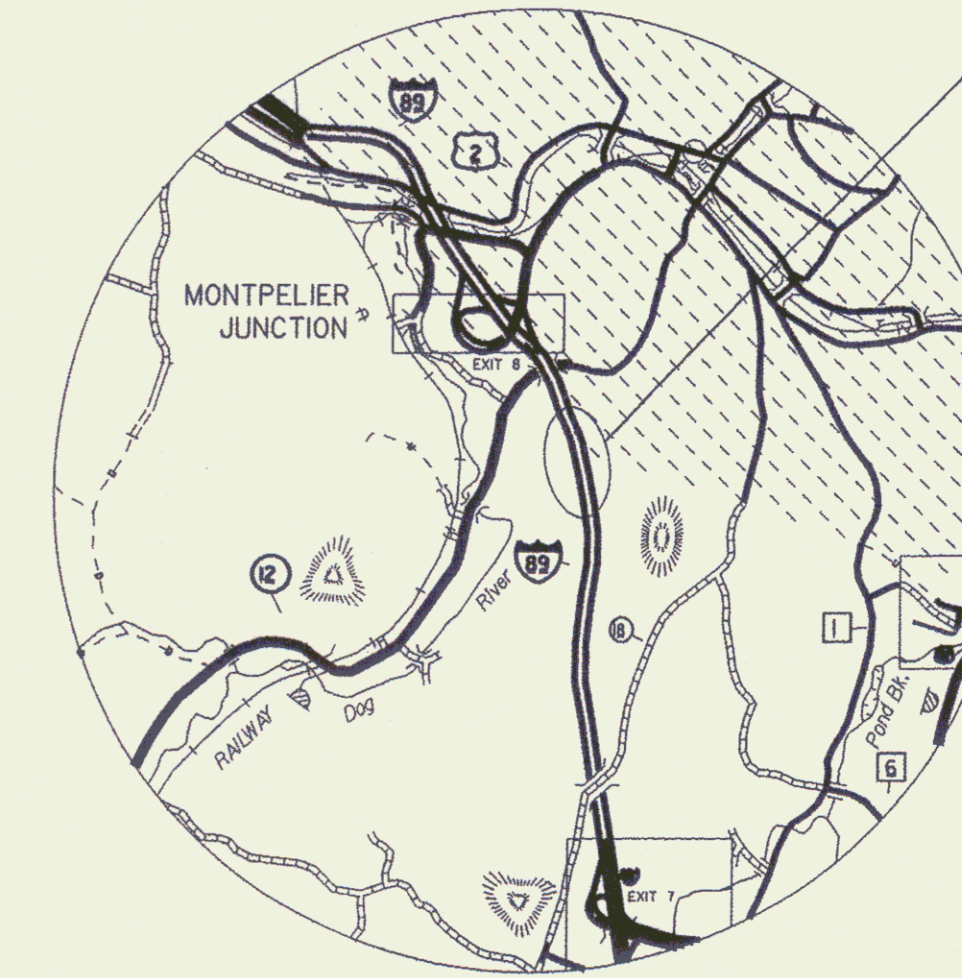


## PROPOSED IMPROVEMENT TOWNS OF BERLIN AND MONTPELIER COUNTY OF WASHINGTON PRINCIPAL ARTERIAL INTERSTATE 89 (NORTHBOUND)

PROJECT LOCATION: BEGINNING AT APPROXIMATELY MM 51.91 AND EXTENDING NORTHERLY 0.32 MILES TO APPROXIMATELY MM 52.23, ADJACENT TO THE NORTHBOUND LANE.  
PROJECT DESCRIPTION: WORK TO BE PERFORMED UNDER THIS PROJECT INCLUDES HAND SCALING, INSTALLATION OF ROCKFALL CATCHMENT FENCE, TRAFFIC CONTROL AND OTHER RELATED ITEMS.  
LENGTH OF PROJECT: 1,690 FT 0.32 MILES

STATION 176+65  
END PROJECT  
IM 089-1(53)

STATION 159+75  
BEGIN PROJECT  
IM 089-1(53)

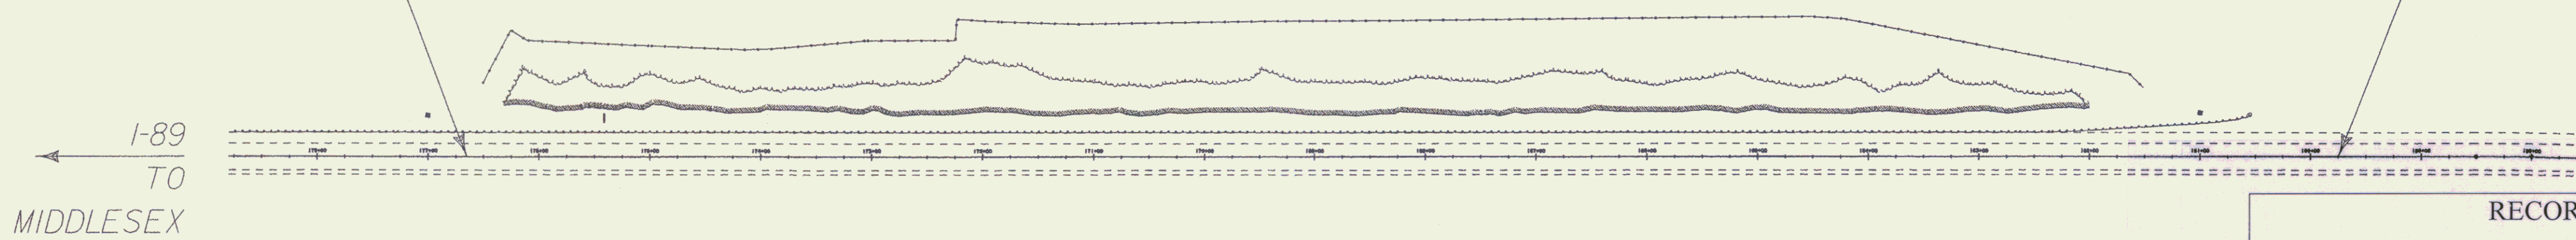


QUALITY ASSURANCE PROGRAM: LEVEL 1

CONVENTIONAL SYMBOLS	
COUNTY LINE	
TOWN LINE	
LIMITS OF ACCESS	
POINT OF ACCESS	
FENCE LINE	
STONE WALL	
TRAVELED WAY	
GUARD RAIL	
RAILROAD	
SURVEY LINE	
CULVERT	
POWER POLE	
TELEPHONE POLE	
TREES	
CONTROL OF ACCESS	
PROPERTY LINE	
R.O.W. TAKING LINE	
SLOPE RIGHTS	
TOP OF CUT	
TOE OF SLOPE	

SURVEYED BY : N/A  
SURVEYED DATE : N/A

DATUM  
VERTICAL N/A  
HORIZONTAL N/A

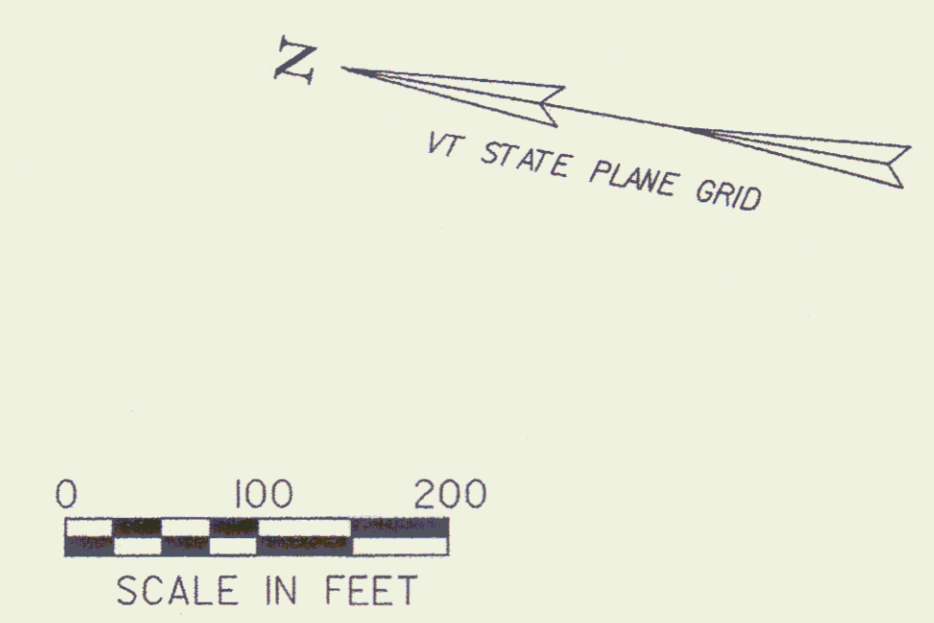

RECORD PLANS	
CONTRACTOR:	WRIGHT CONSTRUCTION, INC.
RESIDENT ENGINEER:	CHARLIE HARDING
CONSTRUCTION BEGAN:	MAY 16, 2011
CONSTRUCTION COMPLETE:	SEPTEMBER 21, 2012
RECORD PLANS BY:	CHARLIE HARDING & STEPHEN KENT
I HEREBY CERTIFY THAT ALL THE CONSTRUCTION REQUIRED BY THIS SET OF DRAWINGS HAS BEEN ACCOMPLISHED AS INDICATED HEREIN.	
BY	RESIDENT ENGINEER
DATE	6/3/13
NOTE: Any further information concerning final quantities, amounts or other details relative to this project may be found at Central Files in the electronic archives.	

THESE PLANS ARE SUBJECT TO SUCH ENGINEERING CHANGES AS MAY BE REQUIRED BY THE FEDERAL HIGHWAY ADMINISTRATION OR THE DIRECTOR OF PROGRAM DEVELOPMENT.  
CONSTRUCTION IS TO BE CARRIED ON IN ACCORDANCE WITH THESE PLANS AND THE STANDARD SPECIFICATIONS FOR CONSTRUCTION DATED 2006, AS APPROVED BY THE FEDERAL HIGHWAY ADMINISTRATION ON JUNE 15, 2006 FOR USE ON THIS PROJECT, INCLUDING ALL SUBSEQUENT REVISIONS AND SUCH REVISED SPECIFICATIONS AND SPECIAL PROVISIONS AS ARE INCORPORATED IN THESE PLANS.

DIRECTOR OF PROGRAM DEVELOPMENT	
APPROVED	DATE 10-13-11
PROJECT MANAGER : KEN ROBE	
PROJECT NAME :	BERLIN - MONTPELIER
PROJECT NUMBER :	IM 089-1(53)
SHEET 1 OF 29 SHEETS	