



STA. 163+50




STA. 163+00



STA. 162+50




STA. 162+00

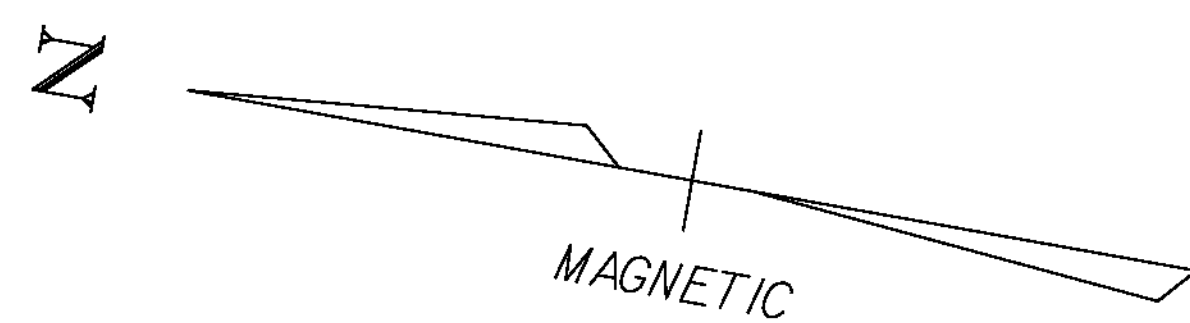


900.640 - SPECIAL PROVISION (ROCKFALL BARRIER FENCE)
STA. 162+00 RT TO STA. 163+75 RT (DITCH)

621.75 - REMOVE AND RESET GUARDRAIL
STA. 161+45 RT TO STA. 163+75 RT

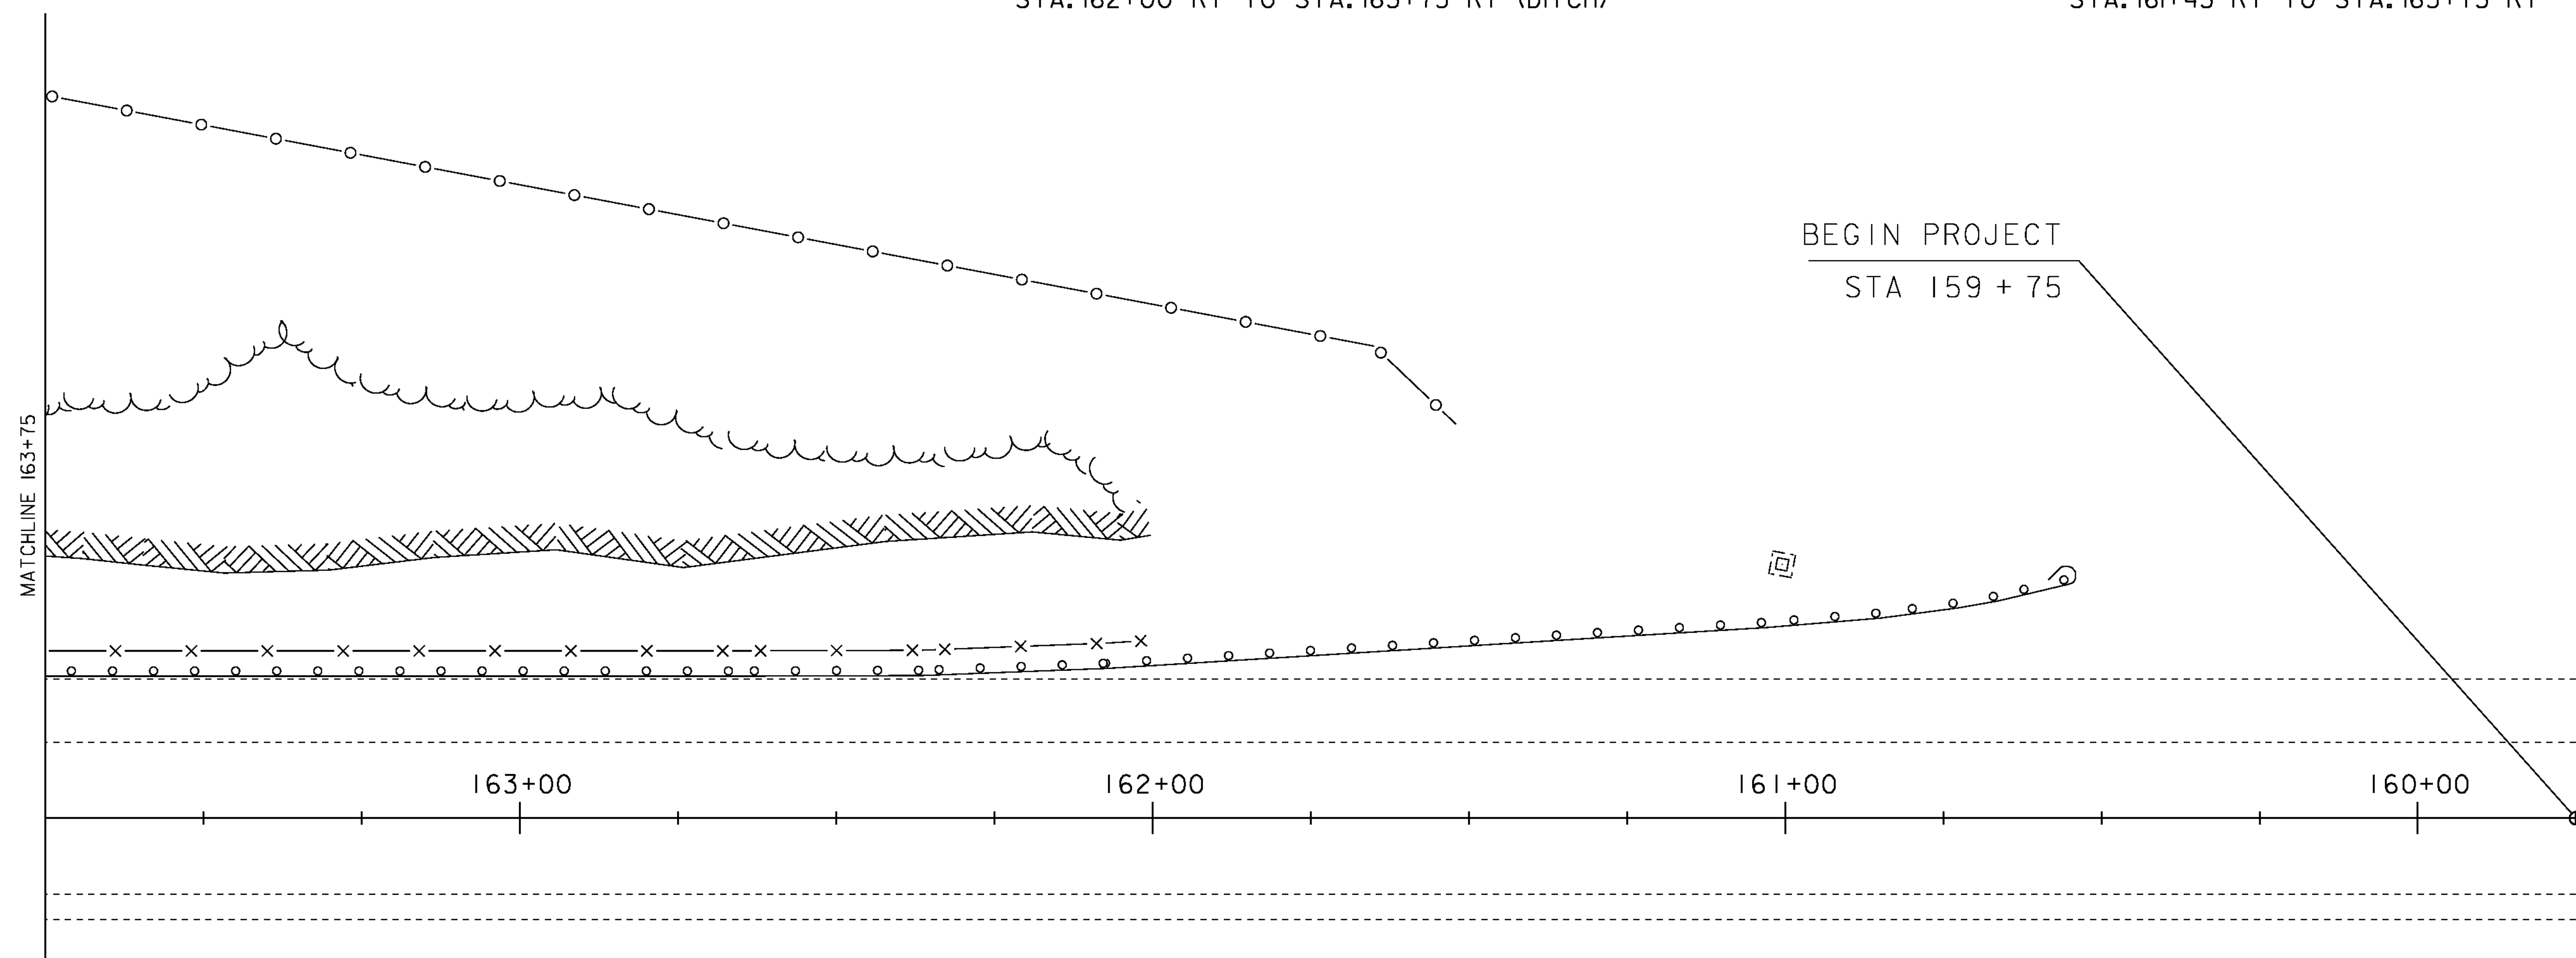

LEGEND	
-x-x-x-	ROCKFALL BARRIER FENCE
-o-o-o-	EXISTING CHAIN LINK FENCE
-o-o-o-	EXISTING GUARDRAIL

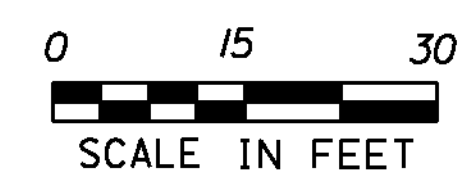

PROJECT NAME: BERLIN - MONTPELIER	PLOT DATE: 19-OCT-2011
PROJECT NUMBER: IM 089-1(53)	DRAWN BY: I. SHEA
DESIGNED BY: P. PELOQUIN	CHECKED BY: S. MENARD
LAYOUT SHEET 1	SHEET 7 OF 29