




STA. 167+50

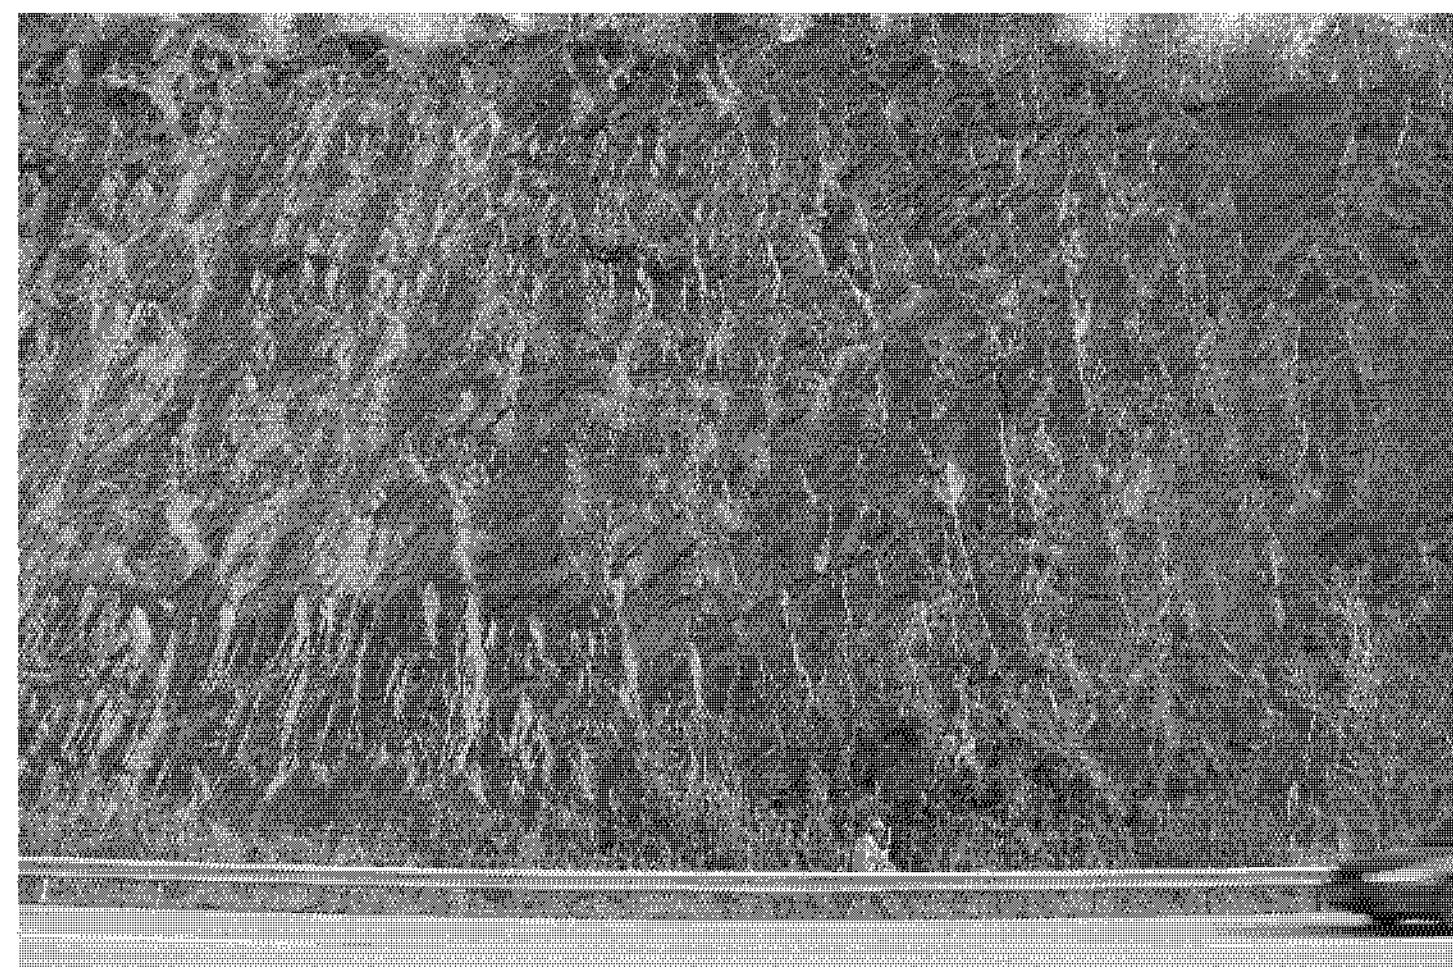


STA. 167+00

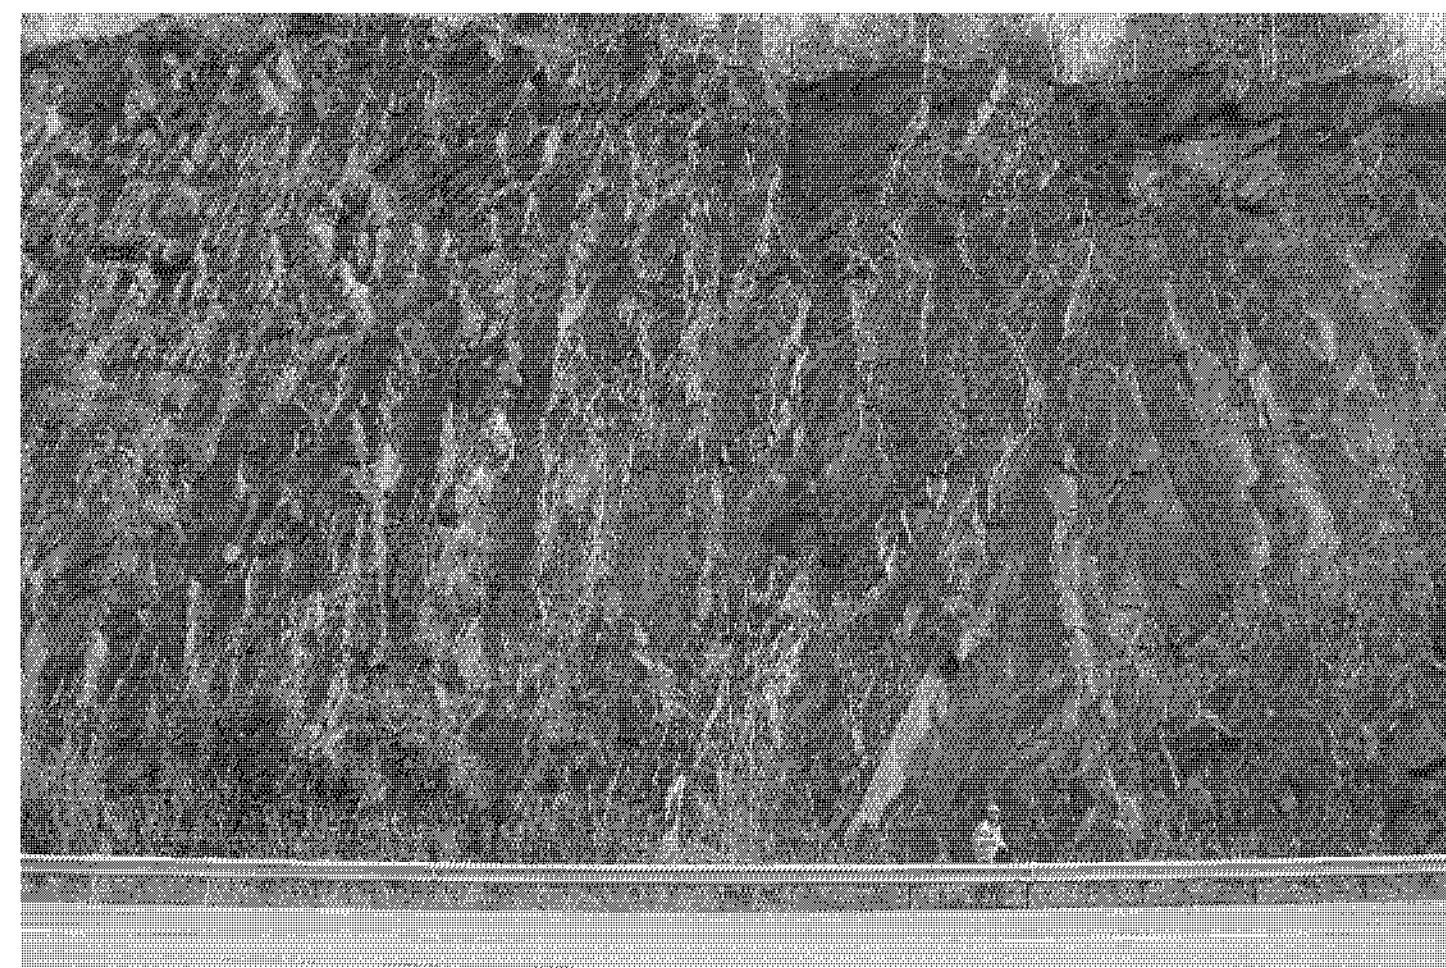

STA. 166+50

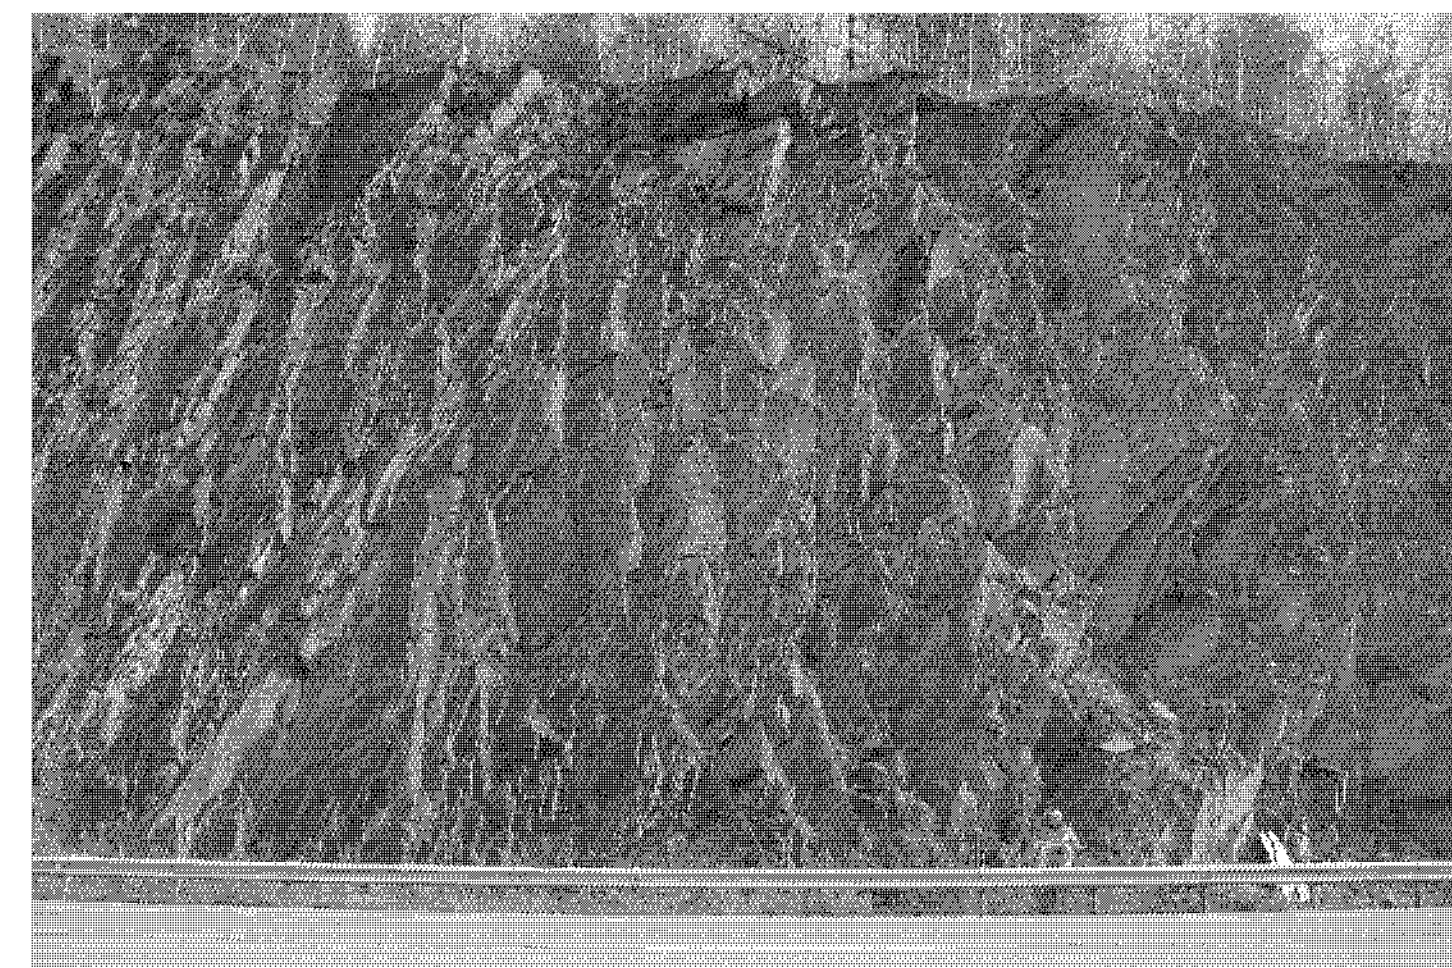


STA. 166+00

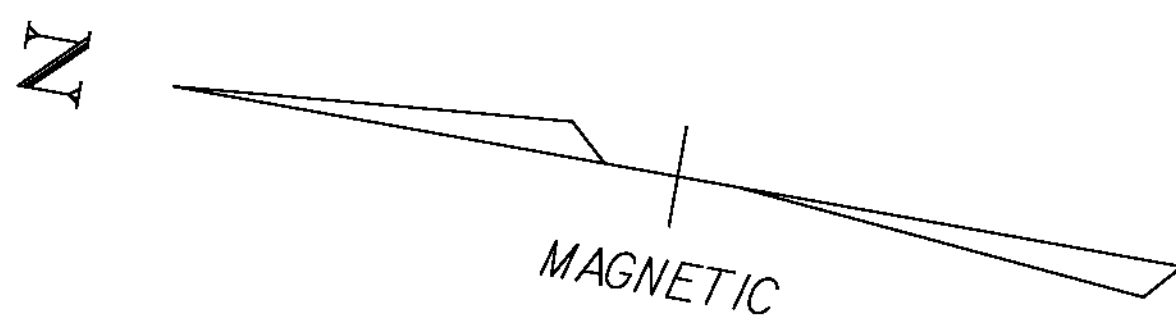


900.640 - SPECIAL PROVISION (ROCKFALL BARRIER FENCE)  
STA. 165+75 RT TO STA. 167+75 RT (DITCH)

621.75 - REMOVE AND RESET GUARDRAIL  
STA. 165+75 RT TO STA. 167+75 RT

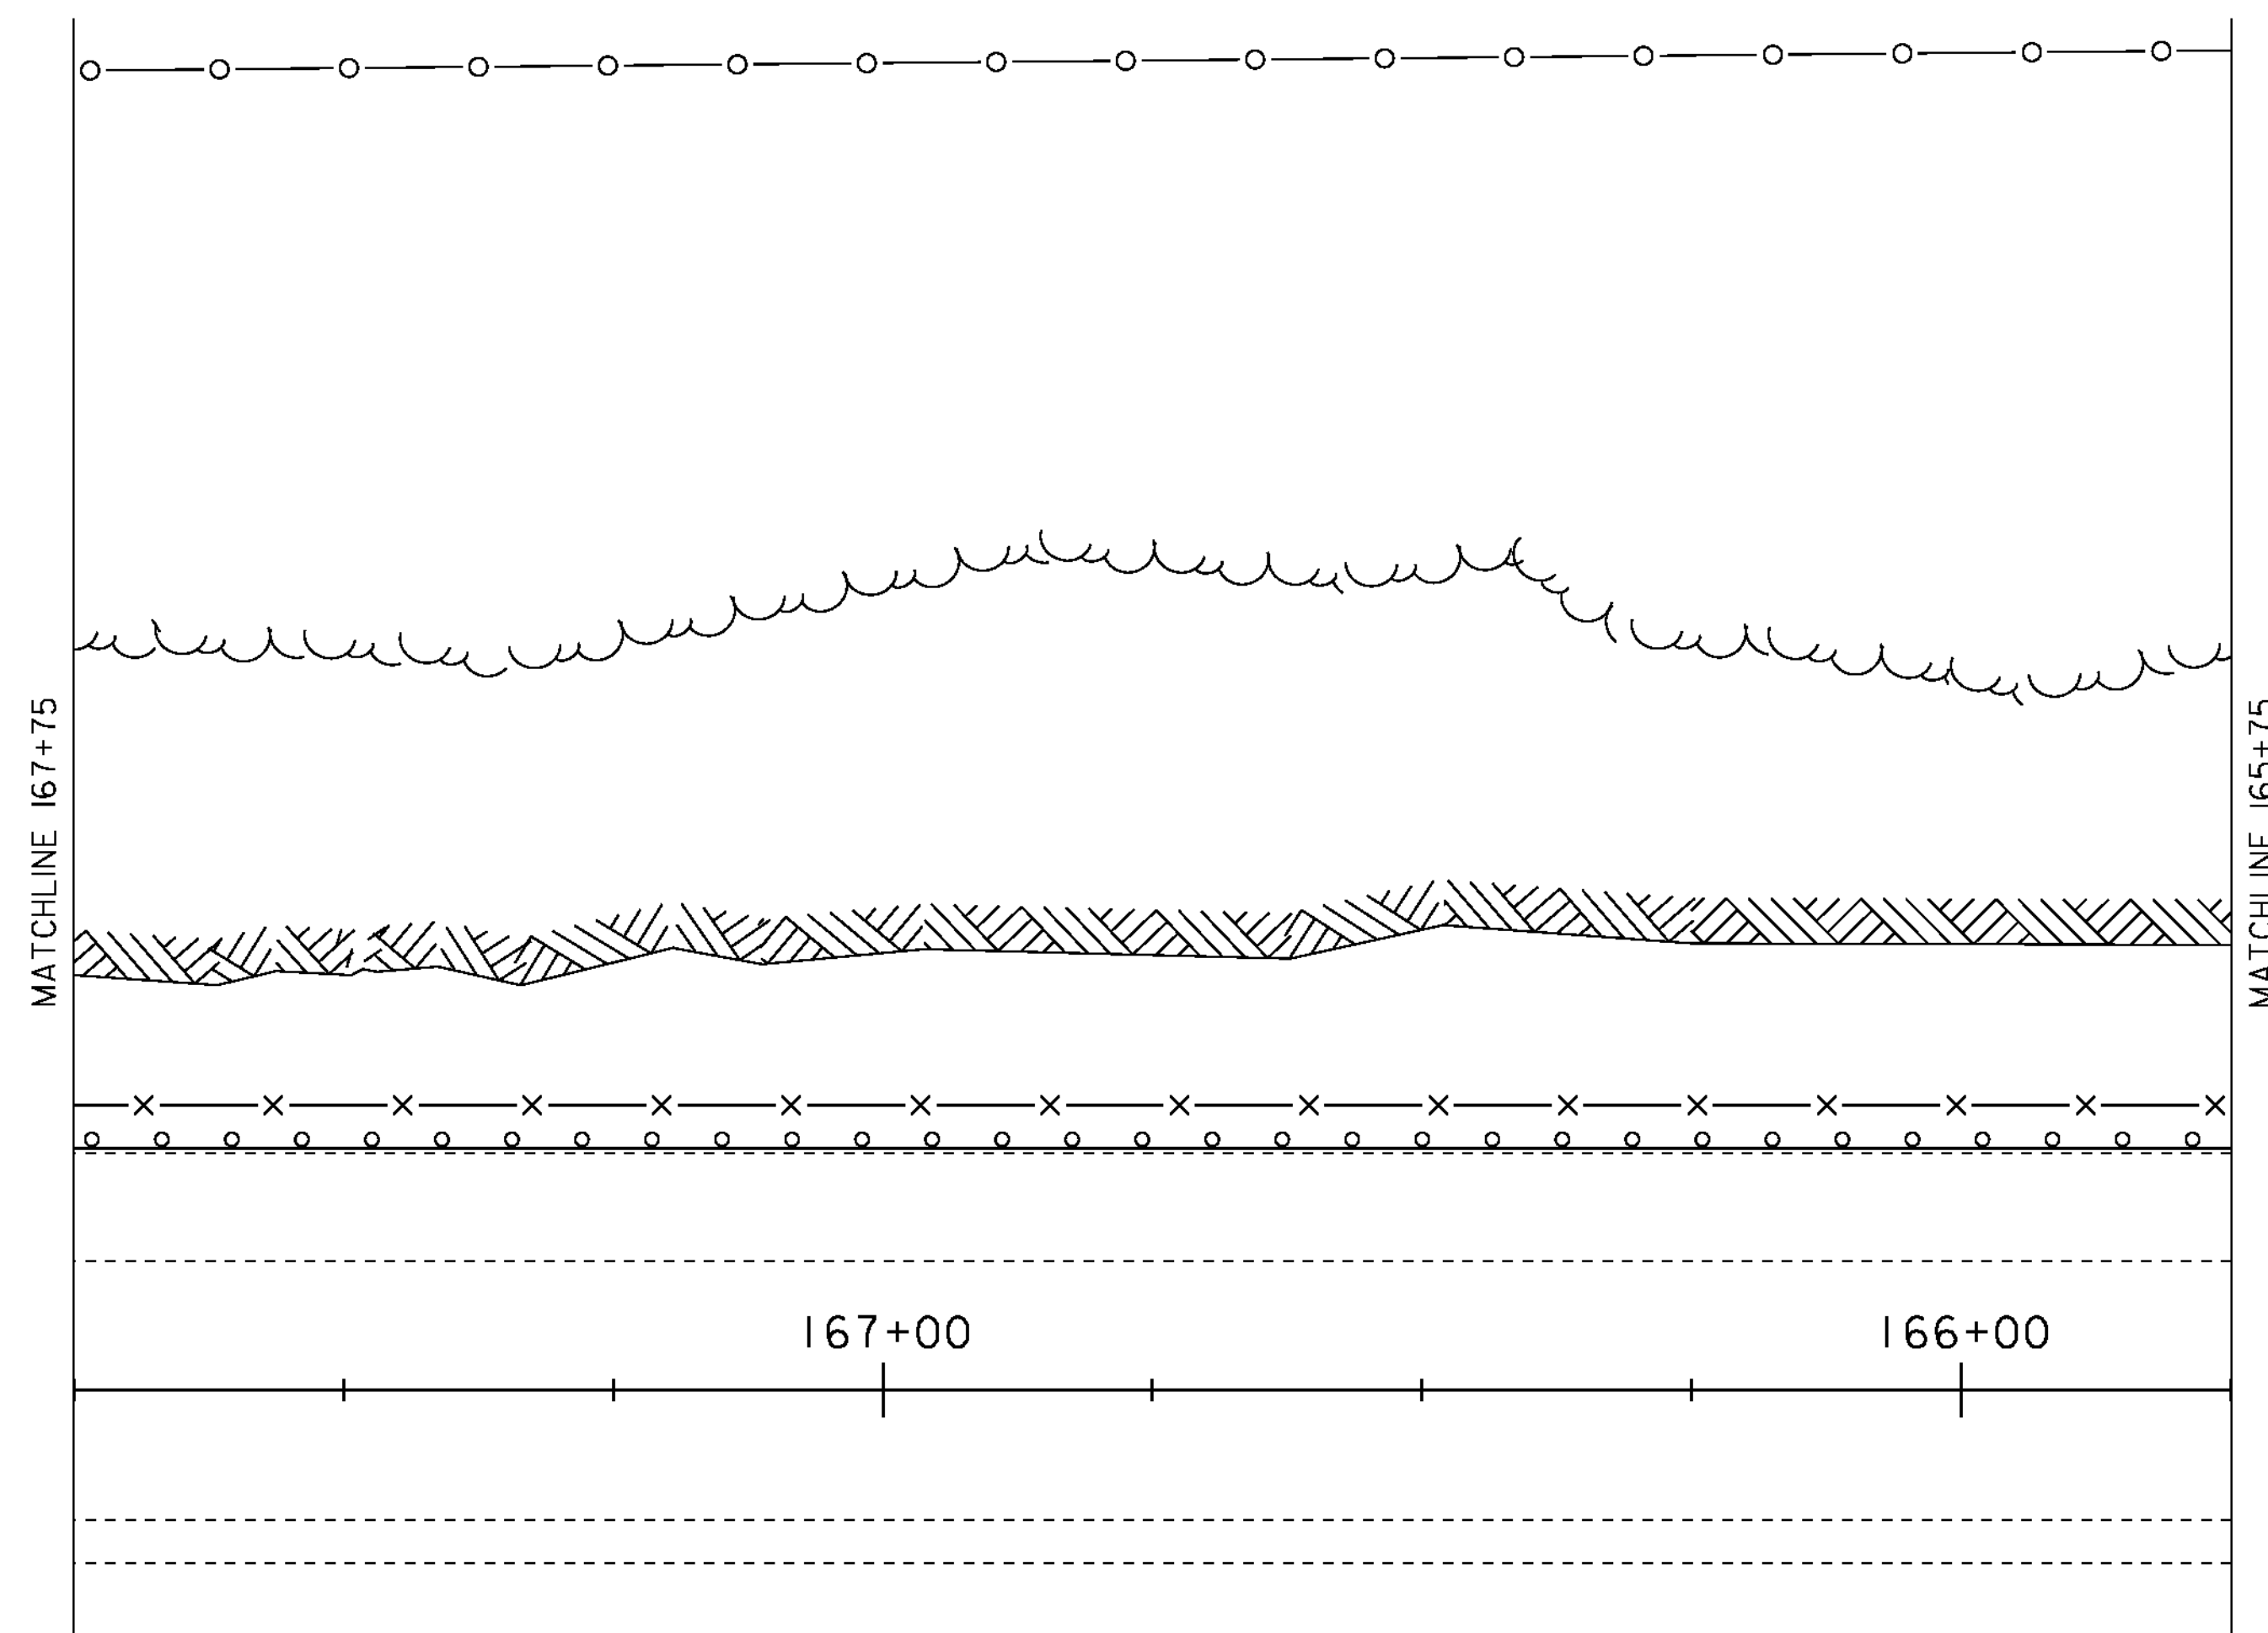

LEGEND	
-x-x-x-	ROCKFALL BARRIER FENCE
-o-o-o-	EXISTING CHAIN LINK FENCE
-o-o-o-	EXISTING GUARDRAIL

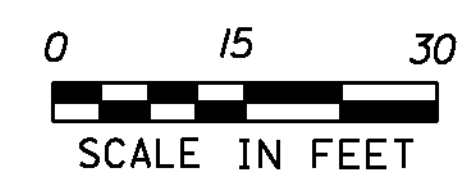

PROJECT NAME:	BERLIN - MONTPELIER
PROJECT NUMBER:	IM 089-1(53)
FILE NAME:	07A150/DESIGN/D07A150LAY.DGN
PROJECT LEADER:	K. ROBIE
DESIGNED BY:	P. PELOQUIN
LAYOUT SHEET	3
PLOT DATE:	19-OCT-2011
DRAWN BY:	I. SHEA
CHECKED BY:	S. MENARD
SHEET	9 OF 29