



BEGIN PROJECT  
STA 159 + 75

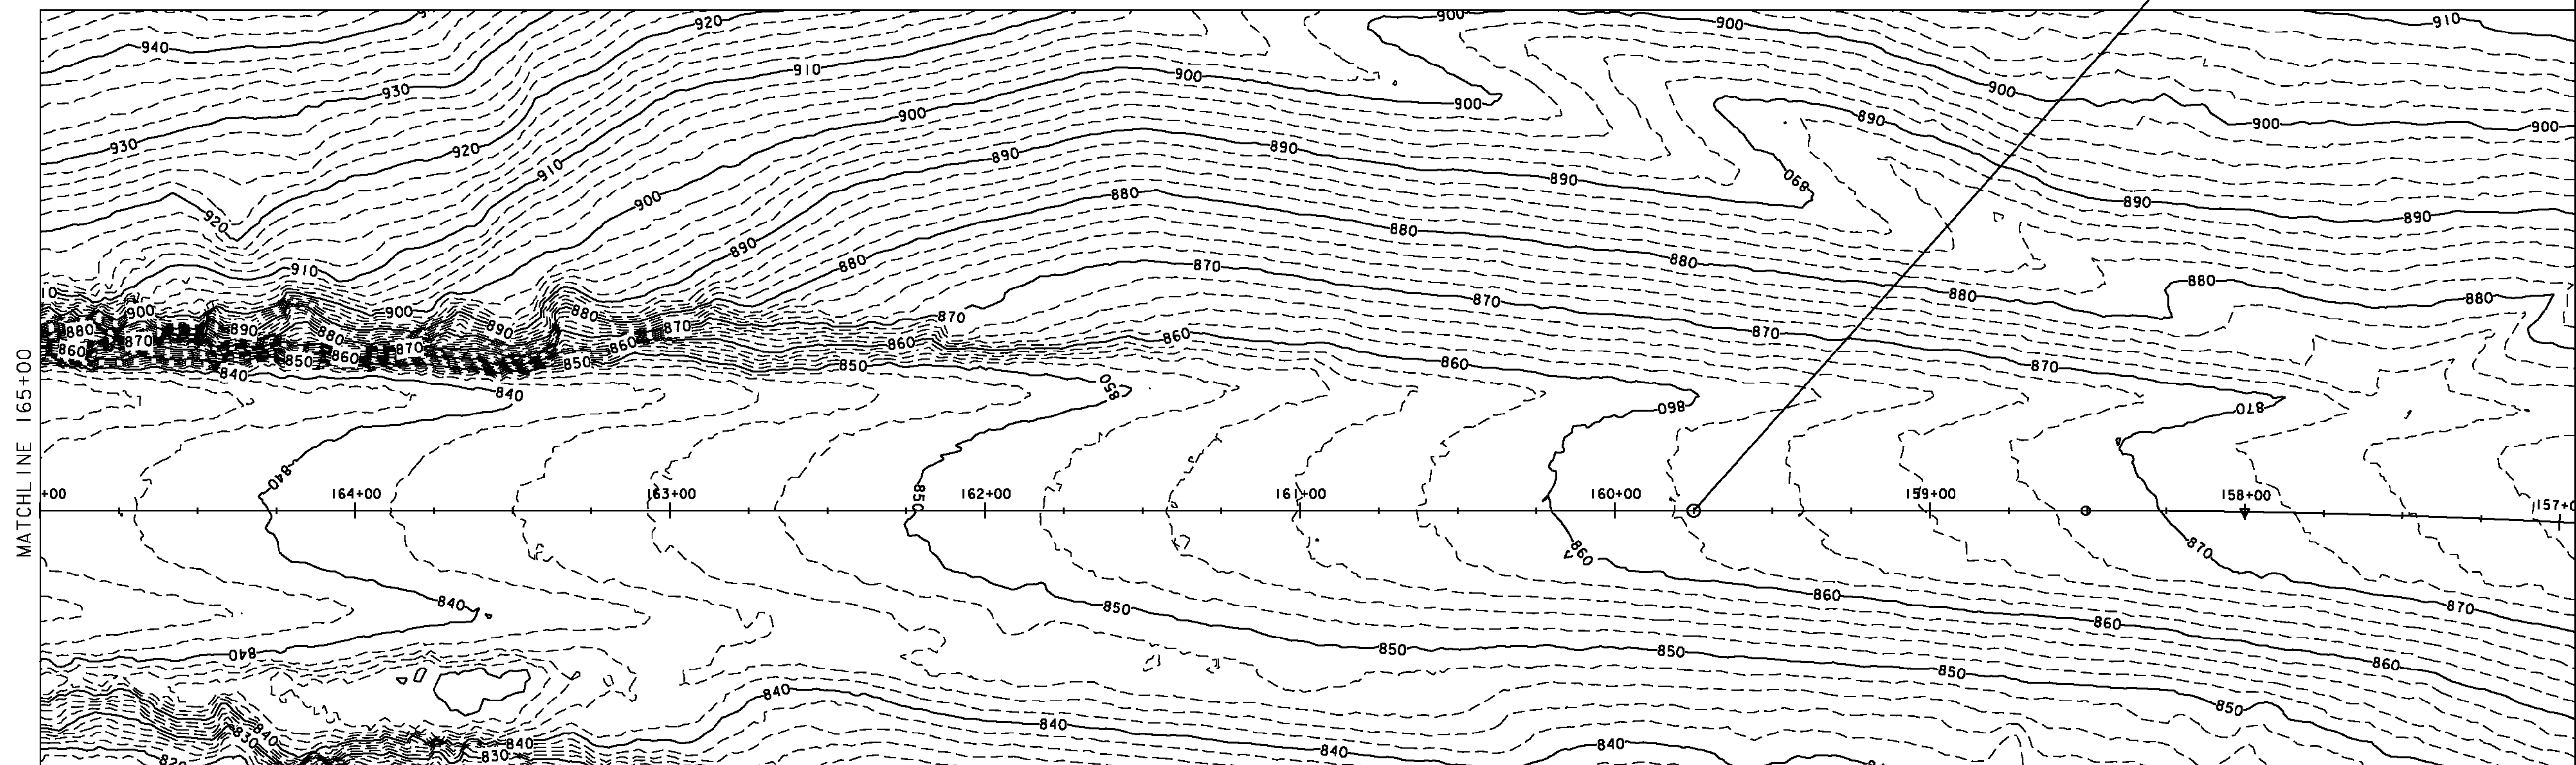

MATCHLINE 165+00

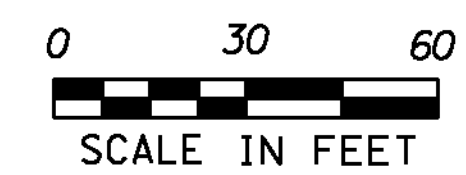

PROJECT NAME:	BERLIN - MONTPELIER
PROJECT NUMBER:	IM 089-1(53)
FILE NAME:	07A150/DESIGN/D07A150BDR.DGN
PROJECT LEADER:	K. ROBIE
DESIGNED BY:	P. PELOQUIN
EXISTING CONDITIONS LAYOUT SHEET 1	
PLOT DATE:	19-OCT-2011
DRAWN BY:	I. SHEA
CHECKED BY:	S. MENARD
SHEET	17 OF 29