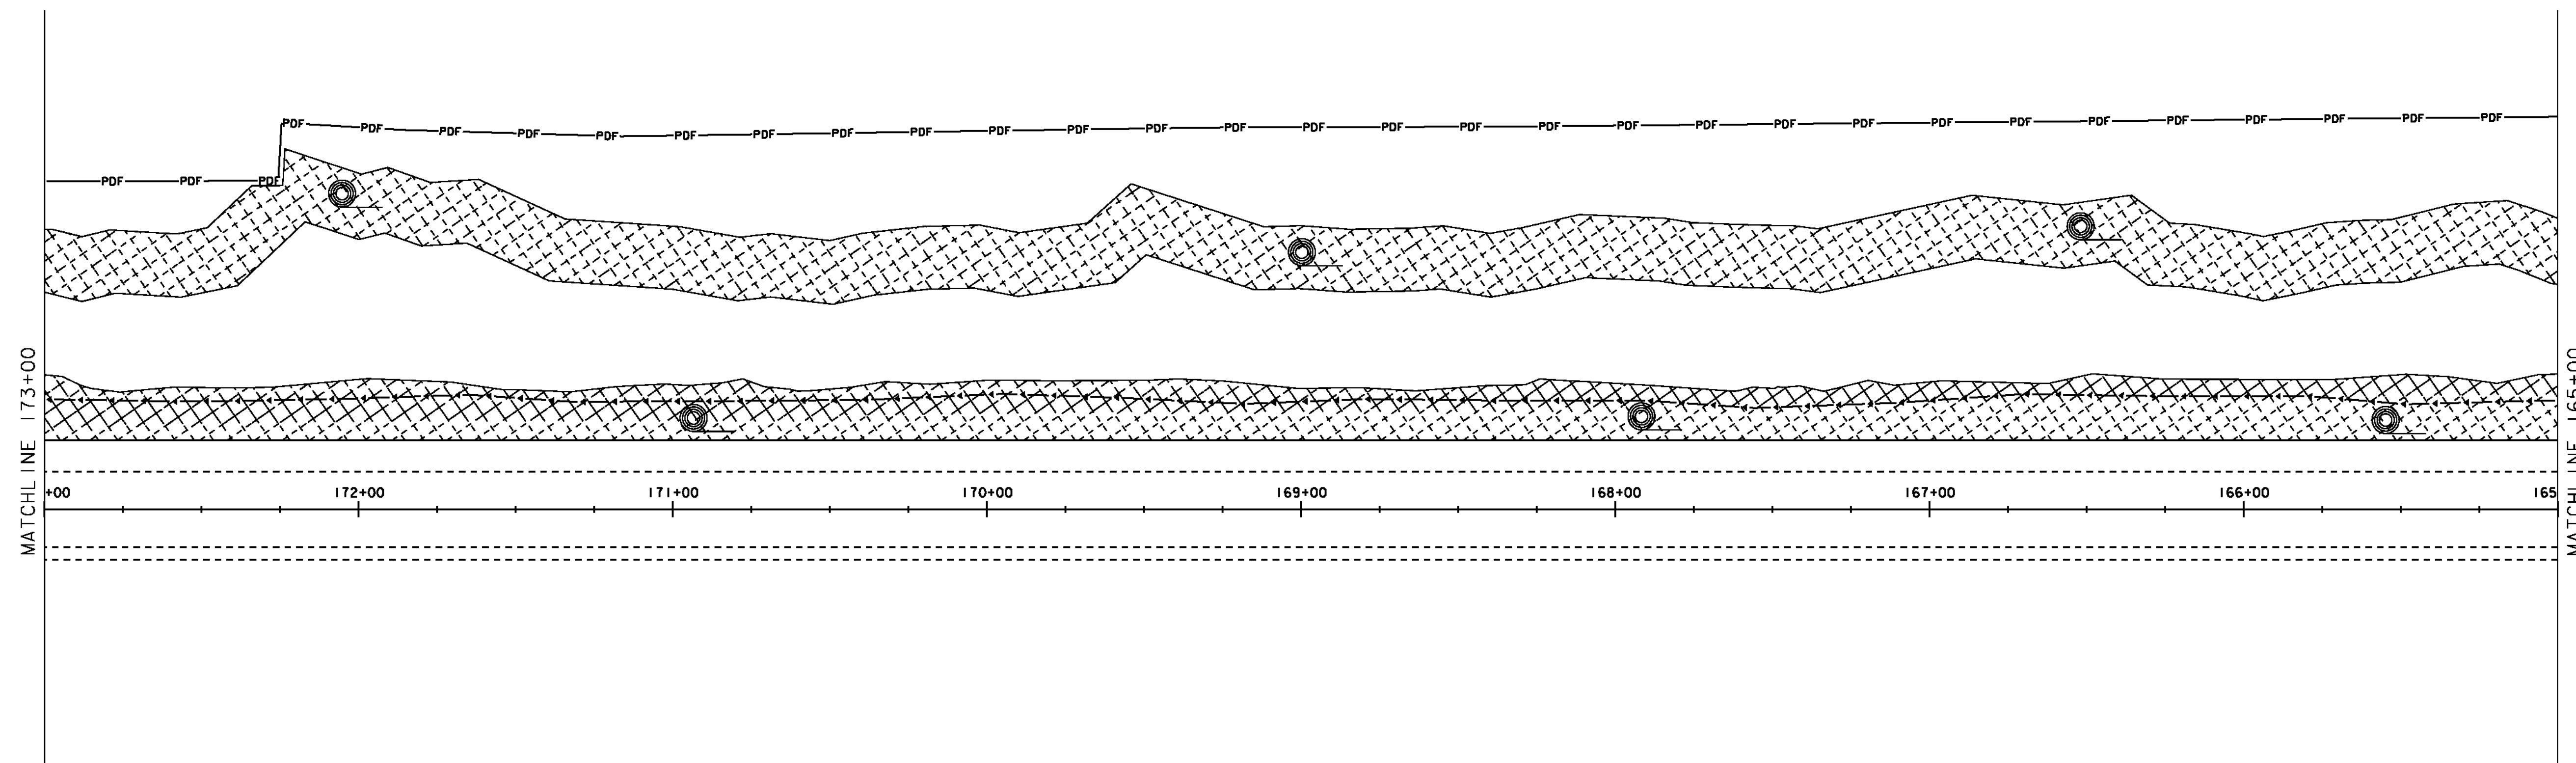


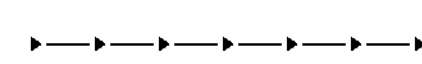
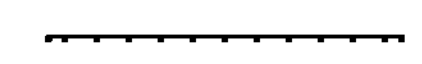


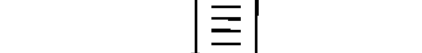
653.20 - TEMPORARY EROSION MATTING
 STA. 165+00 RT TO STA. 173+00 RT (DITCH)
 STA. 165+00 RT TO STA. 173+00 RT (CREST OF LEDGE)

653.55 - PROJECT DEMARCATION FENCE
 STA. 165+00 RT TO STA. 173+00 RT (818 FT)

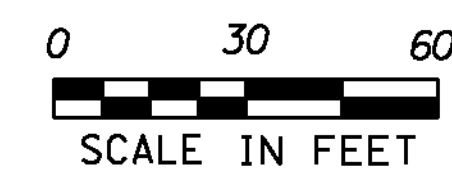
653.25 - TEMPORARY STONE CHECK DAM, TYPE 1
 STA. 165+00 RT TO STA. 173+00 RT (20 CHECK DAMS)



LEGEND

-  CHECK DAMS
-  SILT FENCE
-  EROSION MATTING/LIMITS OF DISTURBANCE
-  PROJECT DEMARCATION FENCE
-  DROP INLET PROTECTION

AREA OF DISTURBANCE
 CREST OF LEDGE: 16,557 SF: 0.380 ACRES
 DITCH: 14,445 SF: 0.332 ACRES
 SHEET TOTAL: 31,002 SF: 0.712 ACRES
 PROJECT TOTAL: 70,589 SF: 1.621 ACRES



PROJECT NAME: BERLIN - MONTPELIER
 PROJECT NUMBER: IM 089-1(53)

FILE NAME: 07A150/DESIGN/D07A150BDR.DGN PLOT DATE: 19-OCT-2011
 PROJECT LEADER: K. ROBIE DRAWN BY: I. SHEA
 DESIGNED BY: P. PELOQUIN CHECKED BY: S. MENARD
 EPSC LAYOUT SHEET 2 SHEET 21 OF 29