
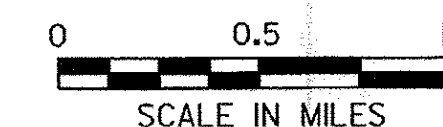
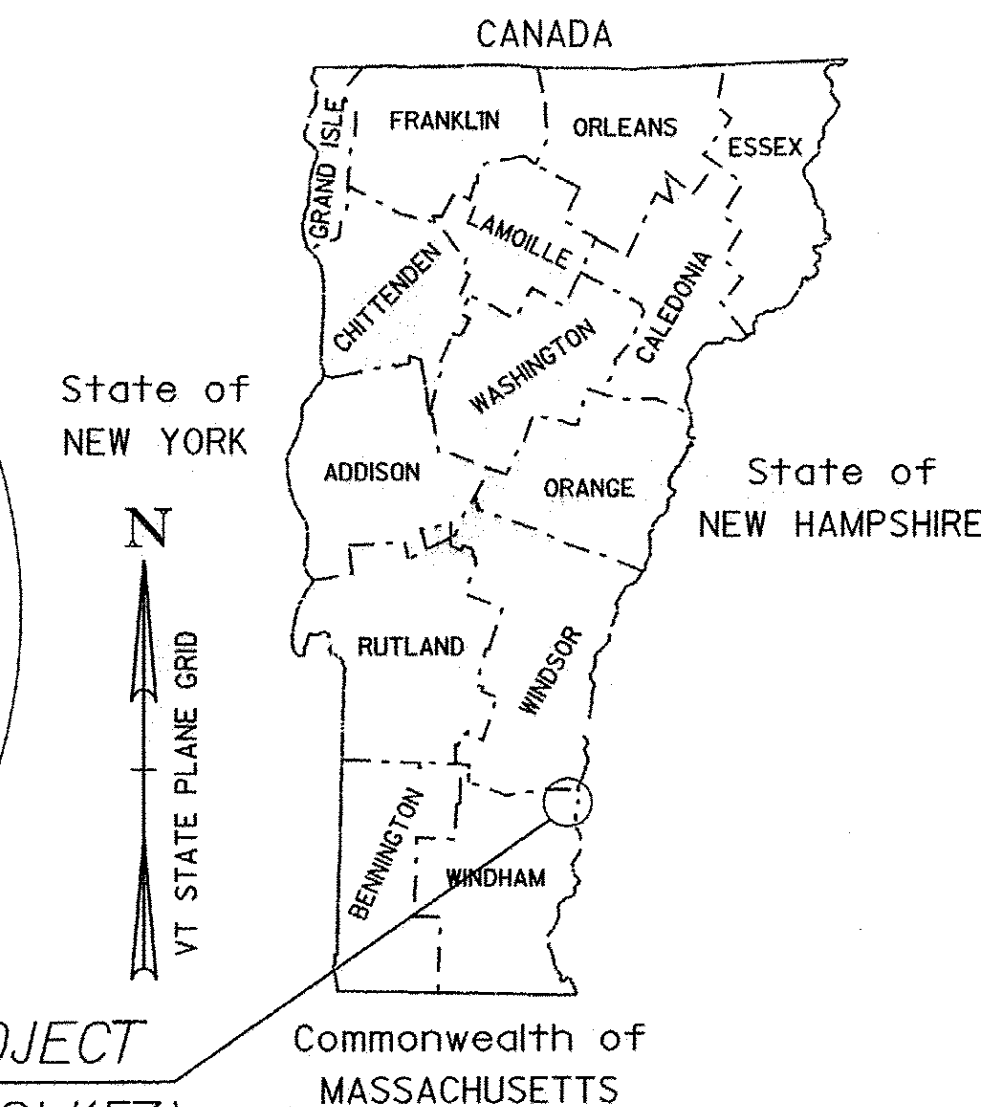


INDEX OF SHEETS  
(SEE SHEET 2)

# STATE OF VERMONT AGENCY OF TRANSPORTATION

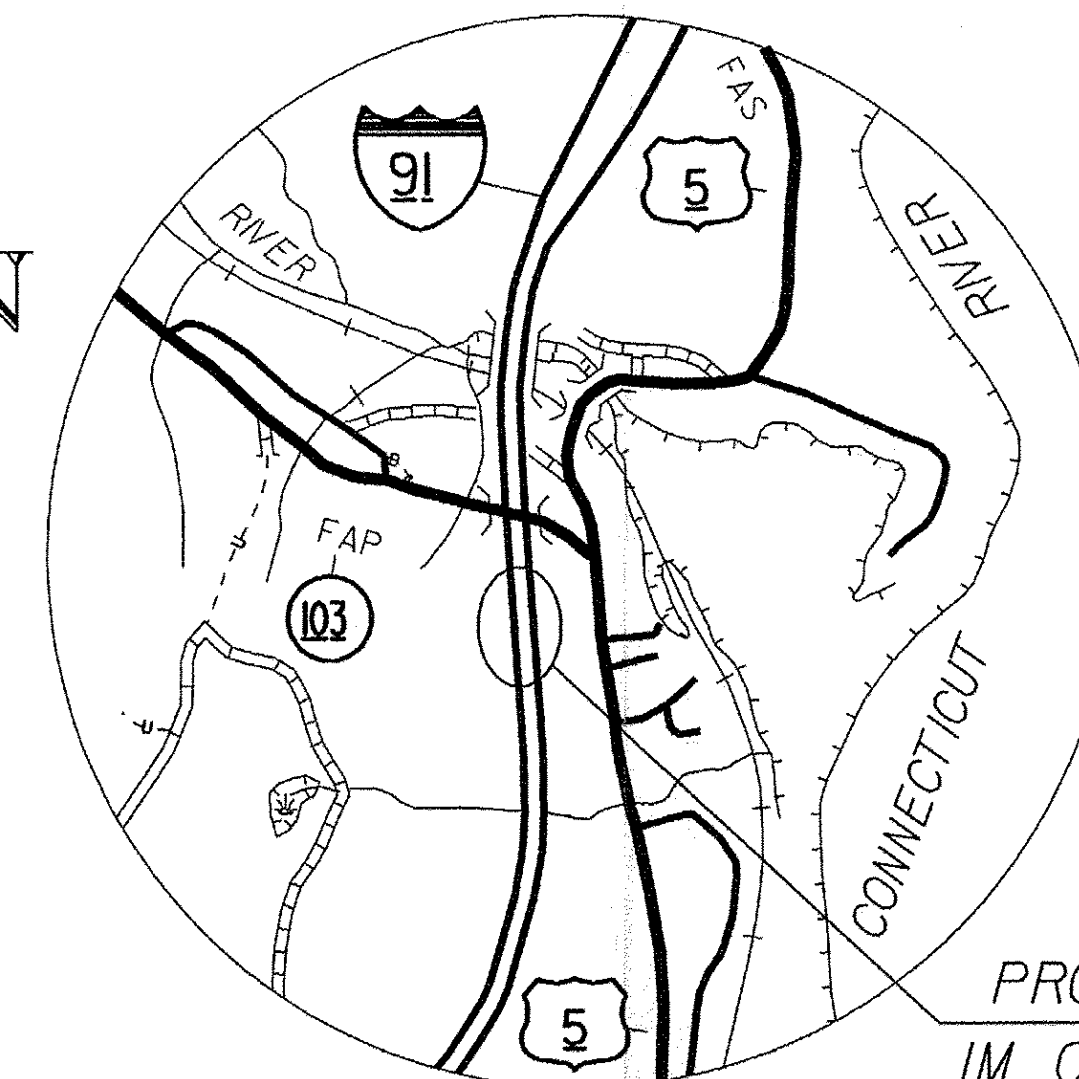

RECORD PLANS	
CONTRACTOR:	WINTerset, INC. - LYNDONVILLE, VT
RESIDENT ENGINEER:	PAUL PERRY
CONSTRUCTION BEGAN:	SEPTEMBER 7, 2010
CONSTRUCTION COMPLETE:	DECEMBER 2, 2010
RECORD PLANS BY:	PAUL PERRY & NICK GARBACIK
I HEREBY CERTIFY THAT ALL THE CONSTRUCTION REQUIRED BY THIS SET OF DRAWINGS HAS BEEN ACCOMPLISHED AS INDICATED HEREIN.	
BY:	<i>Paul K. Perry</i> RESIDENT ENGINEER
DATE:	6-12-13
NOTE: Any further information concerning final quantities, amounts or other details relative to this project may be found at Central Files in the electronic archives.	

## PROPOSED IMPROVEMENT TOWN OF ROCKINGHAM COUNTY OF WINDHAM

### PRINCIPLE ARTERIAL - INTERSTATE 91 (NORTHBOUND)


PROJECT LOCATION: BEGINNING AT APPROXIMATELY MM 34.70 AND EXTENDING NORTHERLY 0.42 MILES TO APPROXIMATELY MM 35.12, ADJACENT TO THE NORTHBOUND LANE.

PROJECT DESCRIPTION: WORK TO BE PERFORMED UNDER THIS PROJECT INCLUDES ROCK SCALING, ROCK DOWELING, TRIM BLASTING, SHOTCRETING, DITCHING, DRAINAGE, TRAFFIC CONTROL AND OTHER RELATED ITEMS.

LENGTH OF PROJECT: 2,200 FT      0.42 MILES

STATION 1860+00  
END PROJECT  
IM 091 - 1(57)

STATION 1838+00  
BEGIN PROJECT  
IM 091 - 1(57)

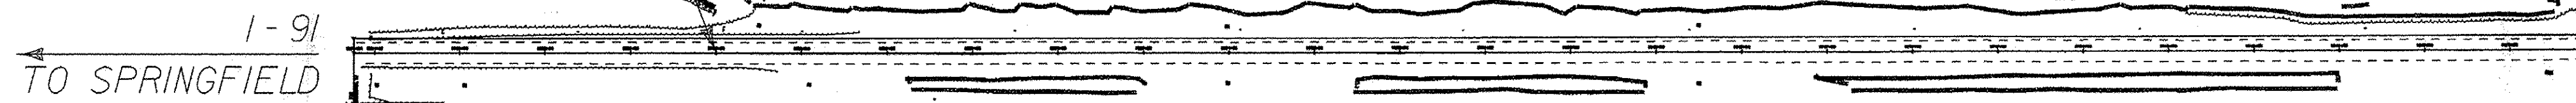


#### CONVENTIONAL SYMBOLS

COUNTY LINE	
TOWN LINE	
LIMITS OF ACCESS	
POINT OF ACCESS	
FENCE LINE	
STONE WALL	
TRAVELED WAY	
GUARD RAIL	
RAILROAD	
SURVEY LINE	
CULVERT	
POWER POLE	
TELEPHONE POLE	
TREES	
CONTROL OF ACCESS	
PROPERTY LINE	
R.O.W. TAKING LINE	
SLOPE RIGHTS	
TOP OF CUT	
TOE OF SLOPE	

SURVEYED BY : VTRANS  
SURVEYED DATE : 2008

DATUM  
VERTICAL      NAVD88  
HORIZONTAL    NAD83(CORS96)

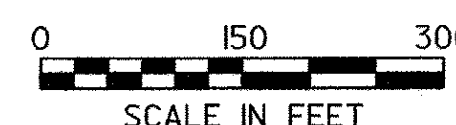

THESE PLANS ARE SUBJECT TO SUCH ENGINEERING CHANGES AS MAY BE REQUIRED BY THE FEDERAL HIGHWAY ADMINISTRATION OR THE DIRECTOR OF PROGRAM DEVELOPMENT.

CONSTRUCTION IS TO BE CARRIED ON IN ACCORDANCE WITH THESE PLANS AND THE STANDARD SPECIFICATIONS FOR CONSTRUCTION DATED 2006, AS APPROVED BY THE FEDERAL HIGHWAY ADMINISTRATION ON JUNE 15, 2006 FOR USE ON THIS PROJECT, INCLUDING ALL SUBSEQUENT REVISIONS AND SUCH REVISED SPECIFICATIONS AND SPECIAL PROVISIONS AS ARE INCORPORATED IN THESE PLANS.

DIRECTOR OF PROGRAM DEVELOPMENT	
APPROVED:	<i>Richard Stewart</i> DATE 5-25-10
PROJECT MANAGER :	KEN ROBIE
PROJECT NAME :	ROCKINGHAM
PROJECT NUMBER :	IM 091-1(57)
SHEET 1 OF 78 SHEETS	