







STA. 1846+00



STA. 1845+50



STA. 1845+00

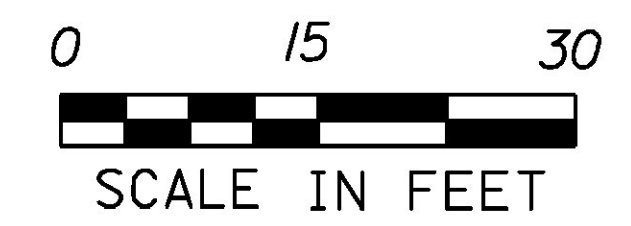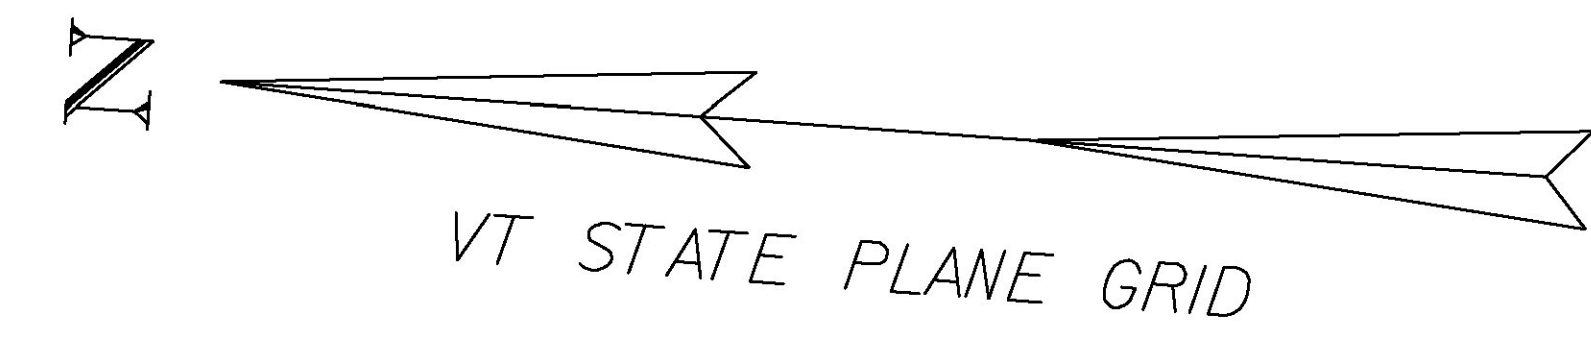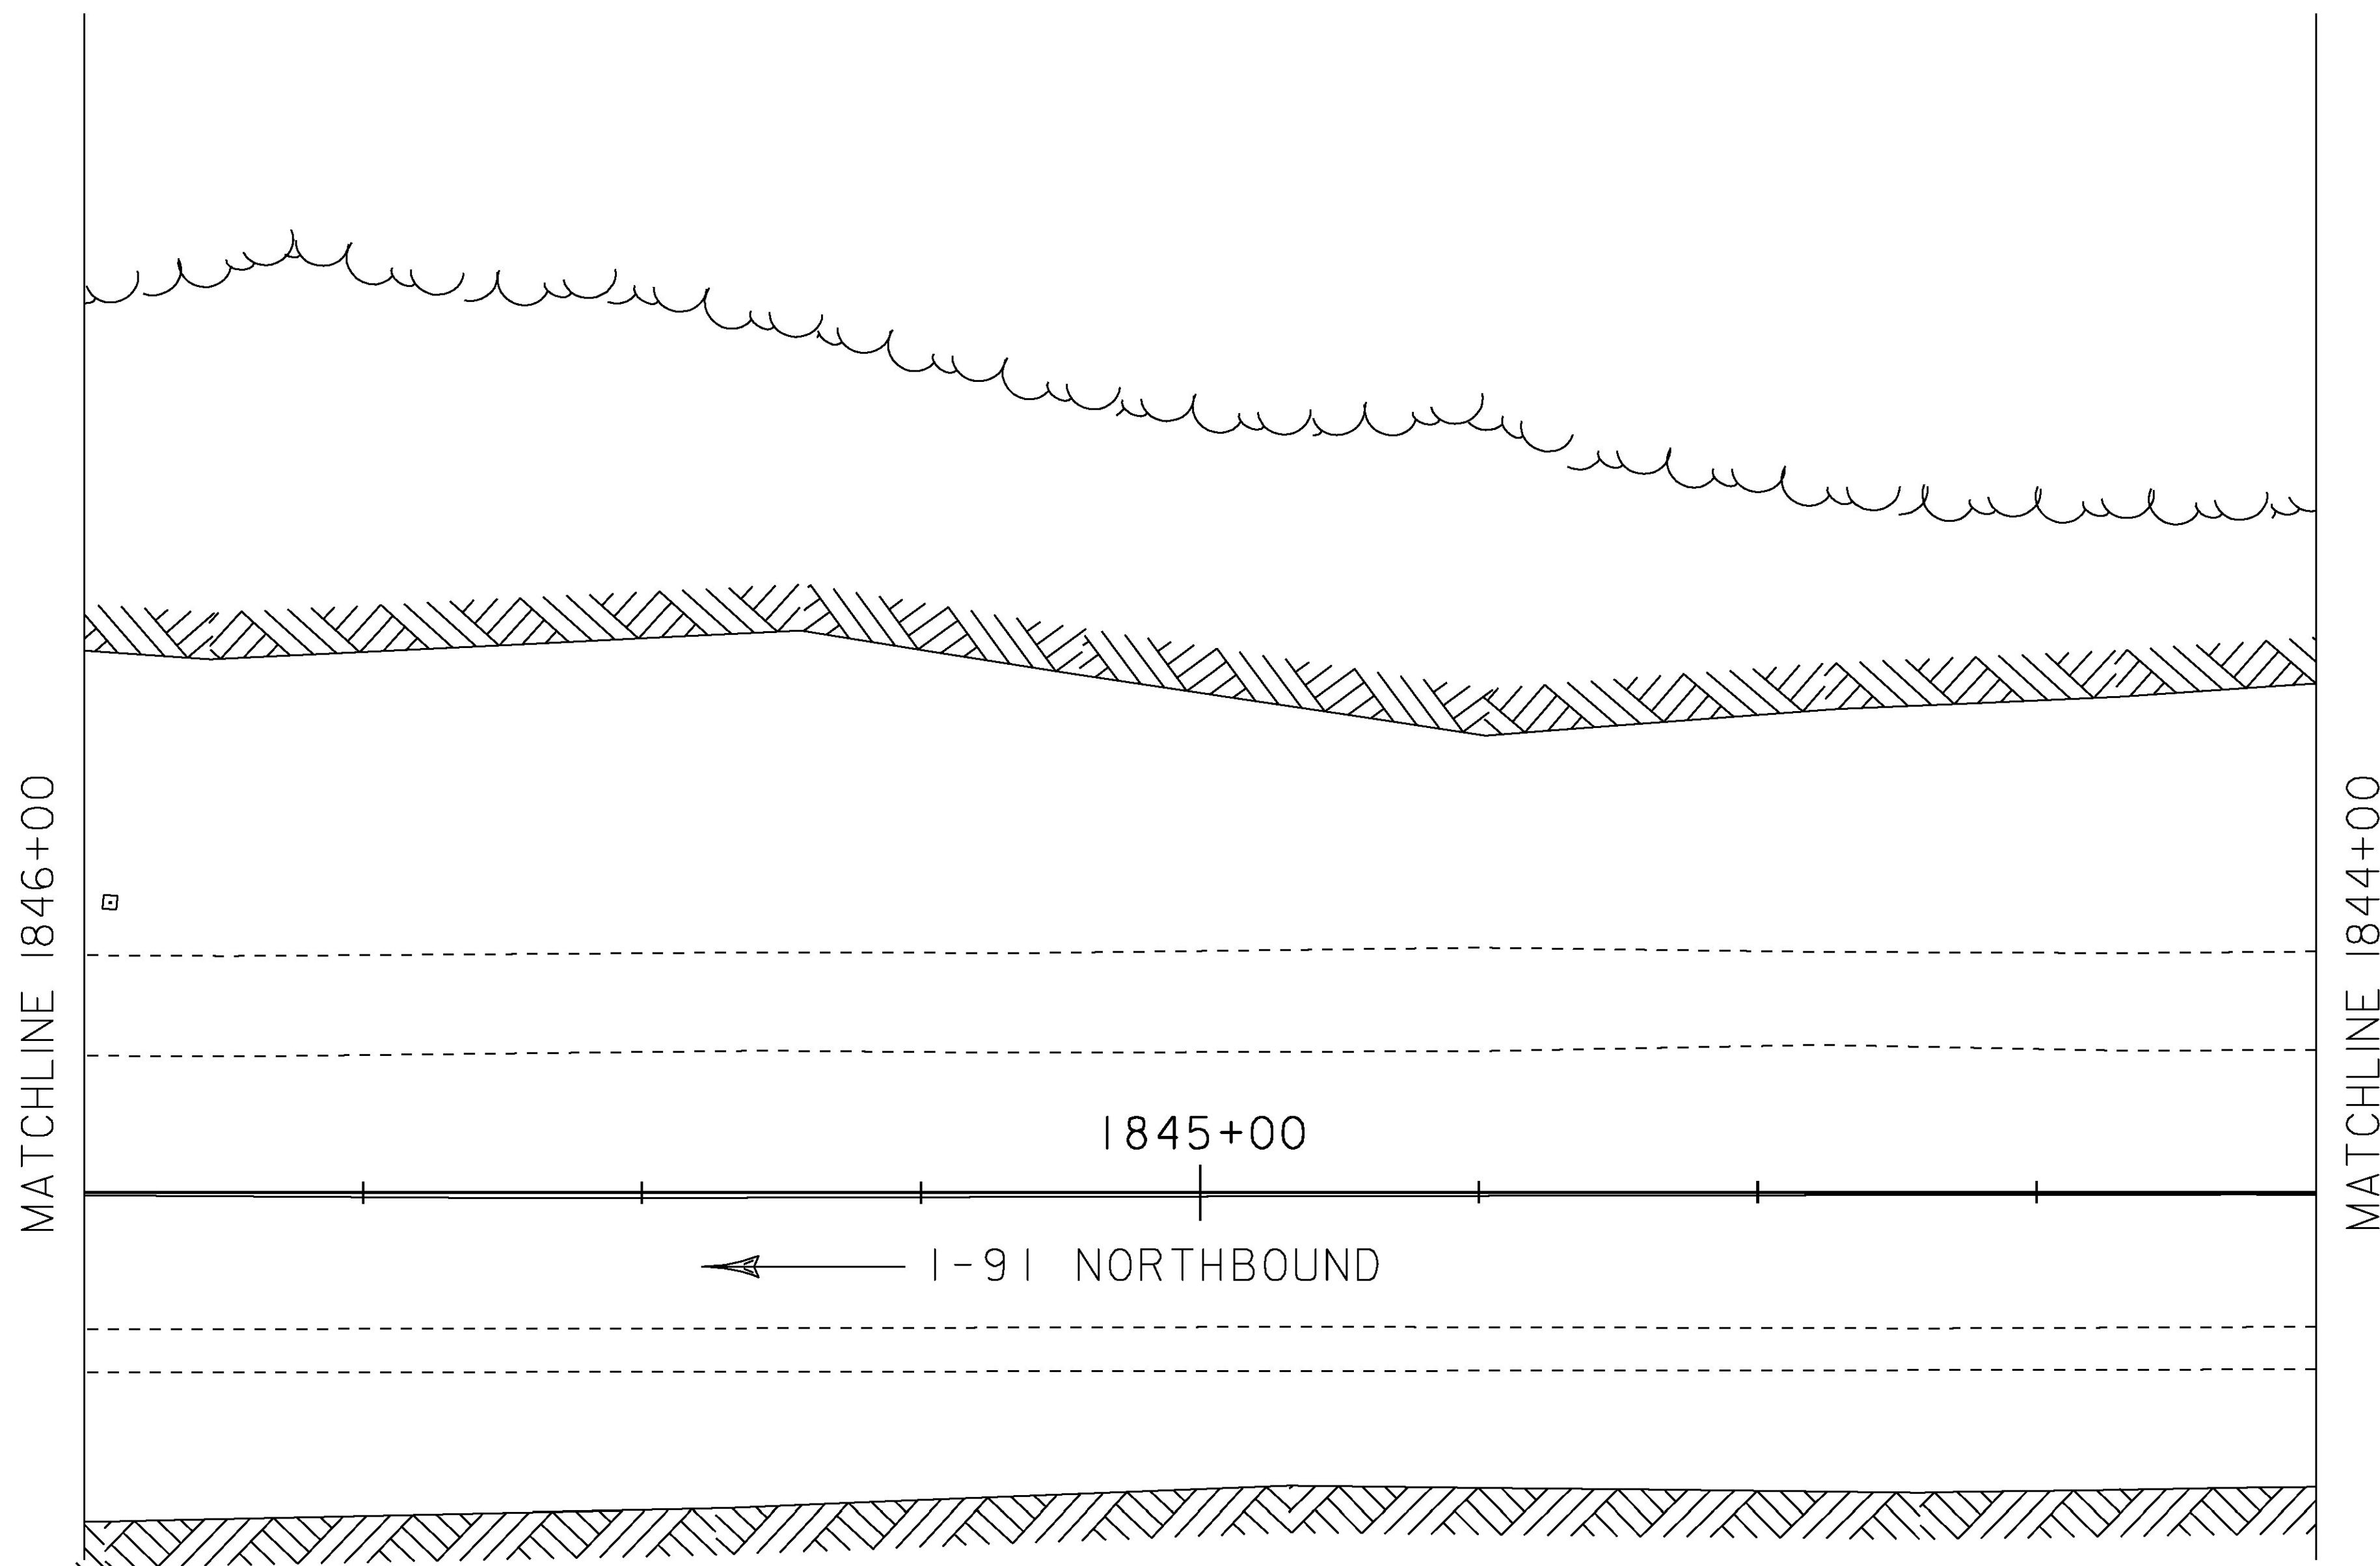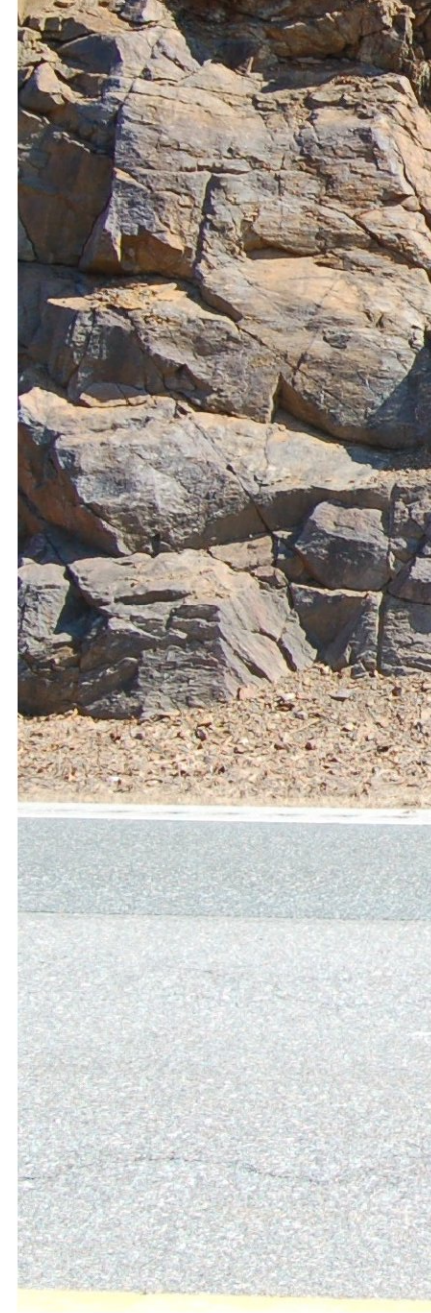

STAT
CENT
PROJ
PROJ
FILE
PROJ
DESIG
LAYO