






STA. 1850+00
MACHINE SCALING AT TOP ONLY



STA. 1849+50
MACHINE SCALING AT TOP ONLY



STA. 1849+00
MACHINE SCALING AT TOP ONLY

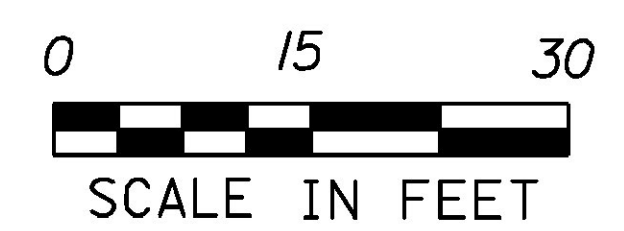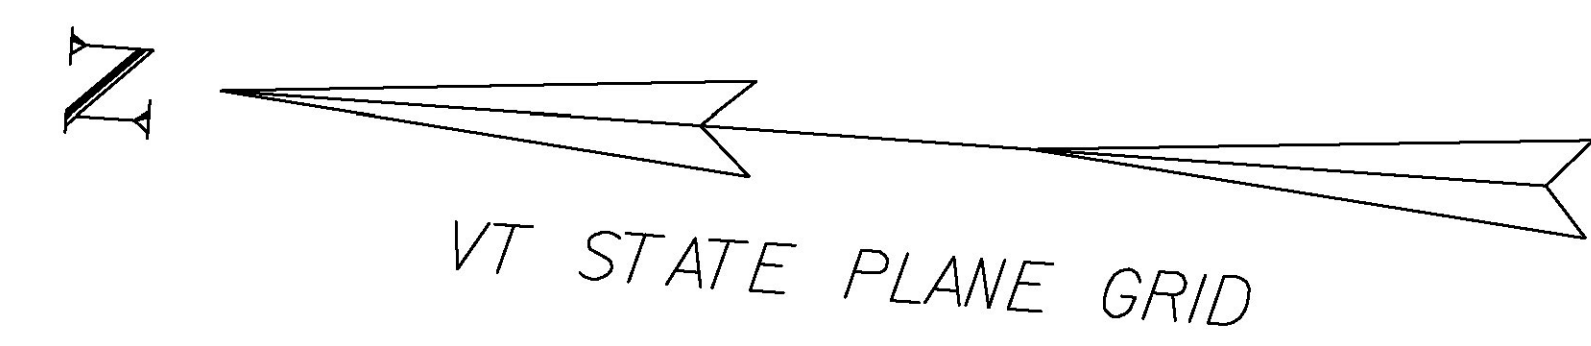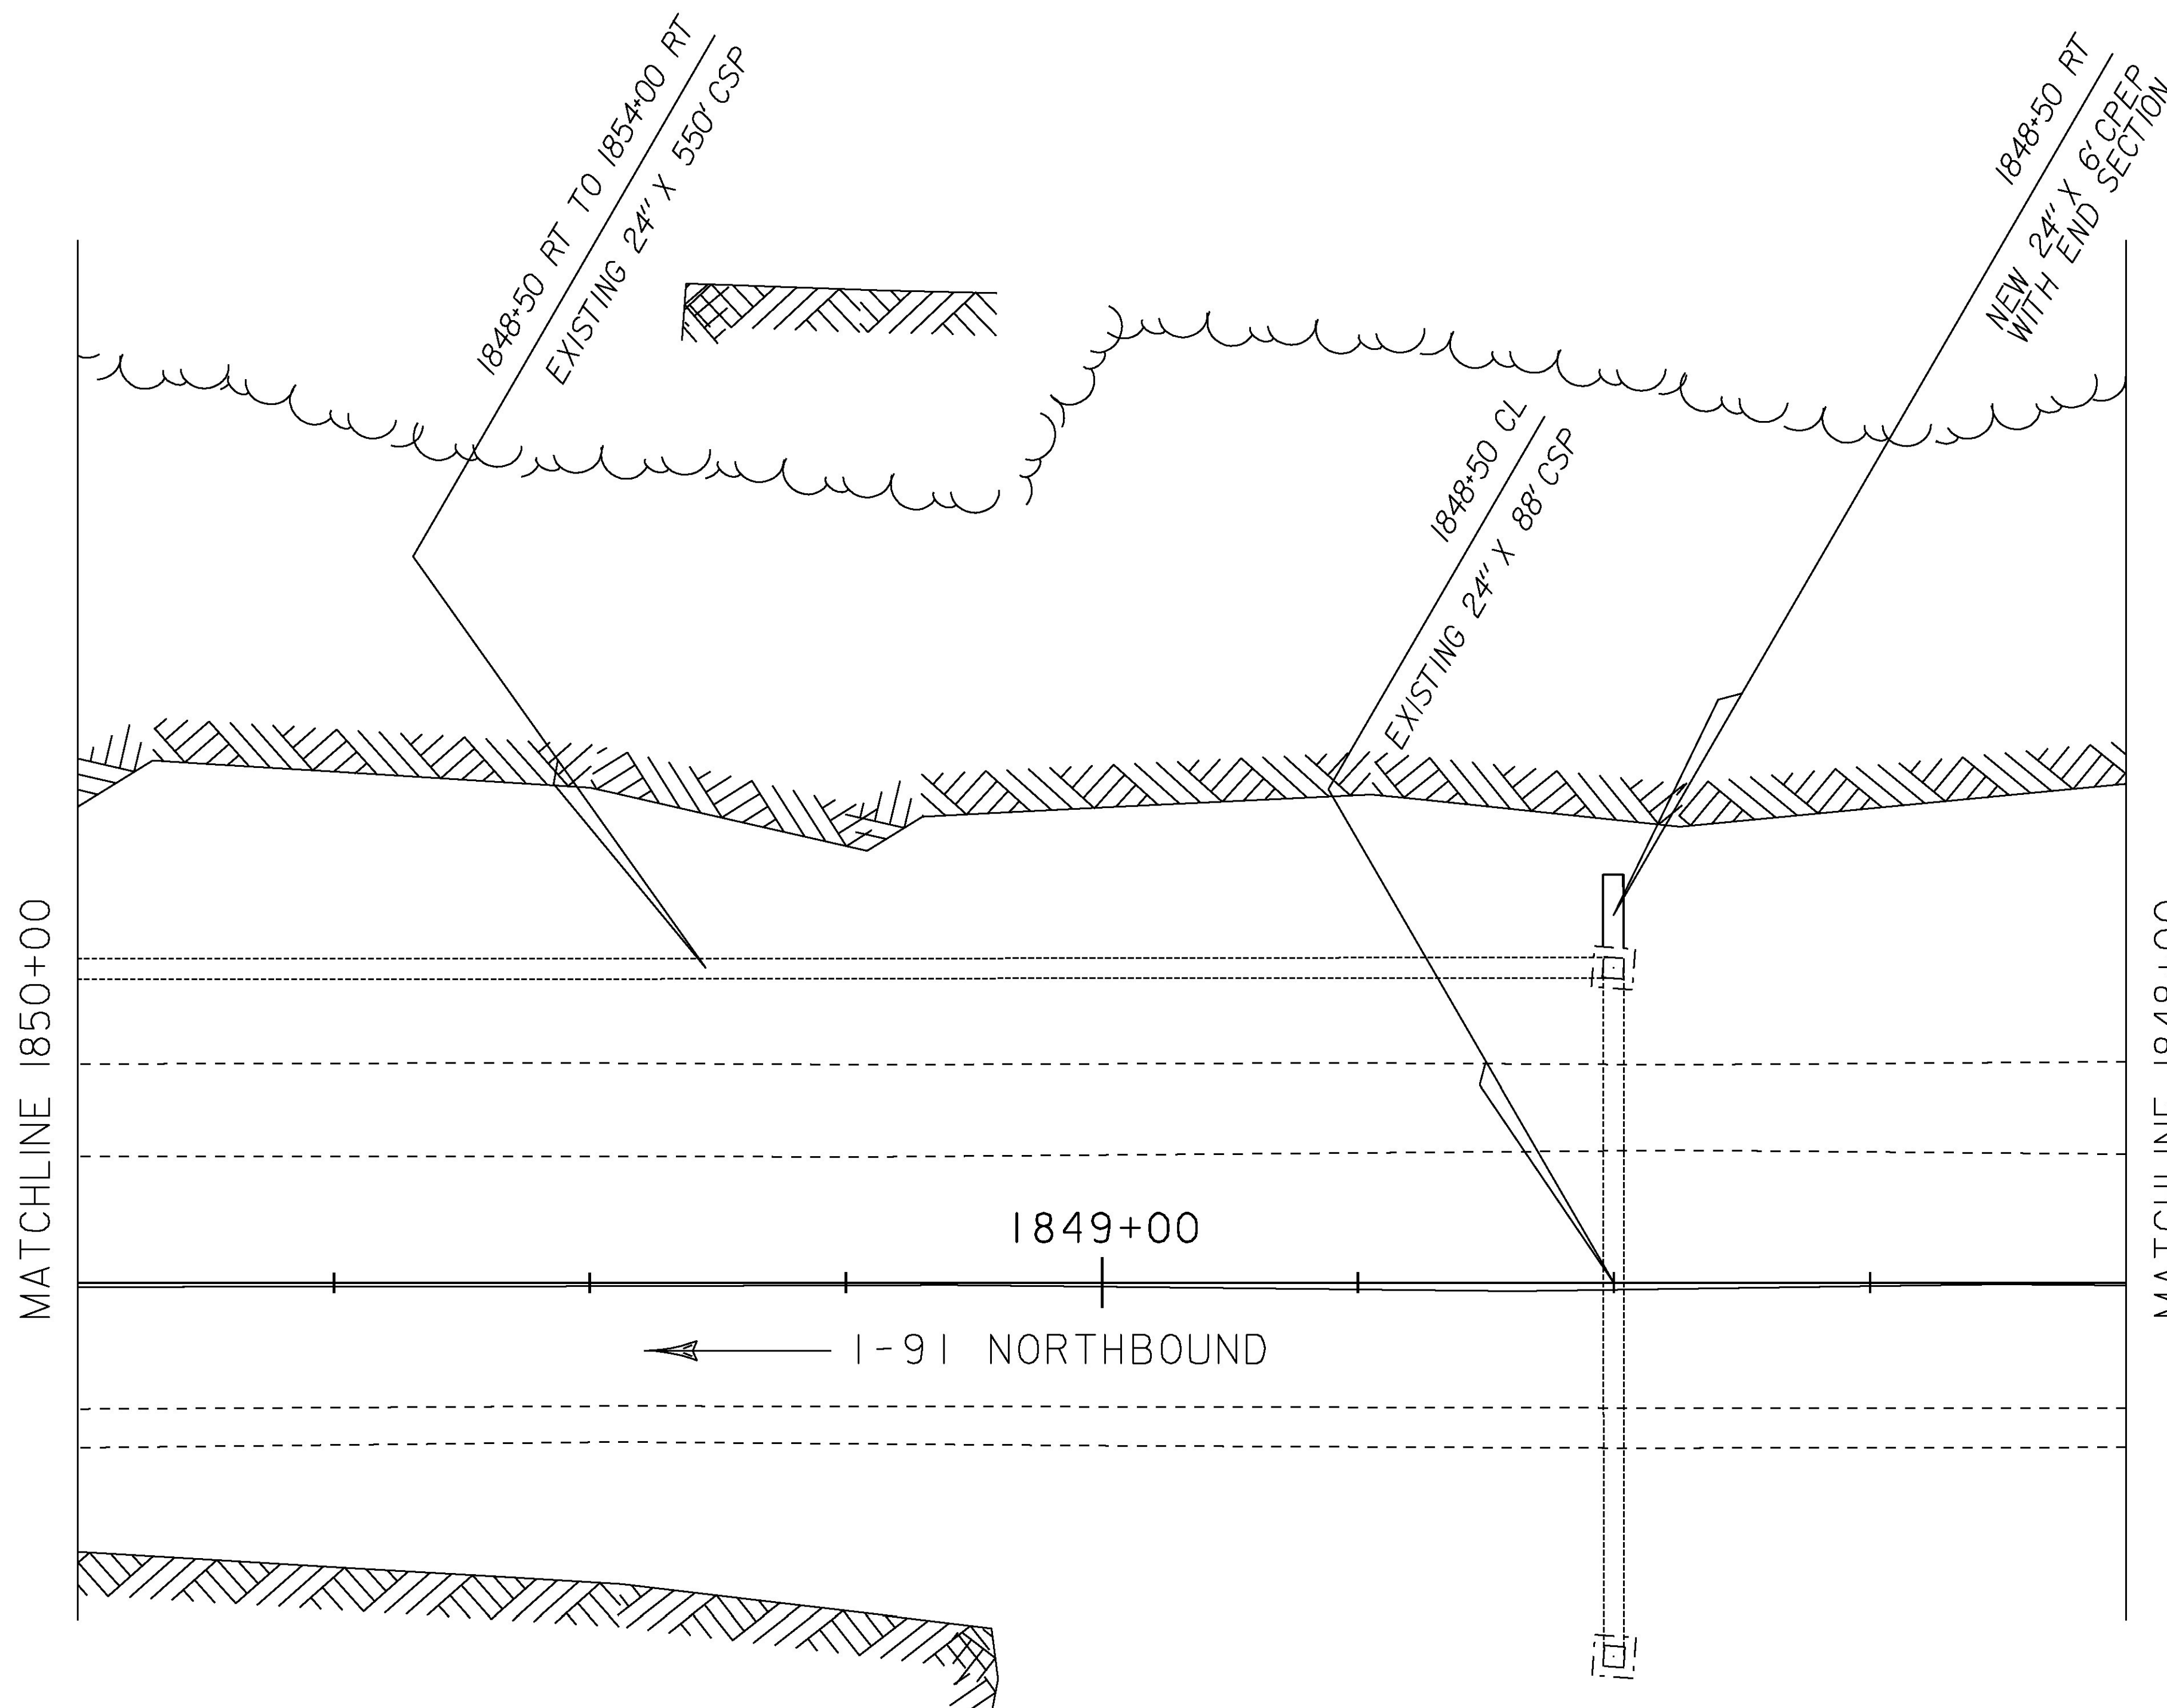

900.64
STA. 1848
STA. 1849-
STA. 1850+

STAT
CENT
PROJ
PROJ
DESIG
LAYO