



STA. 1852+00




STA. 1851+50
MACHINE SCALING AT TOP ONLY



STA. 1851+00
MACHINE SCALING AT TOP ONLY





M

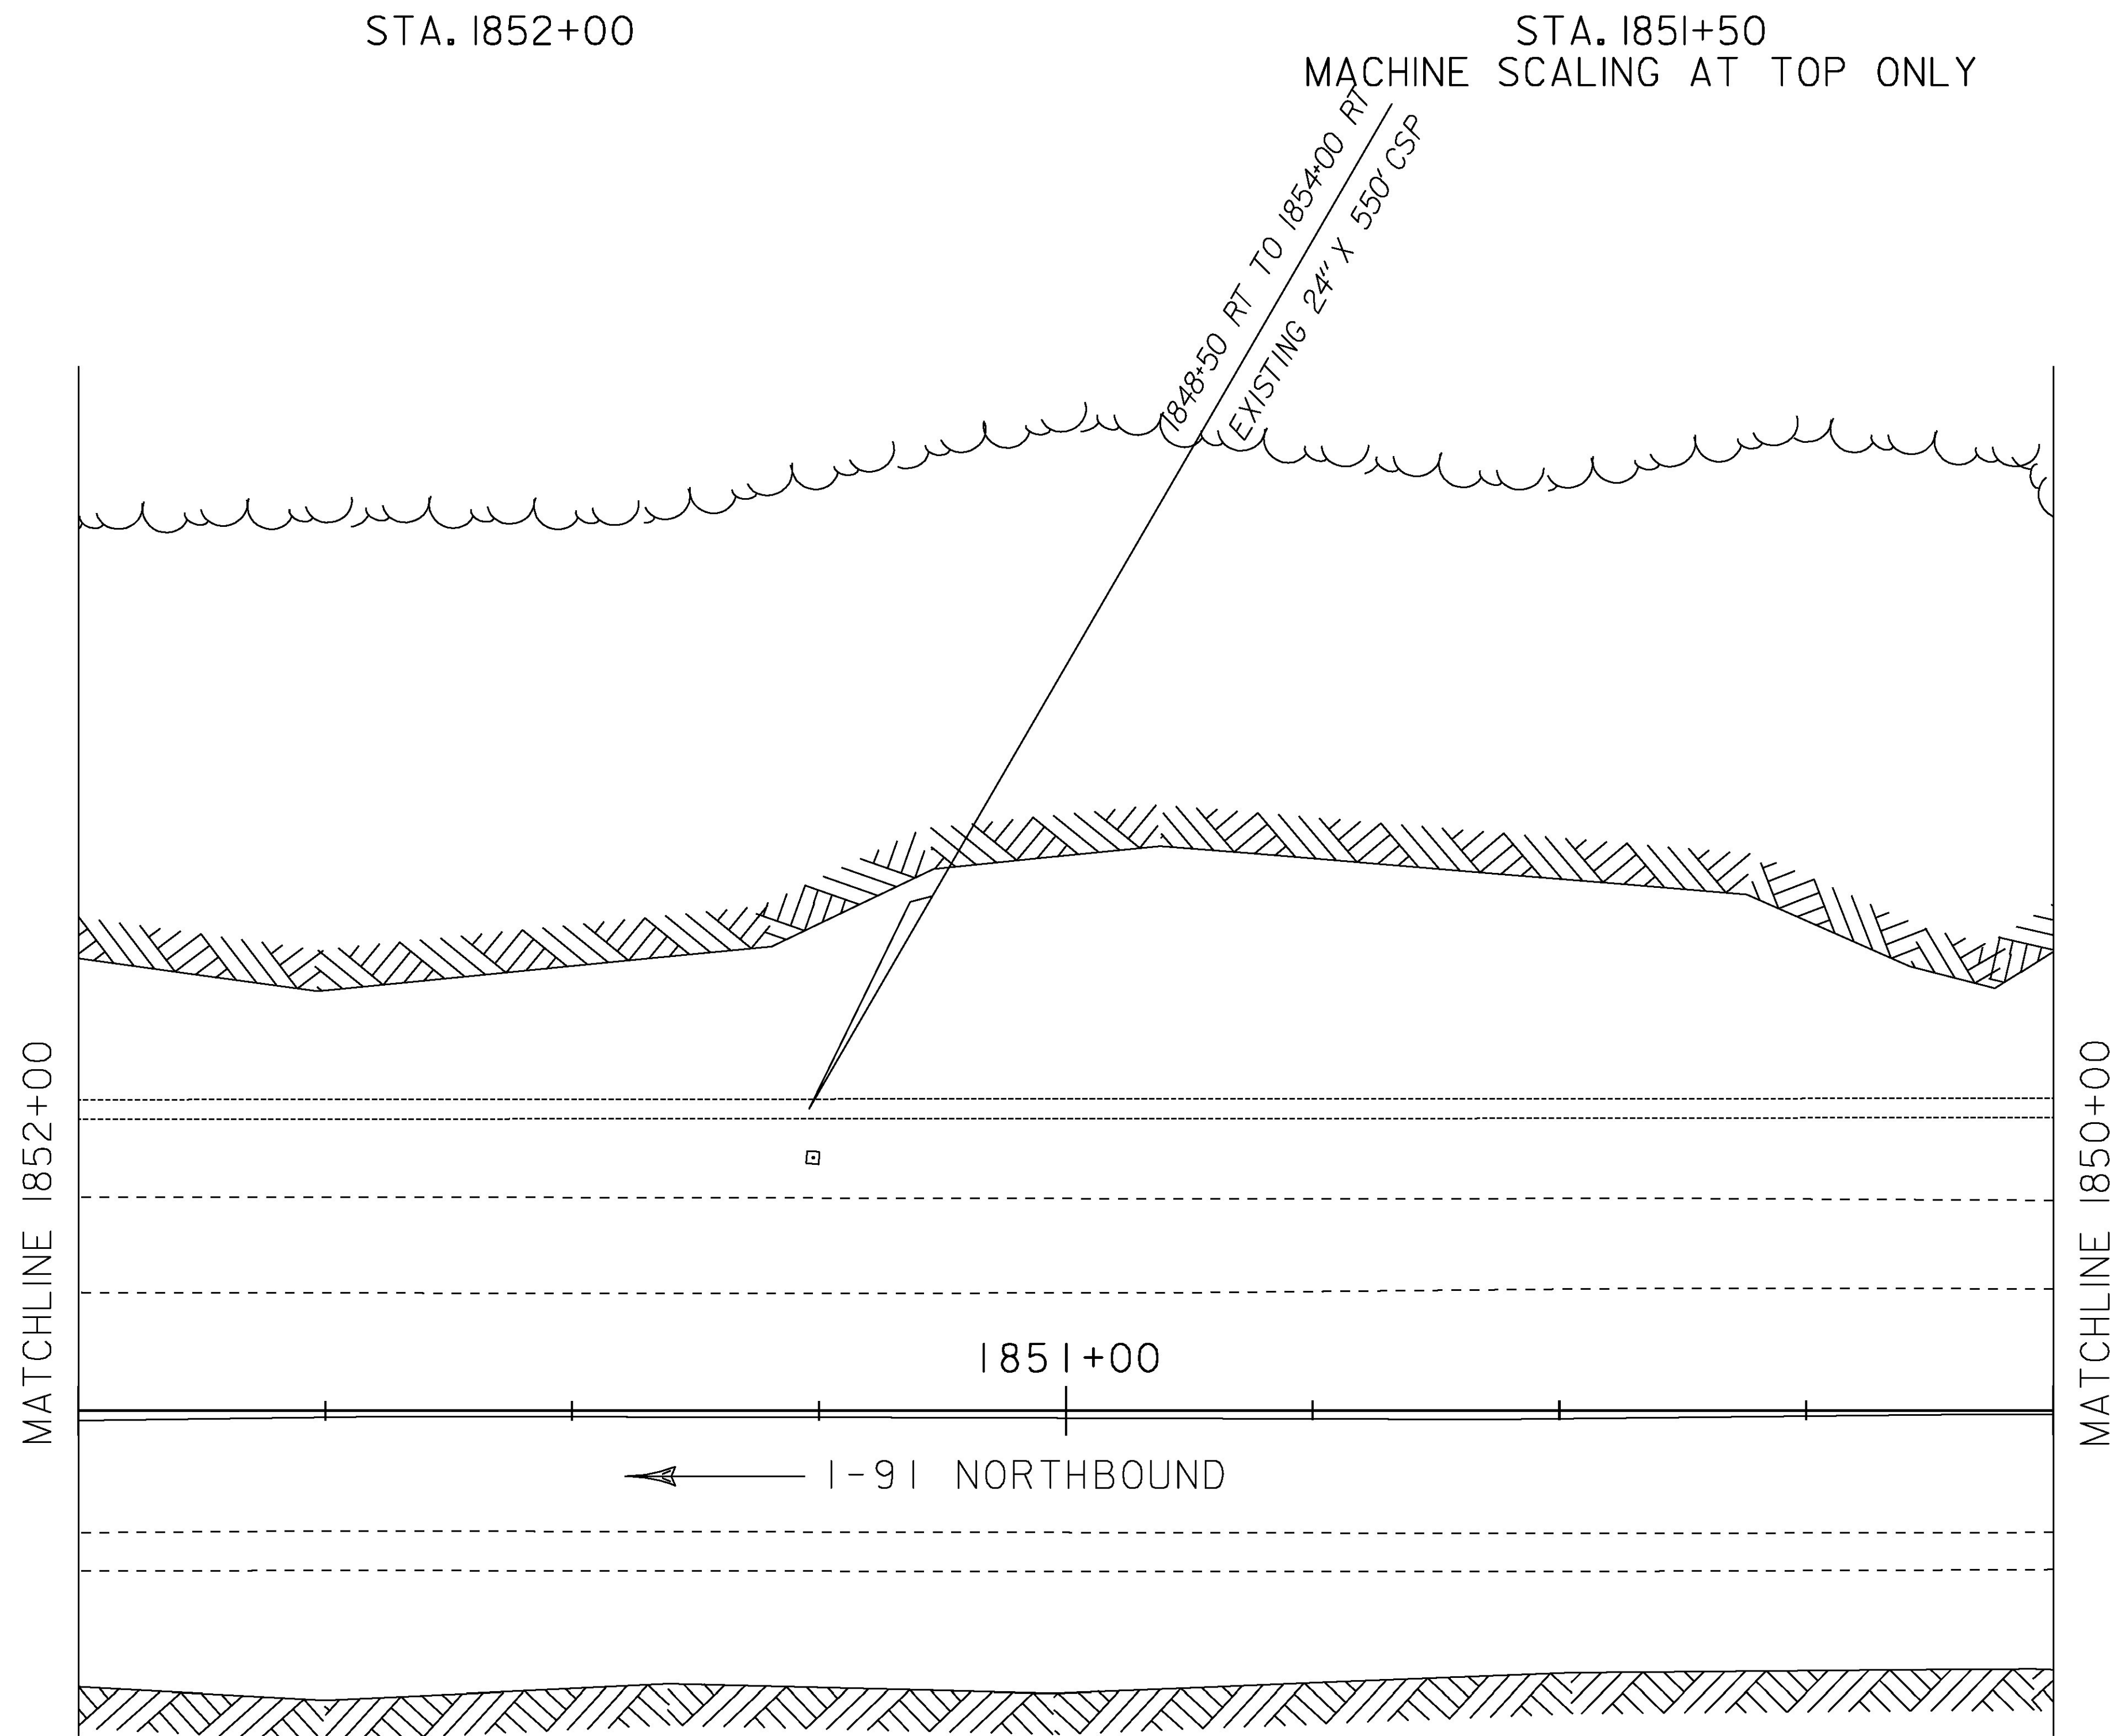

900.640 -
STA. 1850+50
STA. 1851+50
STA. 1852+00

900.640 - SPECI

900.608

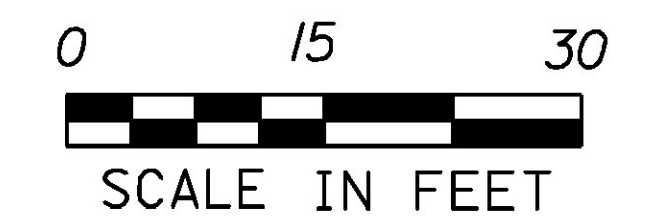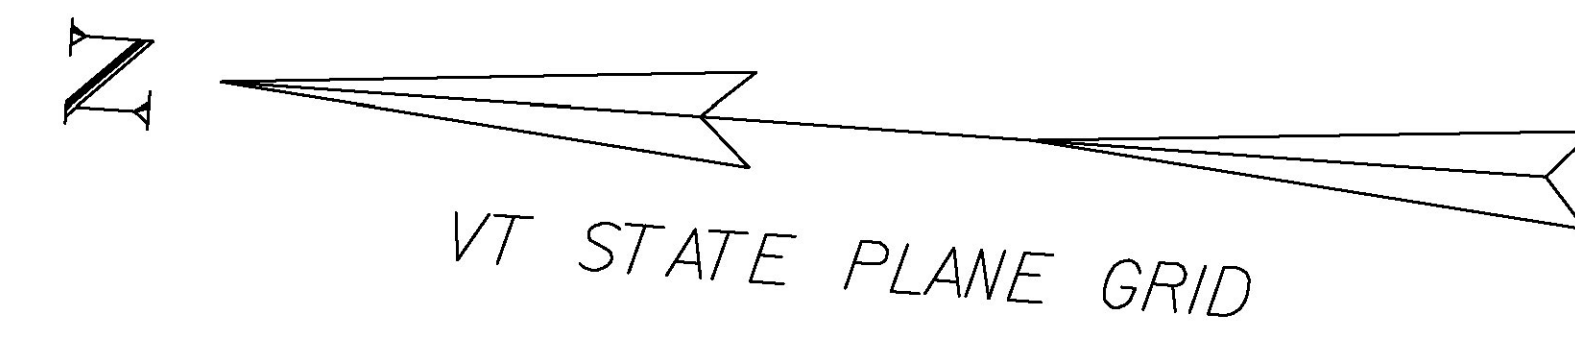

STAT
CENT
PROJ
PROJ
FILE
PROJ
DESIG
LAYO