




STA. 1854+00
MACHINE SCALING AT TOP ONLY





STA. 1853+50
MACHINE SCALING AT TOP ONLY



STA. 1853+00
MACHINE SCALING AT TOP ONLY

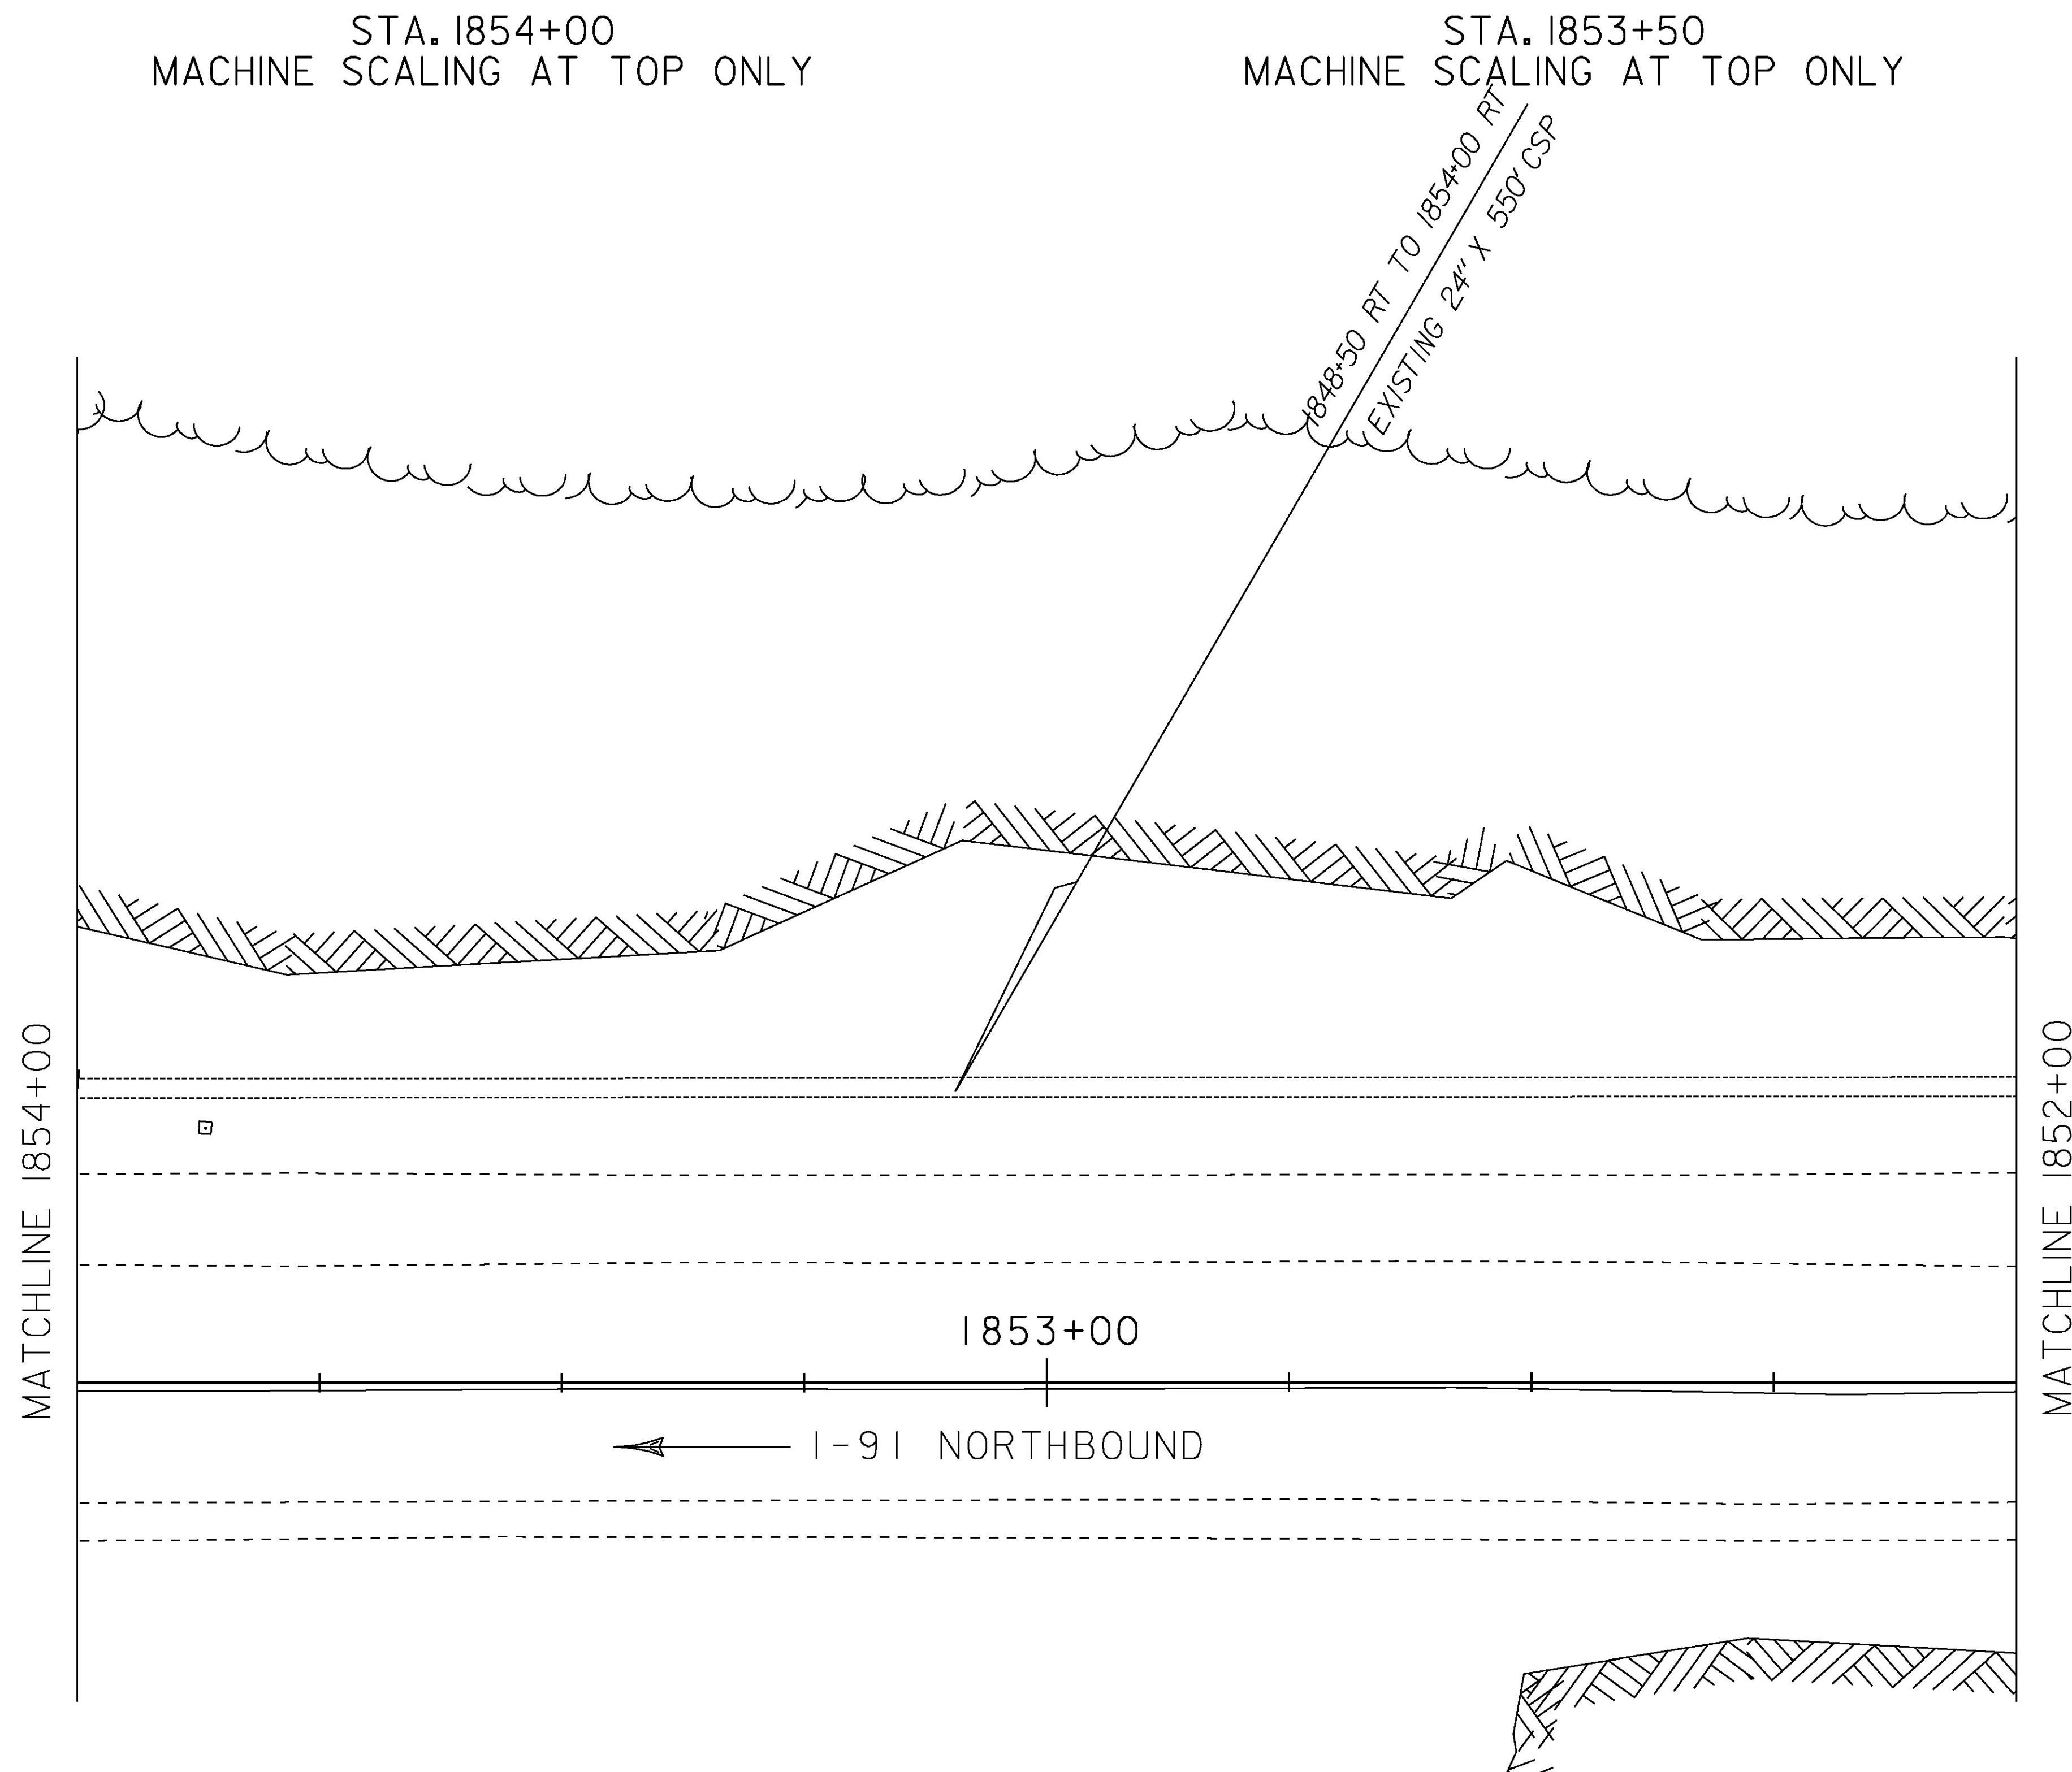

900.64
STA. 1852
STA. 1853
STA. 1853
STA. 1854

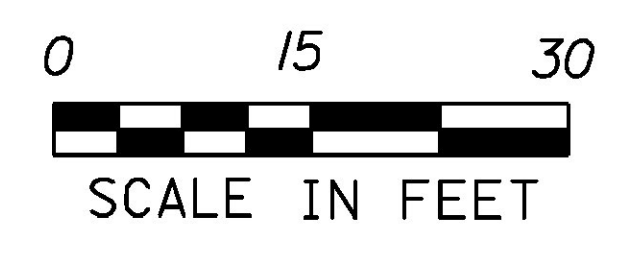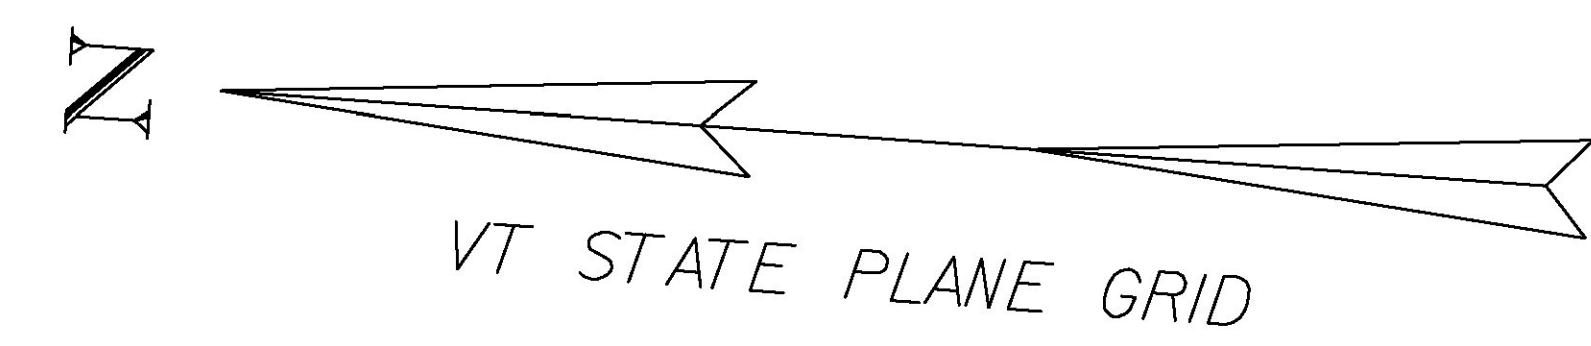

STAT
CENT
PROJ
PROJ
FILE
PROJ
DESIG
LAYO