






STA. 1856+00
MACHINE SCALING AT TOP ONLY



STA. 1855+50
MACHINE SCALING AT TOP ONLY



STA. 1855+00
MACHINE SCALING AT TOP ONLY

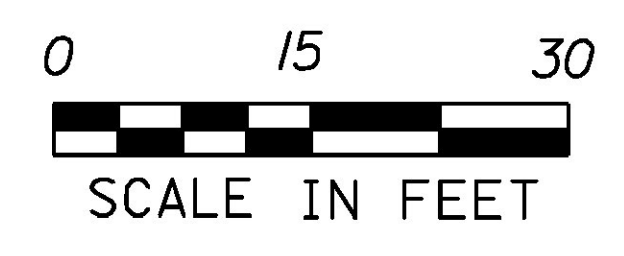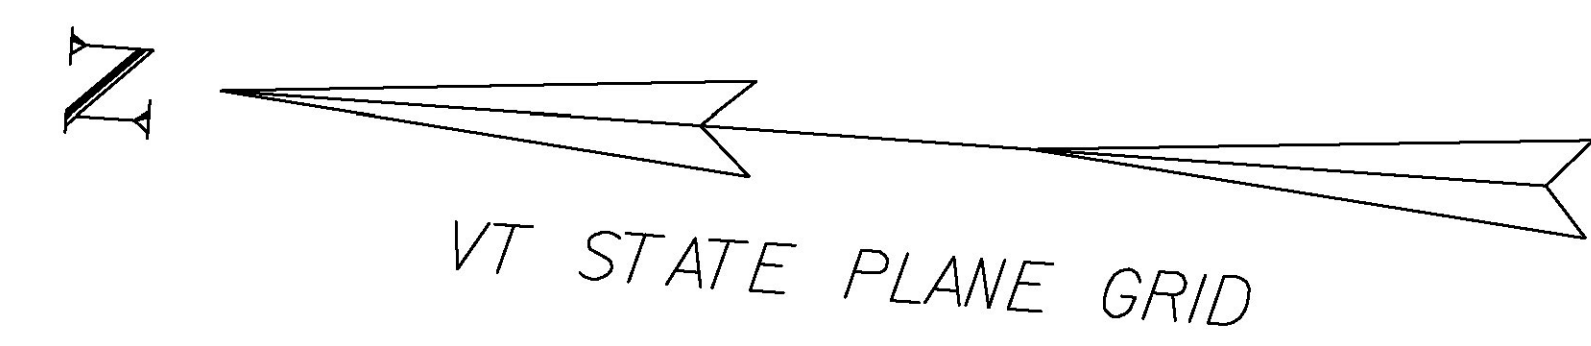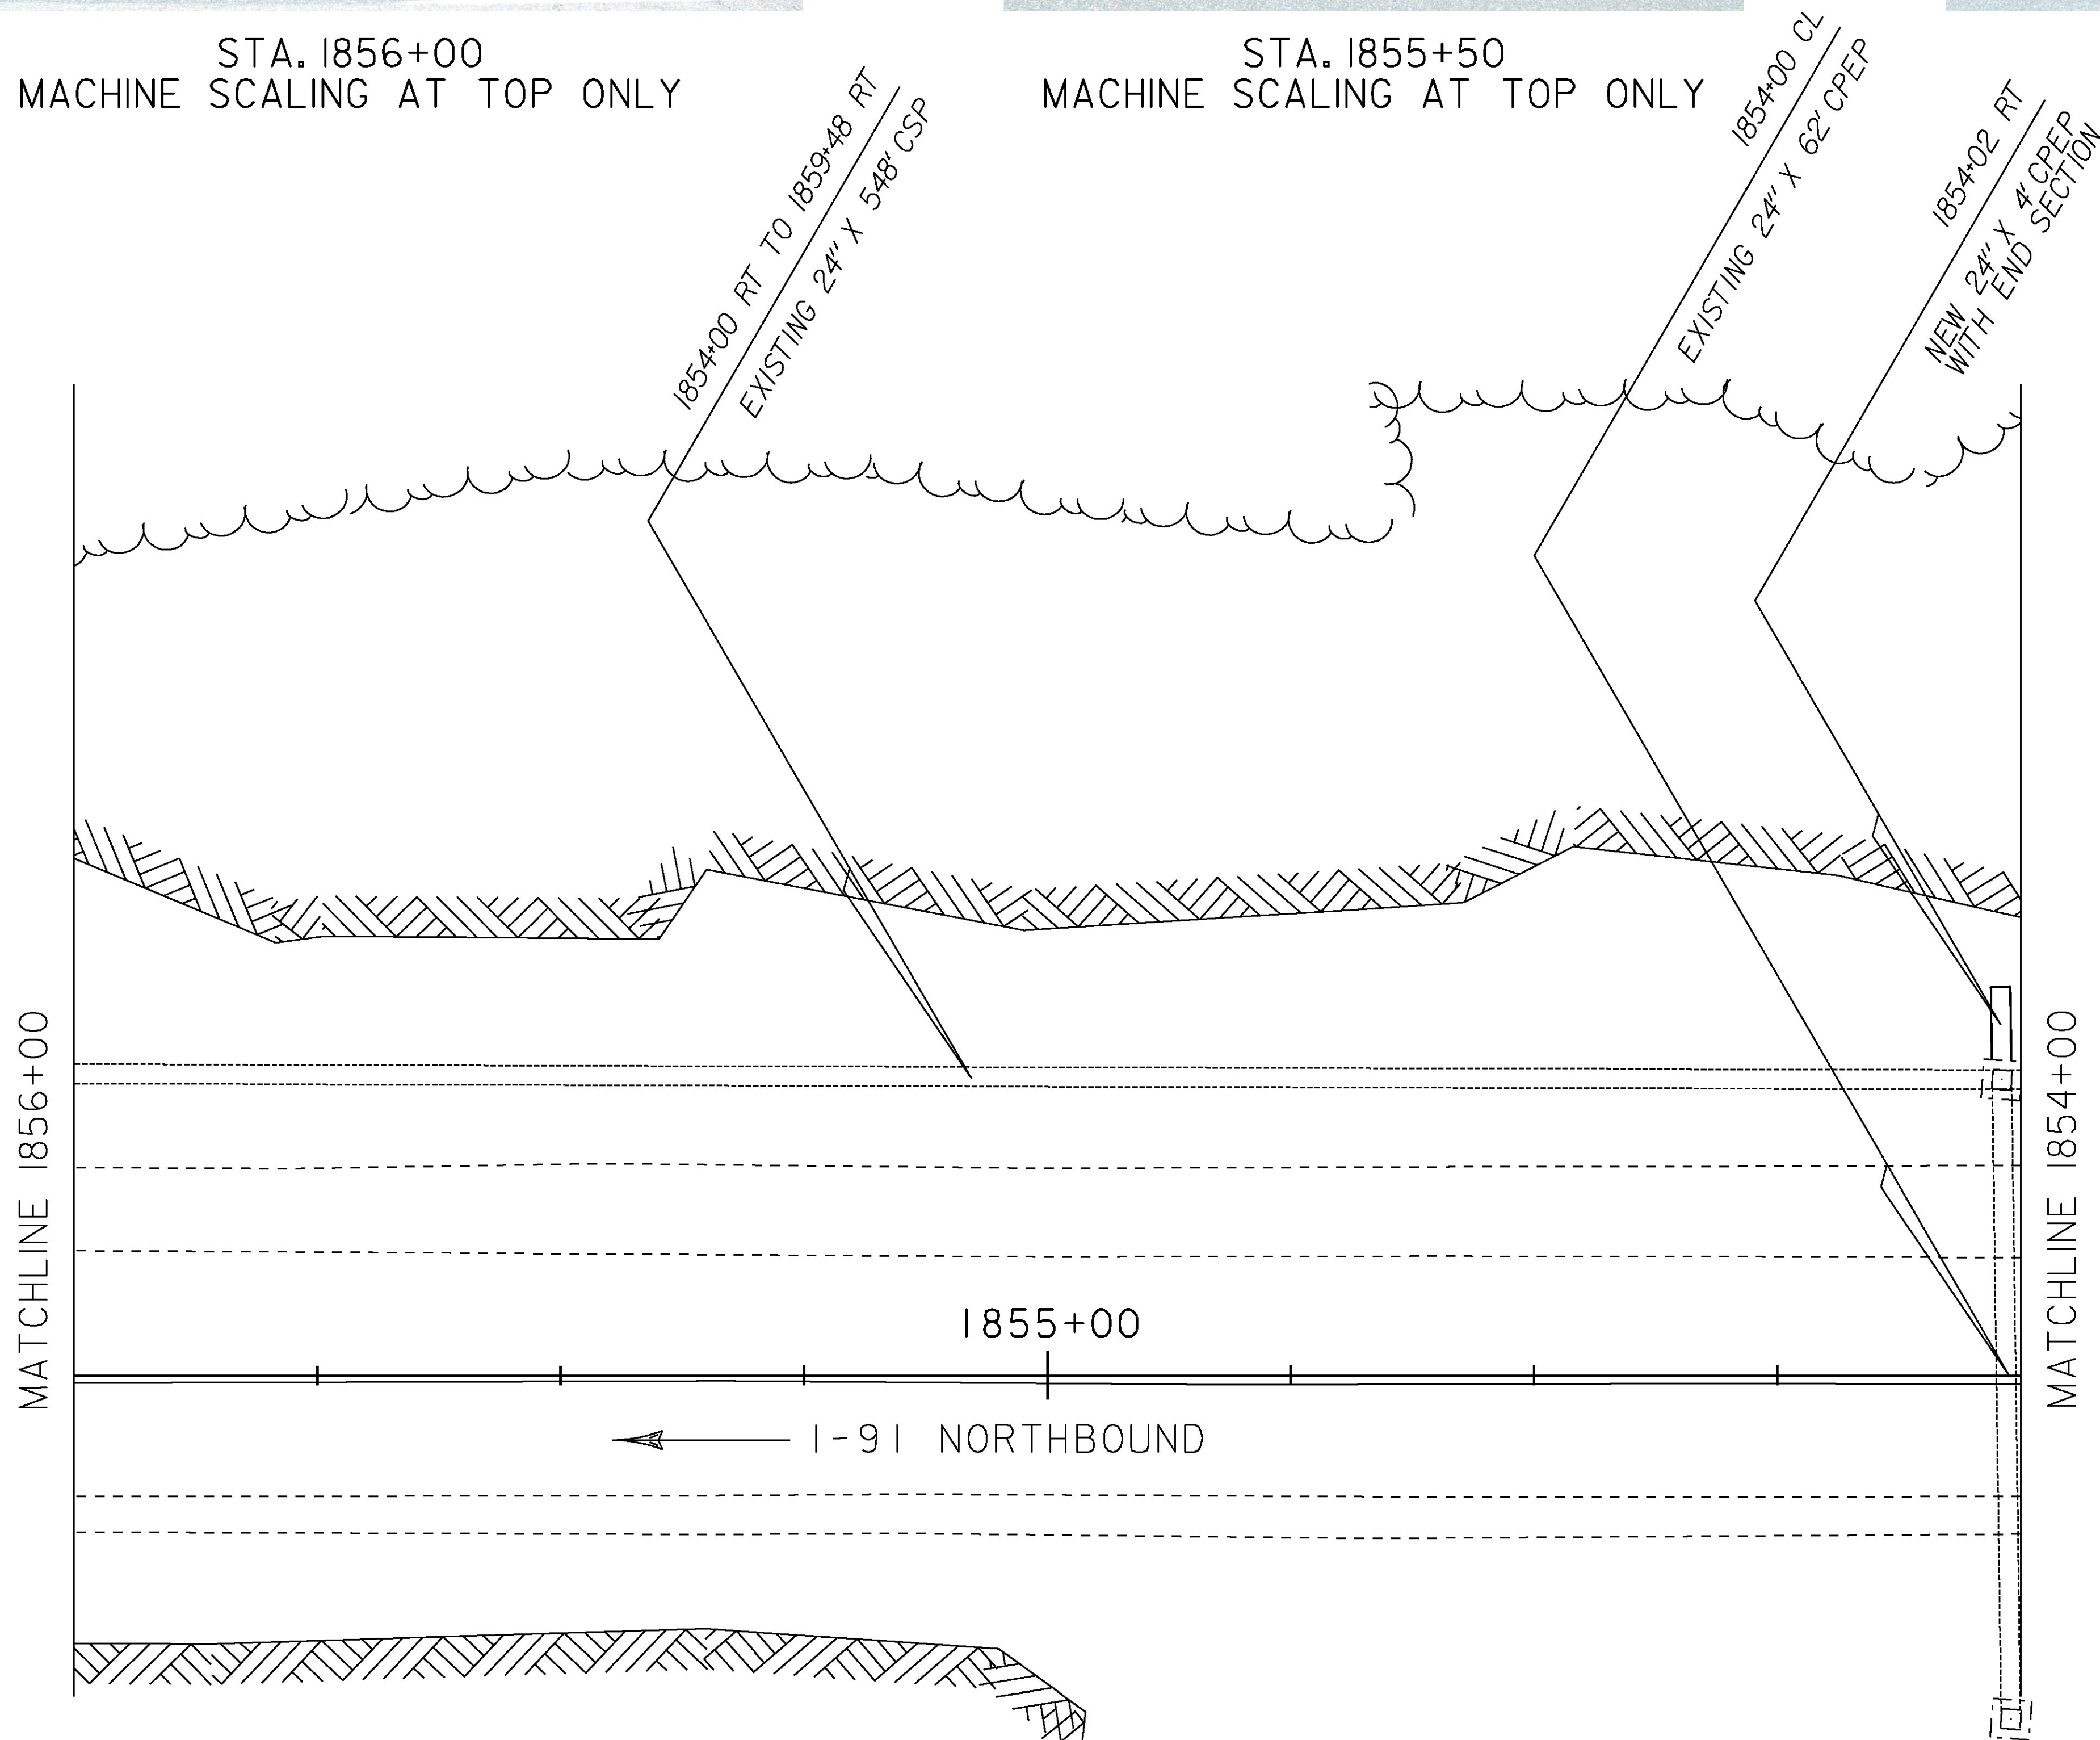

900.640
STA. 1854
STA. 1855
STA. 1855-
STA. 1856-

STAT
CENT
PROJ
PROJ
FILE
PROJ
DESIG
LAYO