



STA. 1858+00  
MACHINE SCALING AT TOP ONLY



STA. 1857+50  
MACHINE SCALING AT TOP ONLY






STA. 1857+00  
MACHINE SCALING AT TOP ONLY



MA...

900.64  
STA. 1856

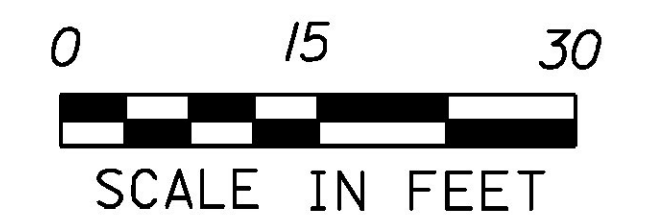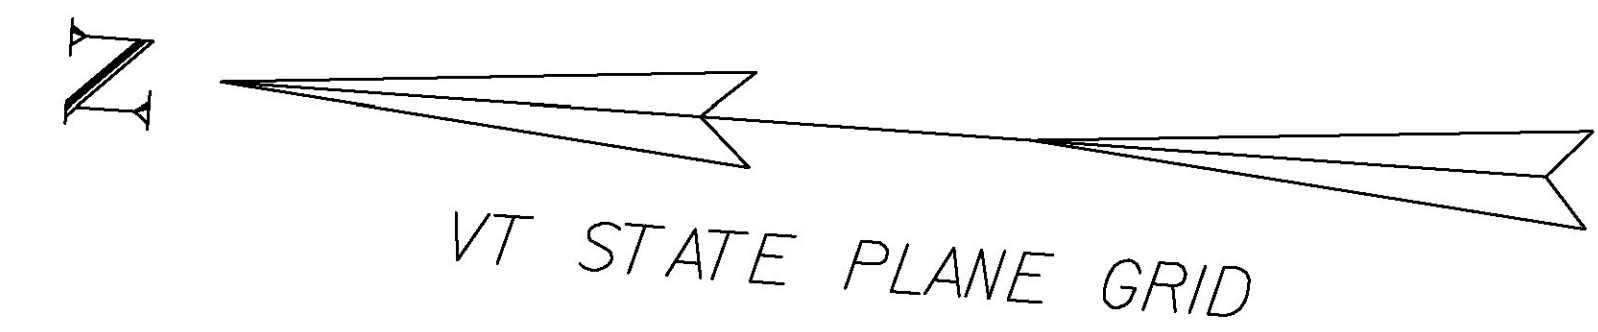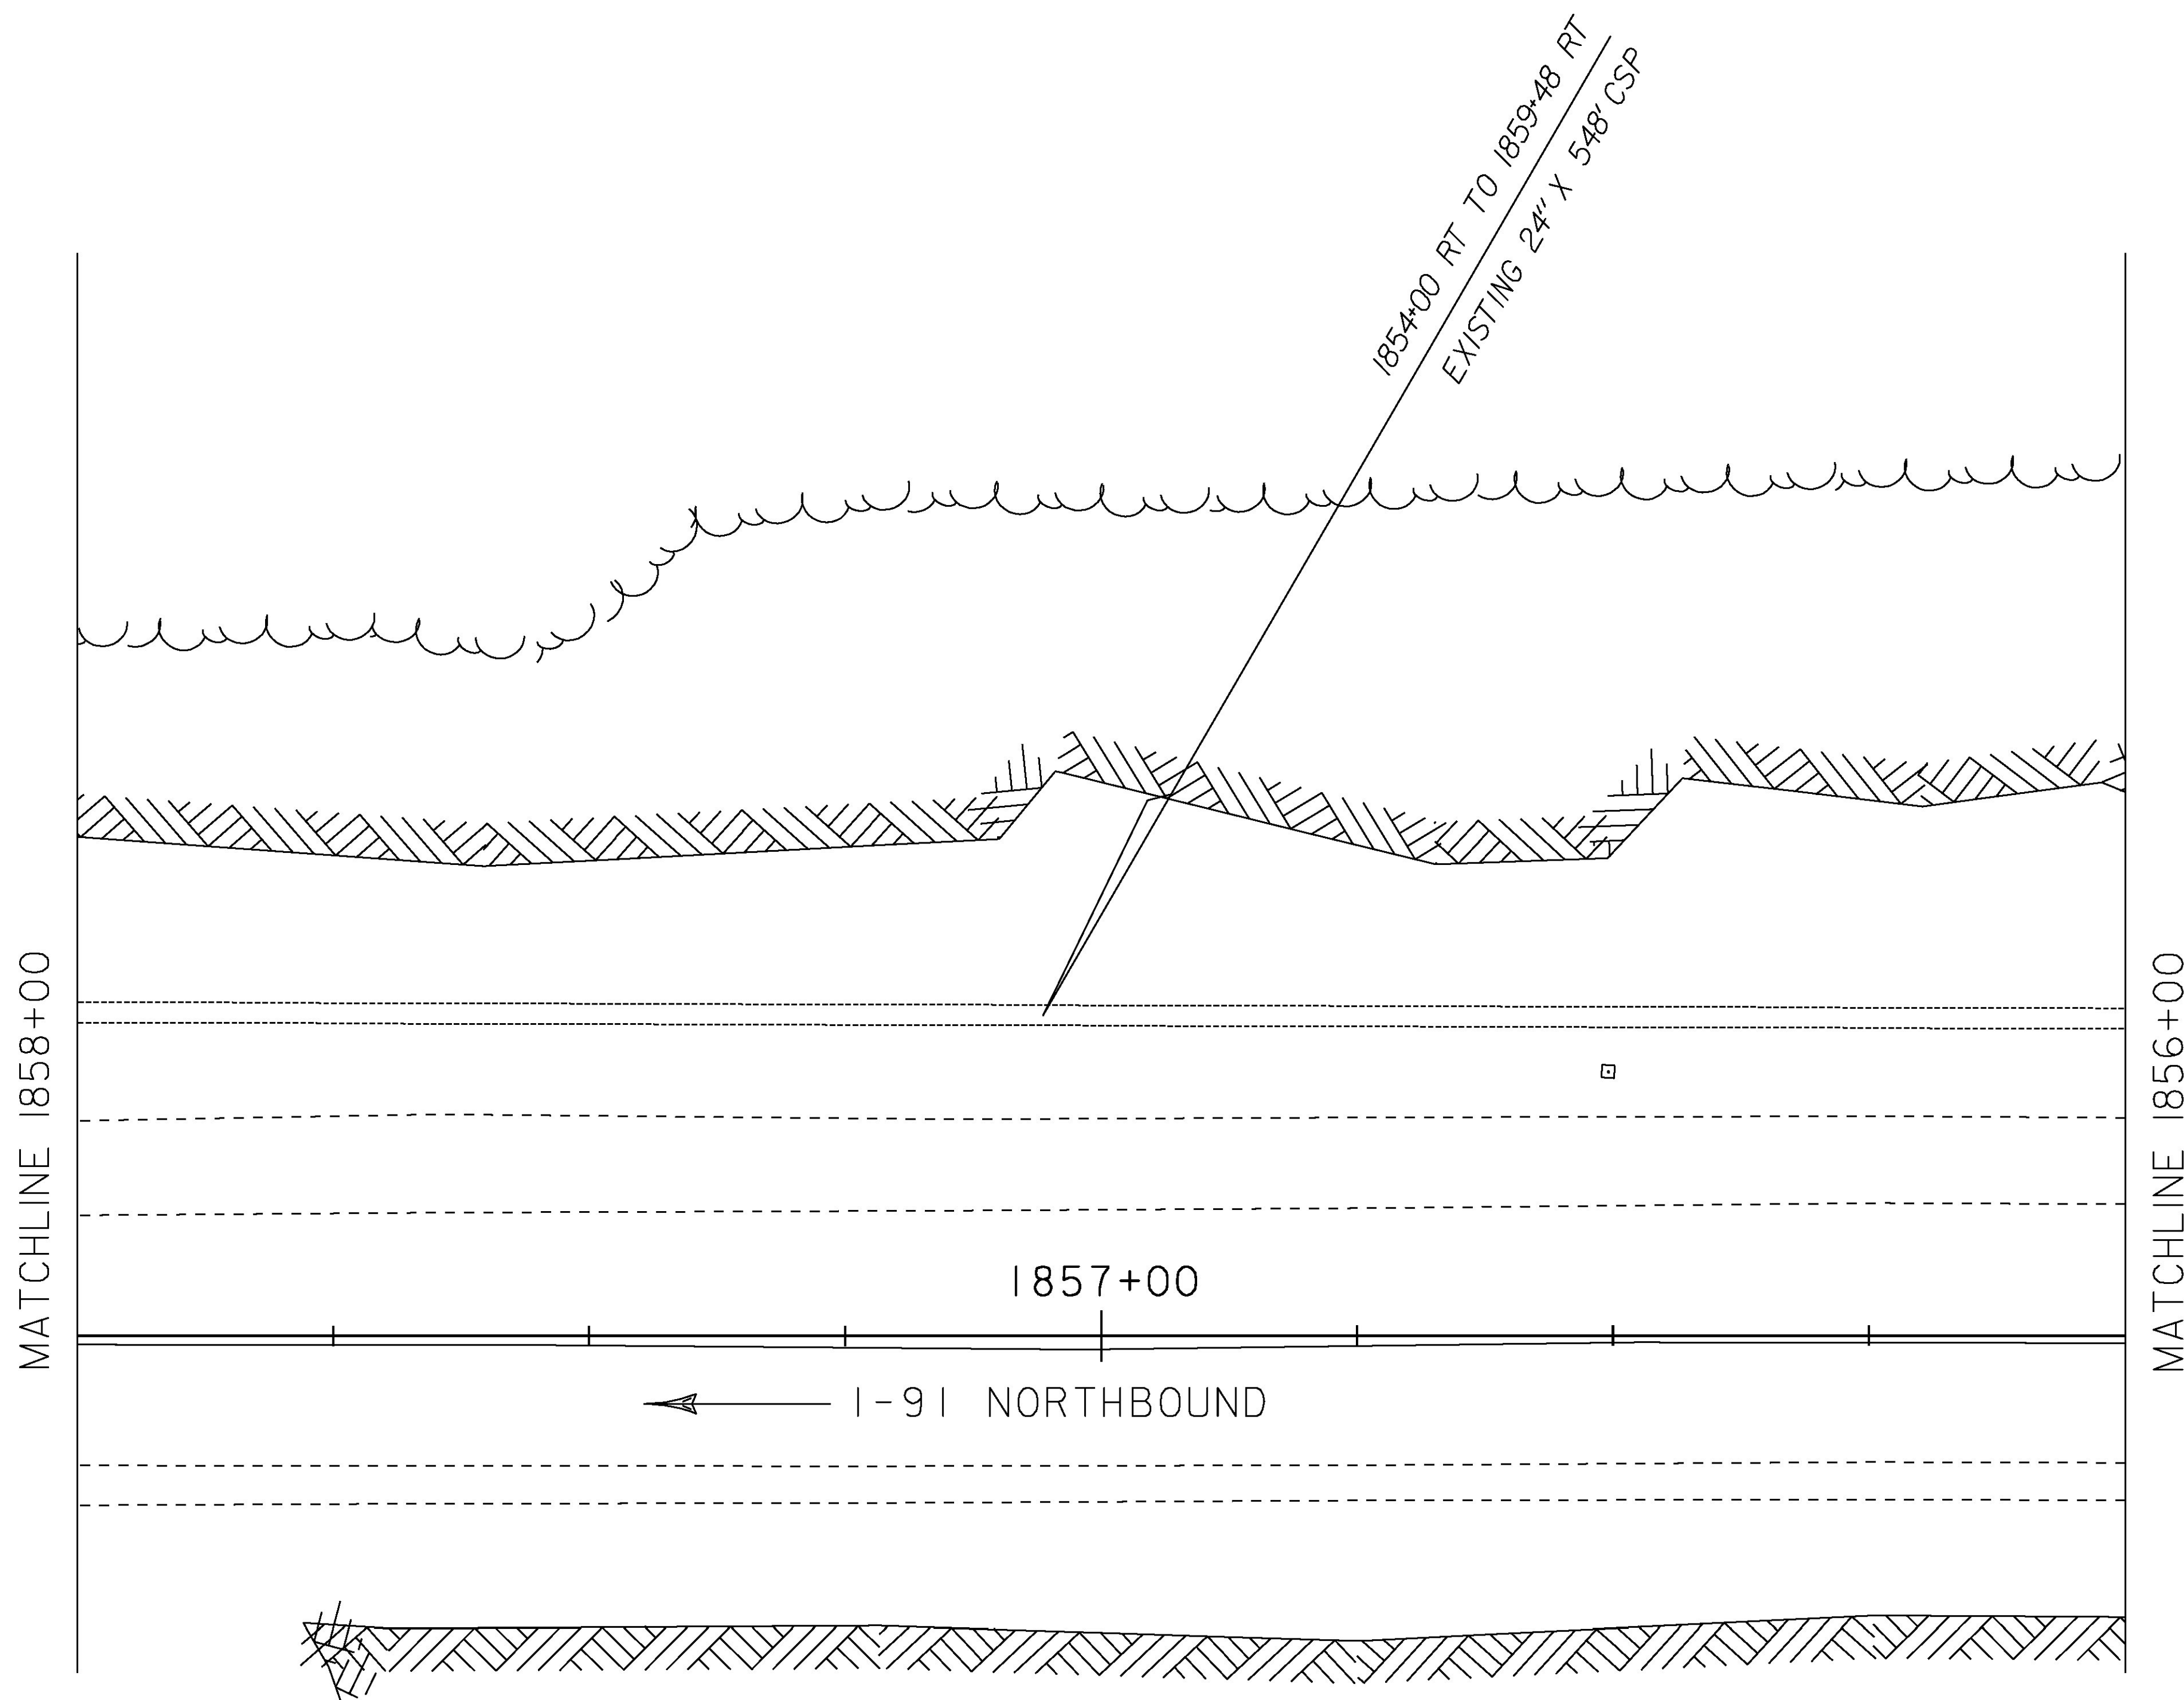

STAT  
CENT  
PROJ  
PROJ  
FILE  
PROJ  
DESIG  
LAYO