



1841+50 ✓

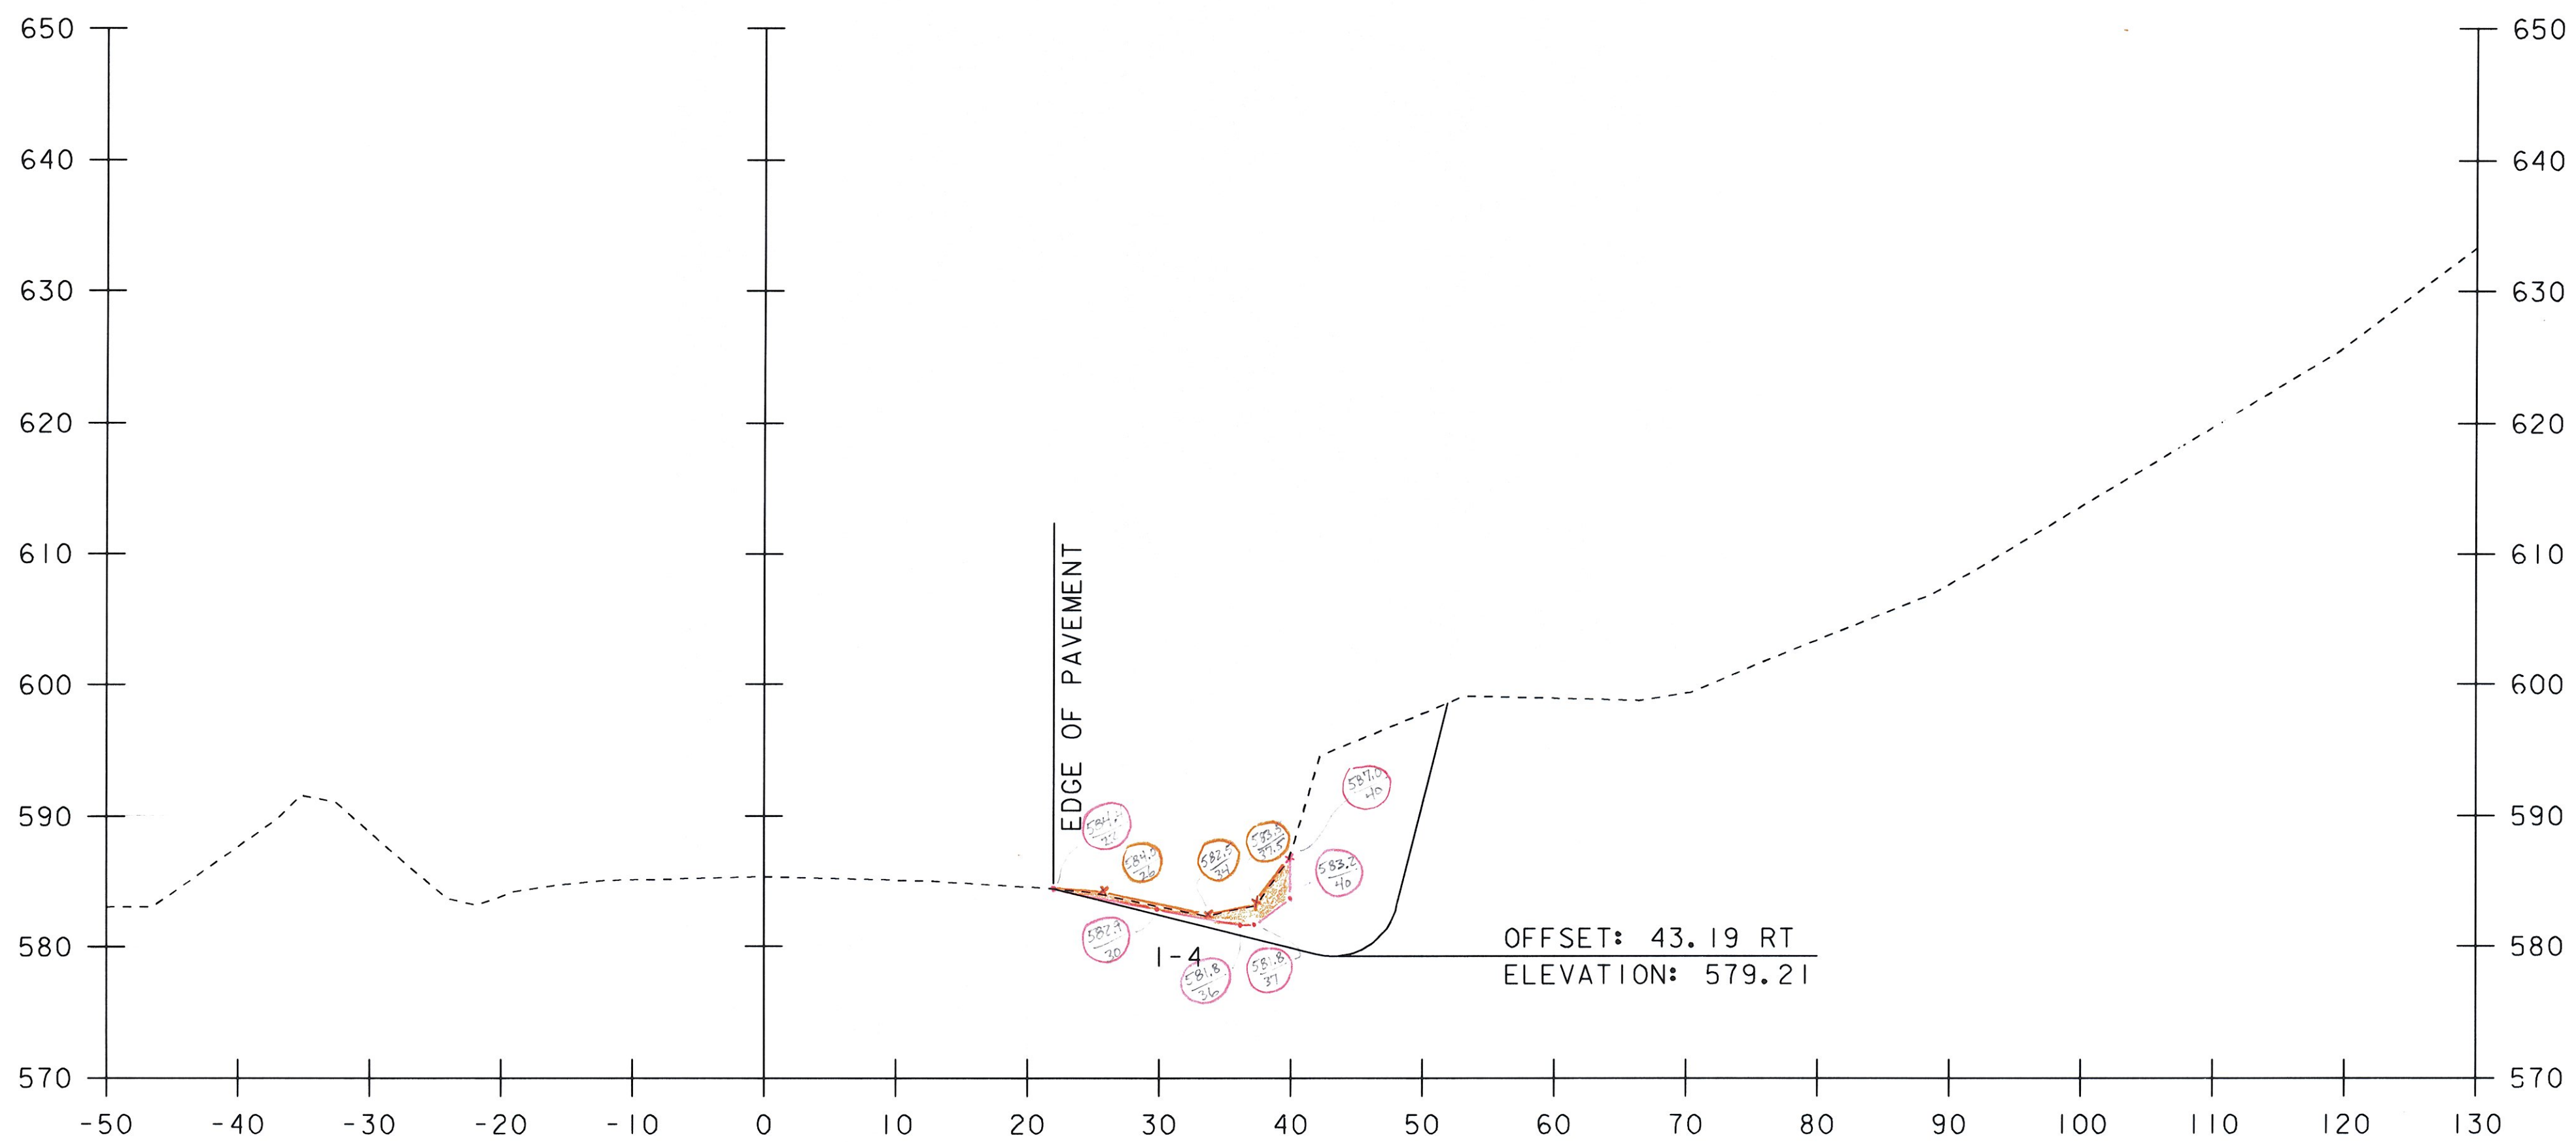

1841+00 ✓

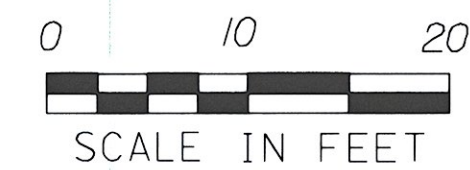

STA. 1841+00 TO STA. 1841+50

pu RCD
2-8-11 3/16/11

PROJECT NAME: ROCKINGHAM	PLOT DATE: 26-MAY-2010
PROJECT NUMBER: IM 091-1(57)	DRAWN BY: P. PELOQUIN
FILE NAME: 07a158/Design/d07a158xs.dgn	CHECKED BY: S. MENARD
PROJECT LEADER: K. ROBBE	SHEET 30 OF 78
DESIGNED BY: P. PELOQUIN	
CROSS SECTION SHEET 4	