


1845+00 ✓

OFFSET: 43.19 RT
ELEVATION: 580.50

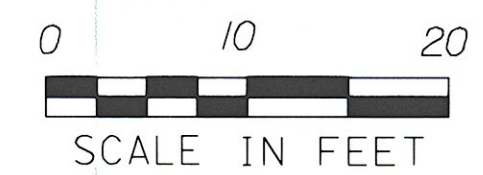

STA. 1845+00 TO STA. 1845+00

AP
2-B-11
ROD
3/16/11

PROJECT NAME: ROCKINGHAM	
PROJECT NUMBER: IM 091-(57)	
FILE NAME: 07a158/Design/d07a159xs.dgn	PLOT DATE: 26-MAY-2010
PROJECT LEADER: K. ROBIE	DRAWN BY: P. PELOQUIN
DESIGNED BY: P. PELOQUIN	CHECKED BY: S. MENARD
CROSS SECTION SHEET 8	SHEET 34 OF 78