


1846+00 ✓

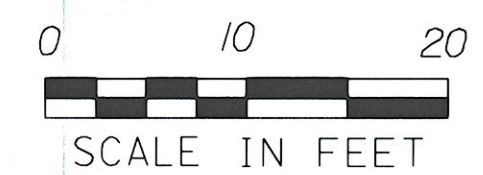

STA. 1846+00 TO STA. 1846+00

APL
2-8-11 *RCO*
3/16/11

PROJECT NAME: ROCKINGHAM	PLOT DATE: 26-MAY-2010
PROJECT NUMBER: IM 091-(57)	DRAWN BY: P. PELOQUIN
FILE NAME: 07a158/Design/d07a158xs.dgn	CHECKED BY: S. MENARD
PROJECT LEADER: K. ROBBIE	SHEET 36 OF 78
DESIGNED BY: P. PELOQUIN	CROSS SECTION SHEET 10