


1847+00 ✓

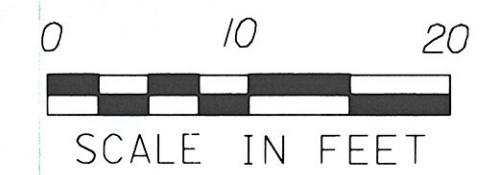

STA. 1847+00 TO STA. 1847+00

MP
2-8-11 *ROD*
3116111

PROJECT NAME: ROCKINGHAM	PLOT DATE: 26-MAY-2010
PROJECT NUMBER: IM 091-1(57)	DRAWN BY: P. PELOQUIN
FILE NAME: 07a158/Design/d07a158xs.dgn	CHECKED BY: S. MENARD
DESIGNED BY: P. PELOQUIN	SHEET 38 OF 78
CROSS SECTION SHEET 12	