


1847+50 ✓

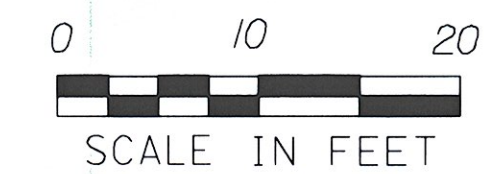

STA. 1847+50 TO STA. 1847+50

MRP
2-8-11 *RCD*
3/16/11

PROJECT NAME: ROCKINGHAM	PLOT DATE: 26-MAY-2010
PROJECT NUMBER: IM 091-I(57)	DRAWN BY: P. PELOQUIN
FILE NAME: 07a158/Design/d07a158xs.dgn	CHECKED BY: S. MENARD
DESIGNED BY: P. PELOQUIN	SHEET 39 OF 78
CROSS SECTION SHEET I3	