


1848+00 ✓

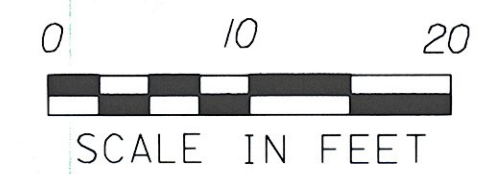

STA. 1848+00 TO STA. 1848+00

MRP
2-8-11

RCO
3/16/11

PROJECT NAME: ROCKINGHAM	PLOT DATE: 26-MAY-2010
PROJECT NUMBER: IM 091-1(57)	DRAWN BY: P. PELOQUIN
FILE NAME: 07a158/Design/d07a158xs.dgn	CHECKED BY: S. MENARD
PROJECT LEADER: K. ROBIE	SHEET 40 OF 78
DESIGNED BY: P. PELOQUIN	
CROSS SECTION SHEET 14	