


1849+50 ✓

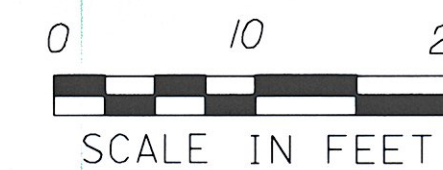

STA. 1849+50 TO STA. 1849+50

PLP
2-8-11 *RCD*
3/10/11

PROJECT NAME: ROCKINGHAM	
PROJECT NUMBER: IM 091-(57)	
FILE NAME: 07a158/Design/d07a158xs.dgn	PLOT DATE: 26-MAY-2010
PROJECT LEADER: K. ROBIE	DRAWN BY: P. PELOQUIN
DESIGNED BY: P. PELOQUIN	CHECKED BY: S. MENARD
CROSS SECTION SHEET 17	SHEET 43 OF 78