


1850+00 ✓

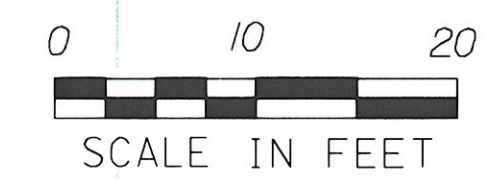

STA. 1850+00 TO STA. 1850+00

*RP*  
2-8-11 *RCD*  
3116111

PROJECT NAME: ROCKINGHAM	
PROJECT NUMBER: IM 091-(57)	
FILE NAME: 07a158/Design/d07a158xs.dgn	PLOT DATE: 26-MAY-2010
PROJECT LEADER: K. ROBIE	DRAWN BY: P. PELOQUIN
DESIGNED BY: P. PELOQUIN	CHECKED BY: S. MENARD
CROSS SECTION SHEET 18	SHEET 44 OF 78