


1851+00 ✓

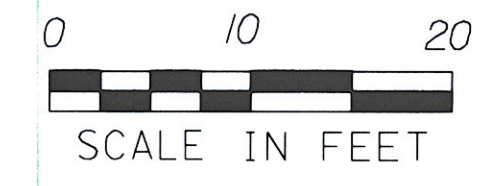

STA. 1851+00 TO STA. 1851+00

*ful* *RCD*  
*2-8-11* *3/16/11*

PROJECT NAME: ROCKINGHAM	
PROJECT NUMBER: IM 091-1(57)	
FILE NAME: 07a158/Design/d07a158xs.dgn	PLOT DATE: 26-MAY-2010
PROJECT LEADER: K. ROBIE	DRAWN BY: P. PELOQUIN
DESIGNED BY: P. PELOQUIN	CHECKED BY: S. MENARD
CROSS SECTION SHEET 20	SHEET 46 OF 78