


1851+50 ✓

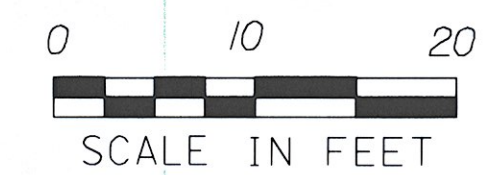

STA. 1851+50 TO STA. 1851+50

*1/1/11* *RCD*  
*2-8-11* *3/16/11*

PROJECT NAME: ROCKINGHAM	PLOT DATE: 26-MAY-2010
PROJECT NUMBER: IM 091-(57)	DRAWN BY: P. PELOQUIN
FILE NAME: 07a158/Design/d07a158xs.dgn	CHECKED BY: S. MENARD
PROJECT LEADER: K. ROBIE	SHEET 47 OF 78
DESIGNED BY: P. PELOQUIN	CROSS SECTION SHEET 21