


1852+50 ✓

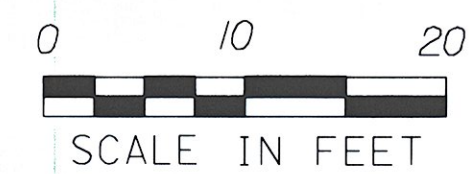

STA. 1852+50 TO STA. 1852+50

AP
2-8-11 *RCD*
8/16/11

PROJECT NAME: ROCKINGHAM	PLOT DATE: 26-MAY-2010
PROJECT NUMBER: IM 091-I(57)	DRAWN BY: P. PELOQUIN
FILE NAME: 07a158/Design/d07a158xs.dgn	CHECKED BY: S. MENARD
PROJECT LEADER: K. ROBIE	SHEET 49 OF 78
DESIGNED BY: P. PELOQUIN	CROSS SECTION SHEET 23